


Drilling & Blasting of Solid Rock Subgrade
 Item 115
 S.B. 1455+00-1463+20
 N.B. 1458+00-1467+25

Property Line Fence With Steel Posts Mod., Item 583-II
 S.B. 1455+00 Lt. - 1470+00 Lt.
 N.B. 1458+00 Rt. - 1472+00 Rt.

NOTE: PROPERTY LINE FENCE TO BE ERRECTED
 PRIOR TO CONSTRUCTION
 S.B. 1455+00 - 1470+00 Lt
 N.B. 1458+00 - 1472+00 Rt

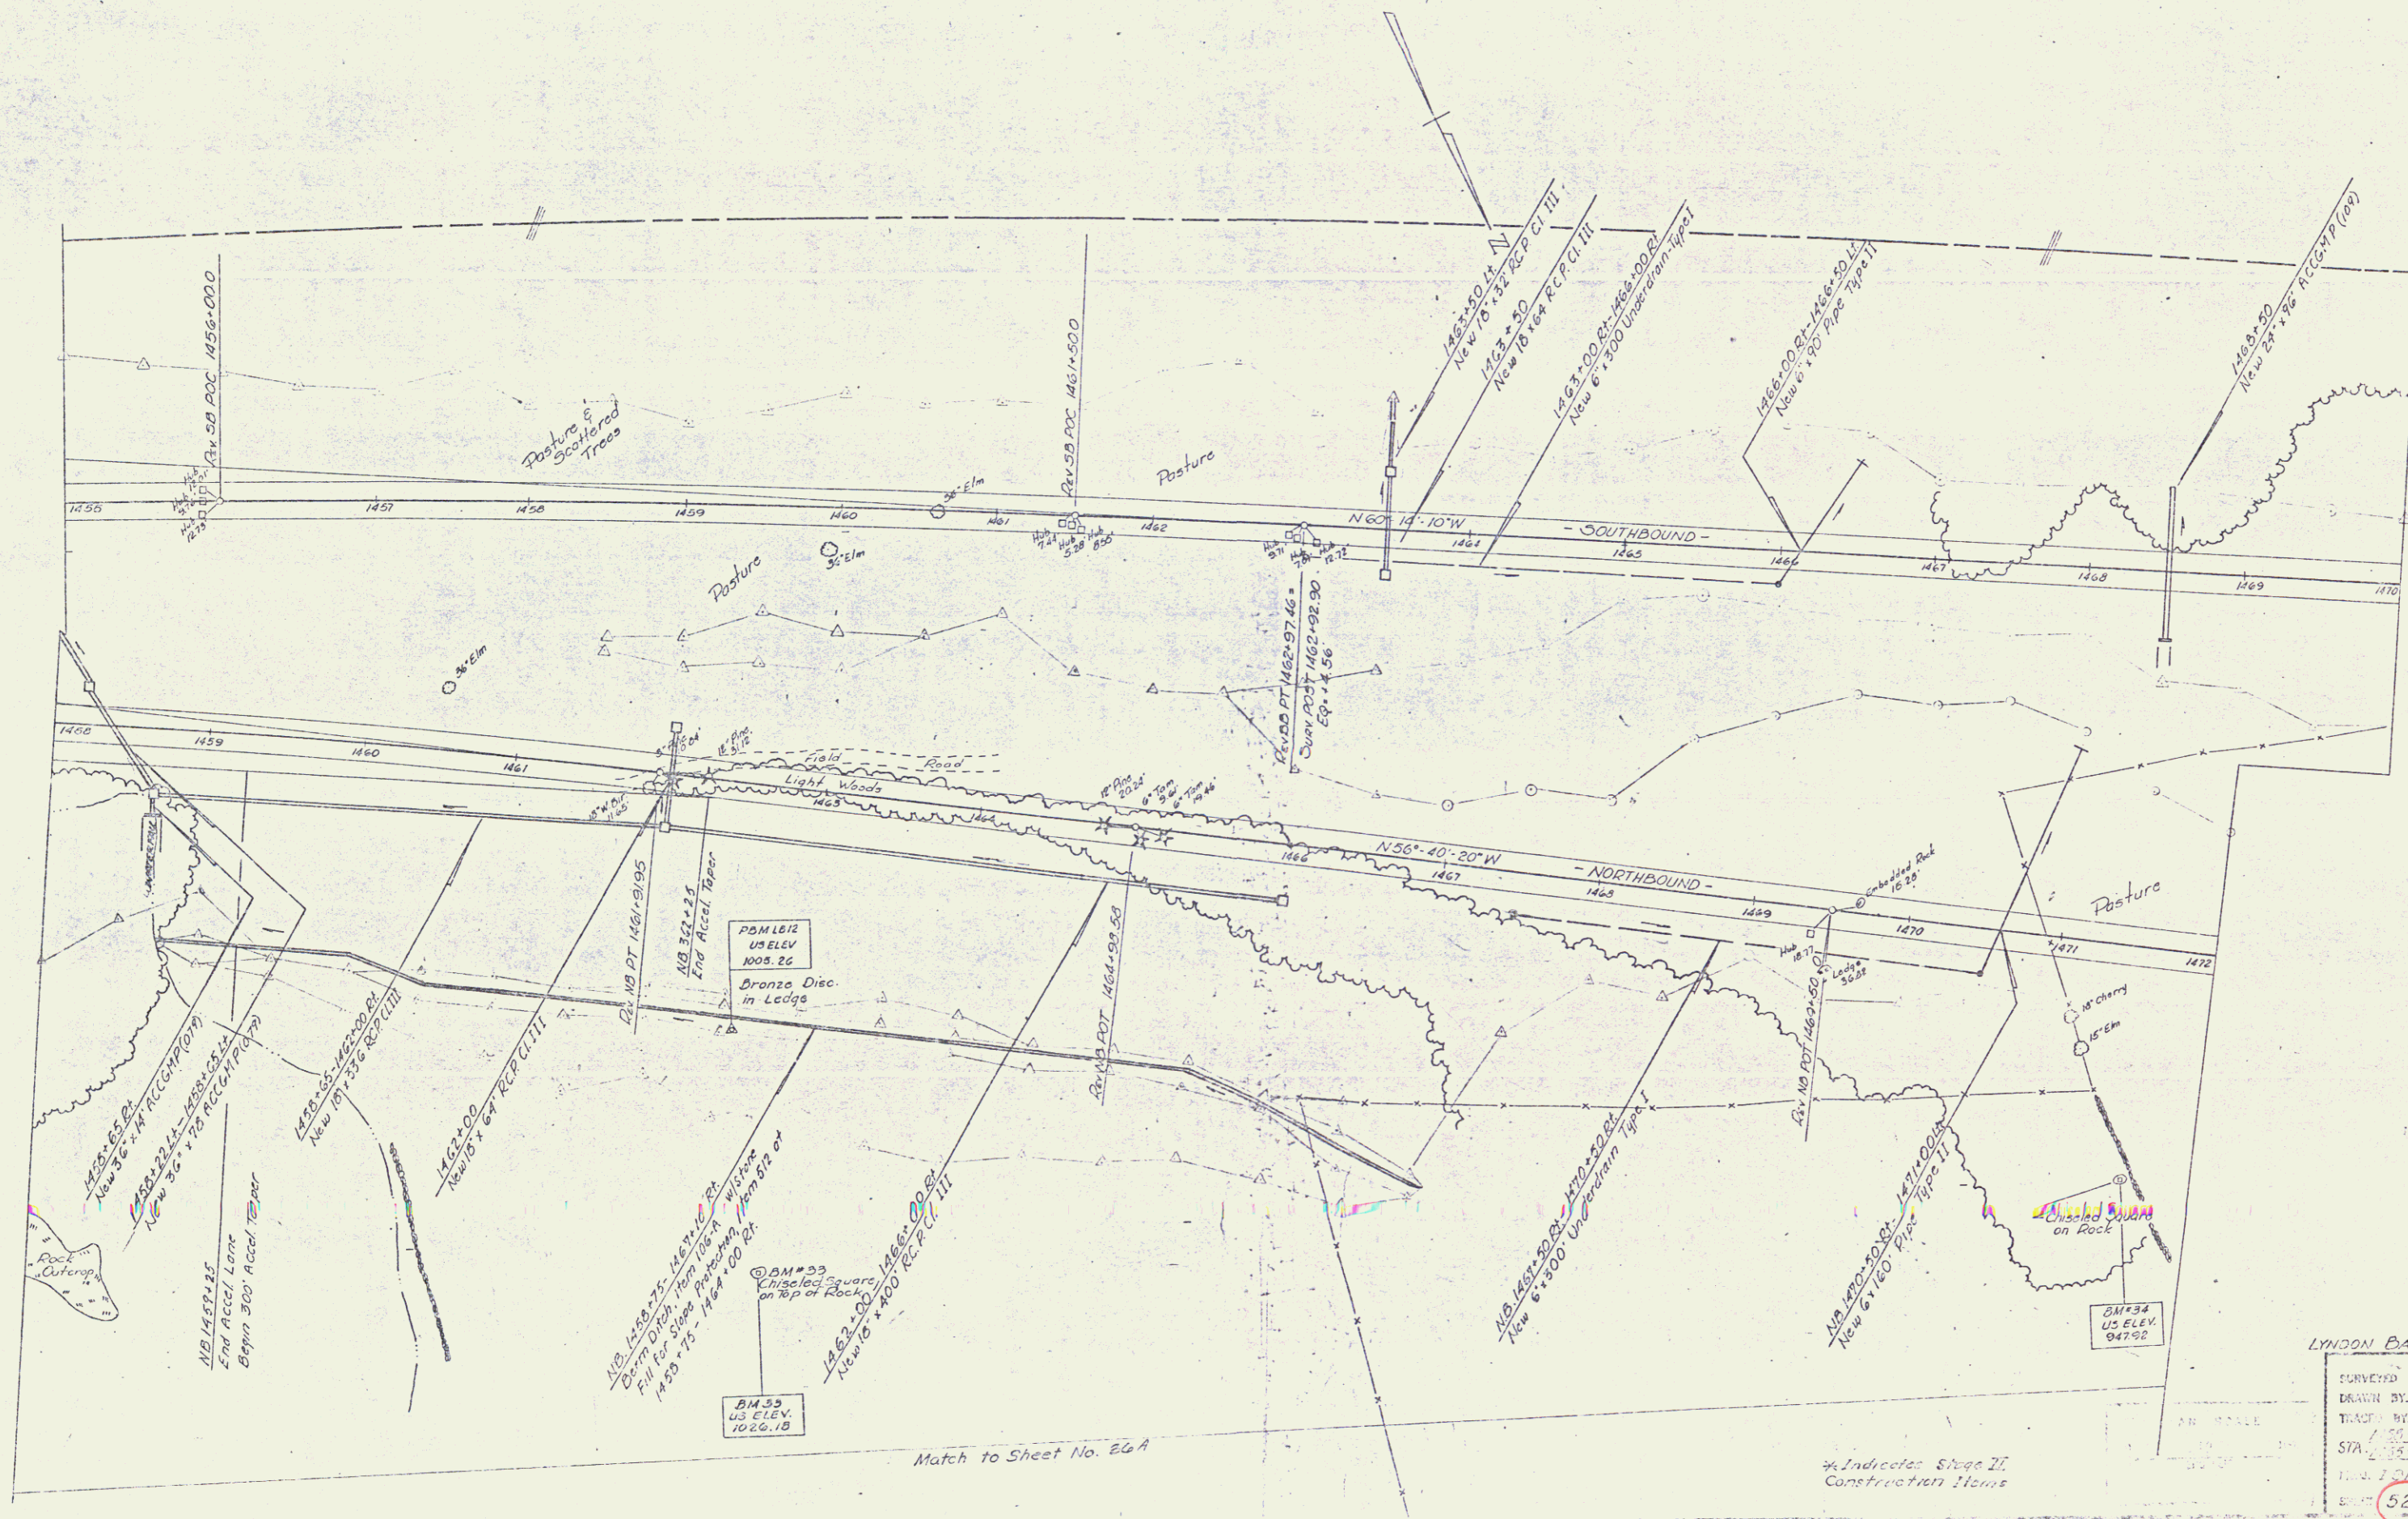

STAGE I CONSTRUCTION
 LYNDON BARTON - CONTR. 2

SURVEYED BY	SMITH	DATE	02-70
DRAWN BY	KERR	DATE	09-70
TRACED BY	KERR	DATE	10-70
STA.	1455+00 TO STA. 1470+00 S.B.	DATE	11-70
NO.	5114		
52A	155		