


Muck Excavation From IIF  
 NB 1474+00 - 1476+50  
 NB 1483+00 - 1485+00

Property Line Fence With Steel Posts Mod. Item 563-II  
 SB 1470+00 Lt. - 1483+00 Lt.  
 NB 1472+00 RA - 1485+00 Rt.

Note: Property Line Fence to Be Erected  
 Prior to Construction  
 NB 1472+00 - 1485+54 Rt  
 SB 1476+00 - 1481+33 Lt

Drilling and Blasting of Solid  
 Rock Saker + etc - Item 115  
 NB 1479+75 - 1482+25

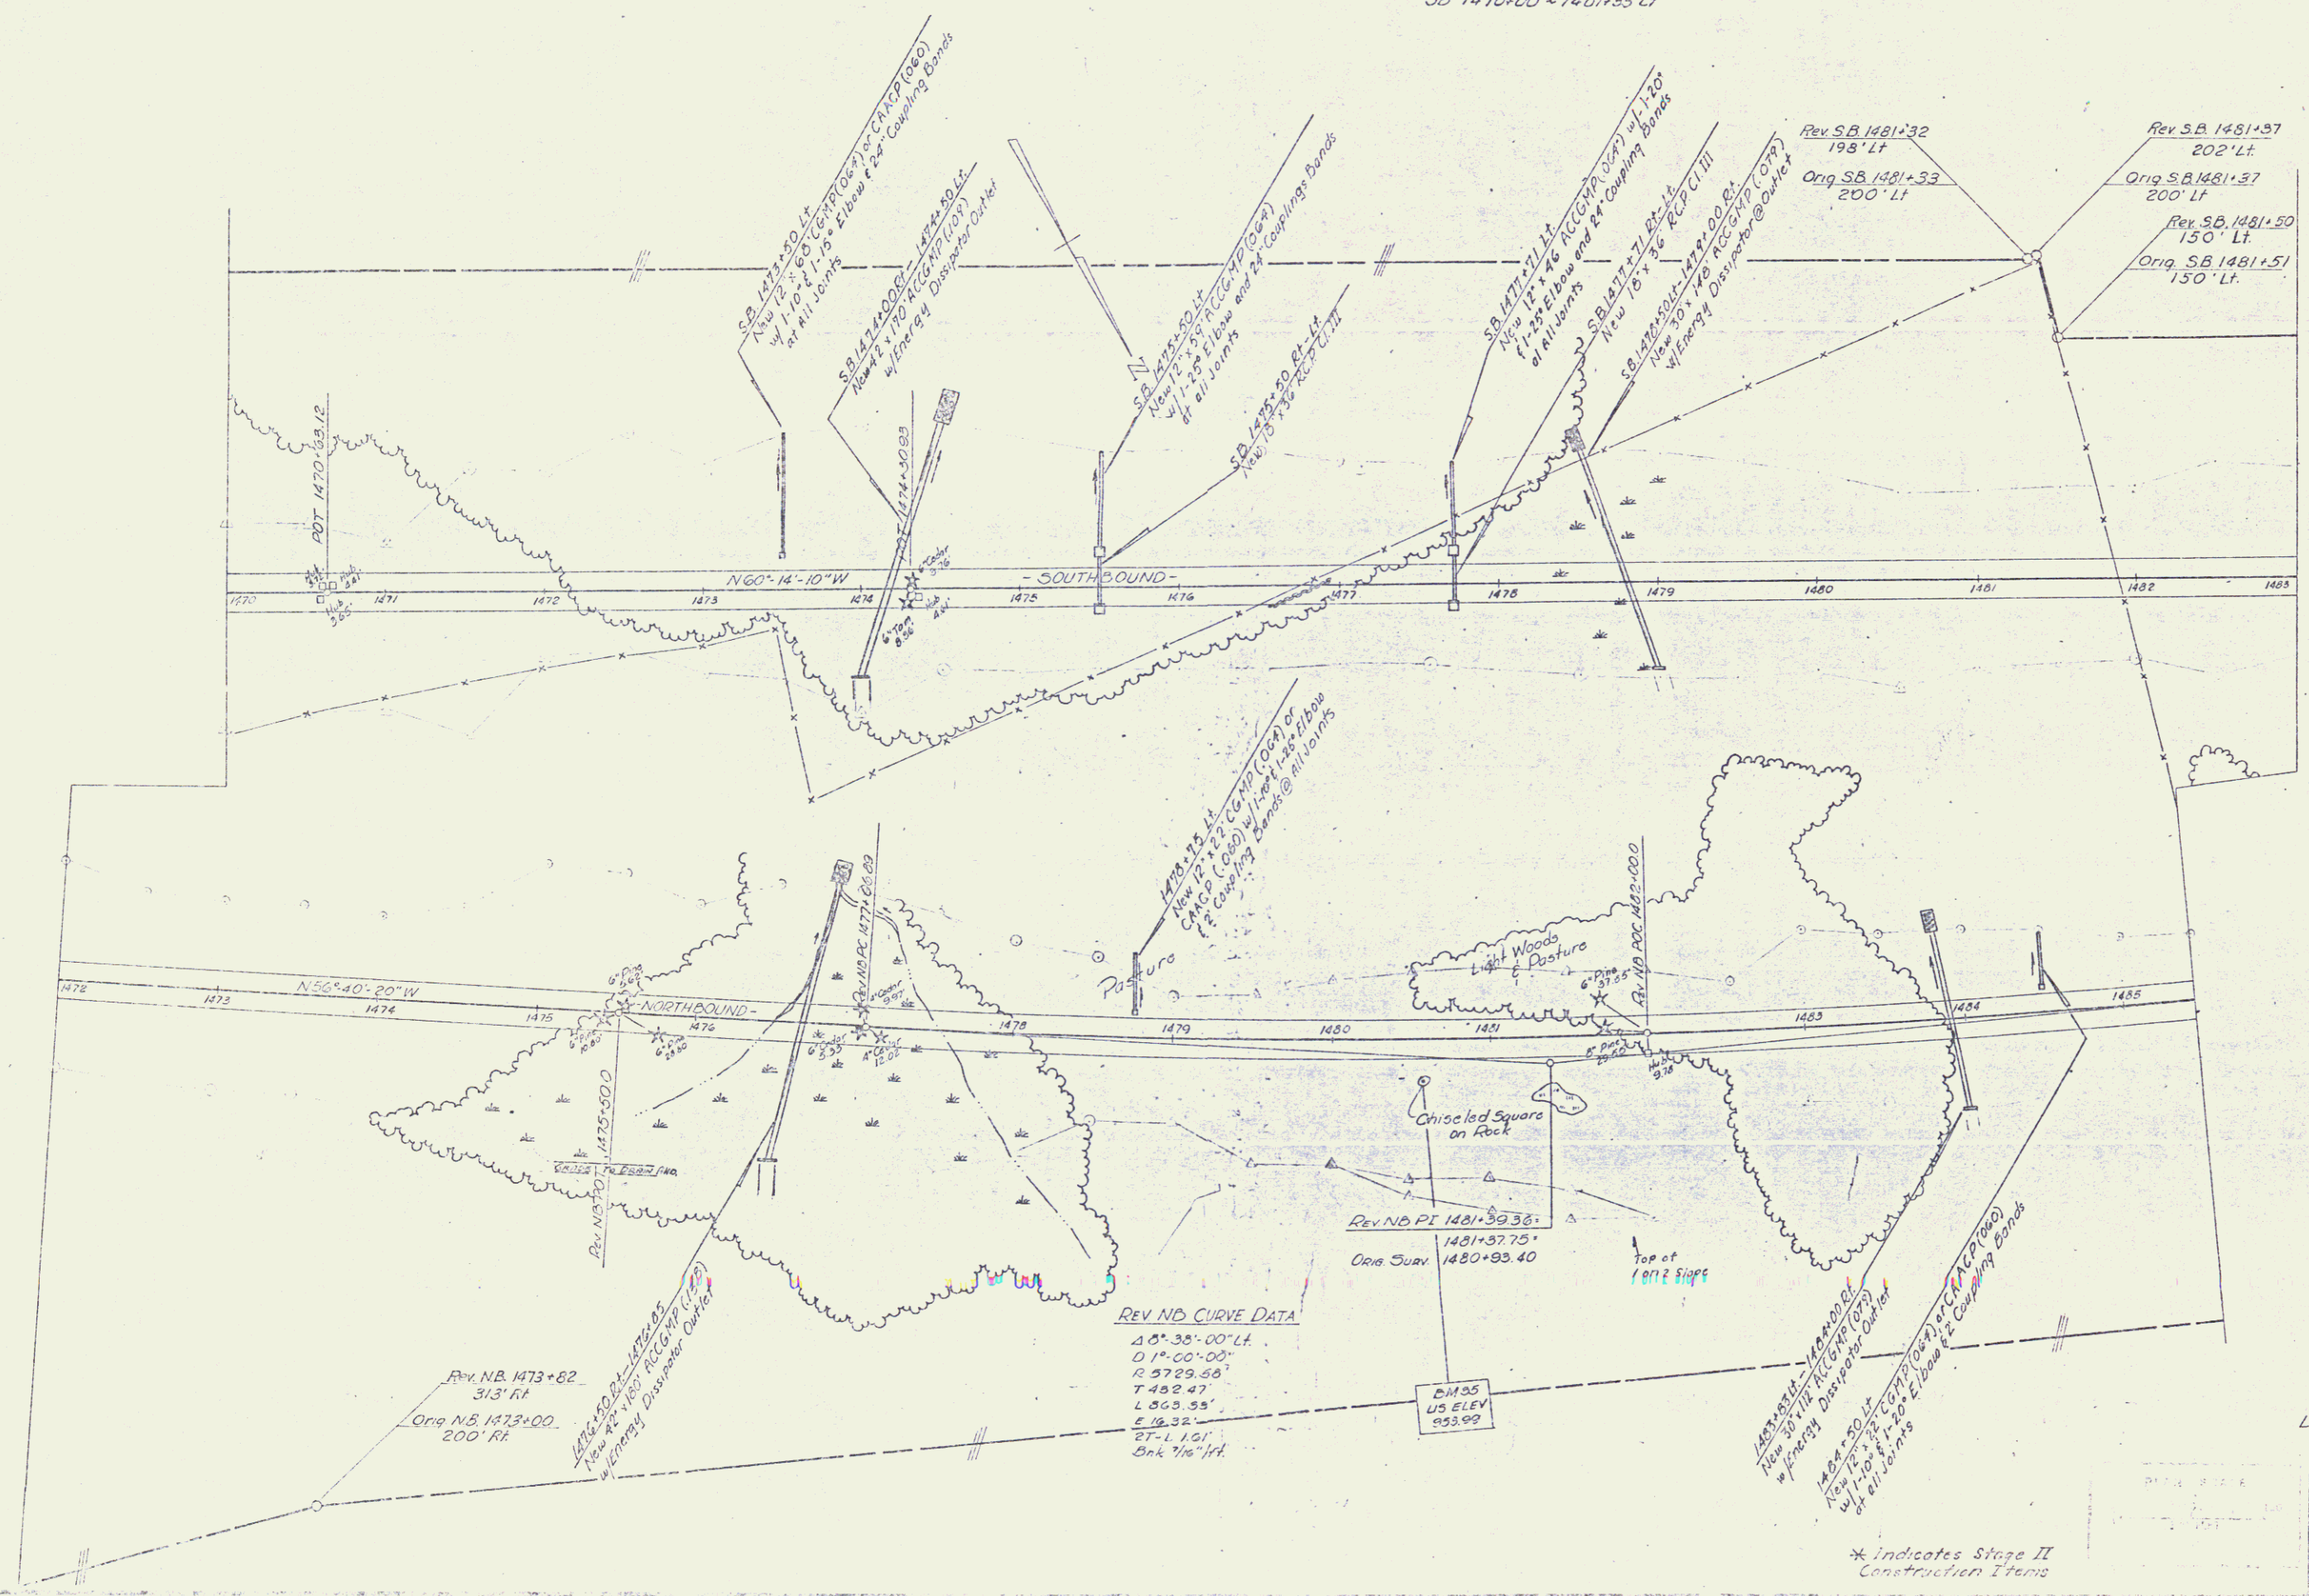

REV NO CURVE DATA

40° 38' 00" Lt.
0° 00' 00" Lt.
R 9729.56'
T 482.47'
L 965.55'
E 16.32'
RT-L 1.01'
Bk 7/16" Ft.

STAGE I CONSTRUCTION  
 LYNDON PARTON - CONT 2

SURVEYED BY	SMITH	DATE	9-70
DRAWN BY	KEPP	DATE	9-70
TRACKED BY	KEPP	DATE	10-70
STA.	1472+00 TO STA. 1485+54	REVISED BY	SMITH
FIGURE NO.	201	NO.	5(14)
REV.	5, A	NO.	155