

Drilling + Blasting of Solid Rock Subgrade.
 Item 115
 SB 1774+00 - 1783+00
 NB 1774+00 - 1783+00

END CONTRACT 3
 SB 1779+00

BEGIN CONTRACT 4
 SB 1779+00

54

55-A

52-B

CONTROL OF ACCESS COMPLETE ON THIS SHEET

CONTRACT NO. 3
 STAGE 1 CONSTRUCTION


TOWNS OF LYNDON BARLON

PROJECT I-91-3 (14)
 SECT I

STA. 1768+00 NB TO STA. 1779+00 NB
 1768+00 SB

Sheet No. 73 of 155 Sheets

8 AUGUST 1988
 GLENN W. VERNON

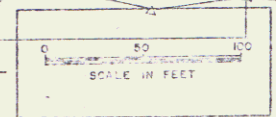

62