


POOR ORIGINAL COPY

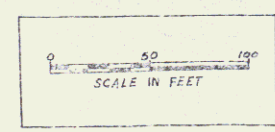

TOWNS OF LYNDON-BARTON  
 PROJECT J-91-3(14)  
 SEC. 1  
 STA. 1779+00 TO STA. 1783+00  
 1779+00 SB 1783+00 SB  
 Sheet No. 74 of 155 Sheets  
 BLAUEVELL ENGINEERING CO. ORLEANS, VERMONT

63