



Stone Fill for Slope Protection (Light Type) Item 512  
 SB 1875+50 - 1876+50 RT Special Ditch  
 SB 1878+50 - 1900+00 RT Special Ditch  
 NB 1874+50 - 1900+00 RT 2' High

Stone Fill Energy Dissipator (Heavy Type) Item 511  
 SB 1898+50 RT

Property Line Fence with Steel Posts (6x6) Item 583-II  
 SB 1887+00 - 1900+00 LT  
 NB 1870+00 - 1905+00 RT

Thin Cable Guard Rail w/light  
 Steel Posts Item 532  
 SB 1885+00 - SB 1897+76 LT  
 SB 1878+00 - SB 1899+76 RT

RT (Heavy Type) Item 513  
 SB 1885+00  
 SB 1895+00 RT

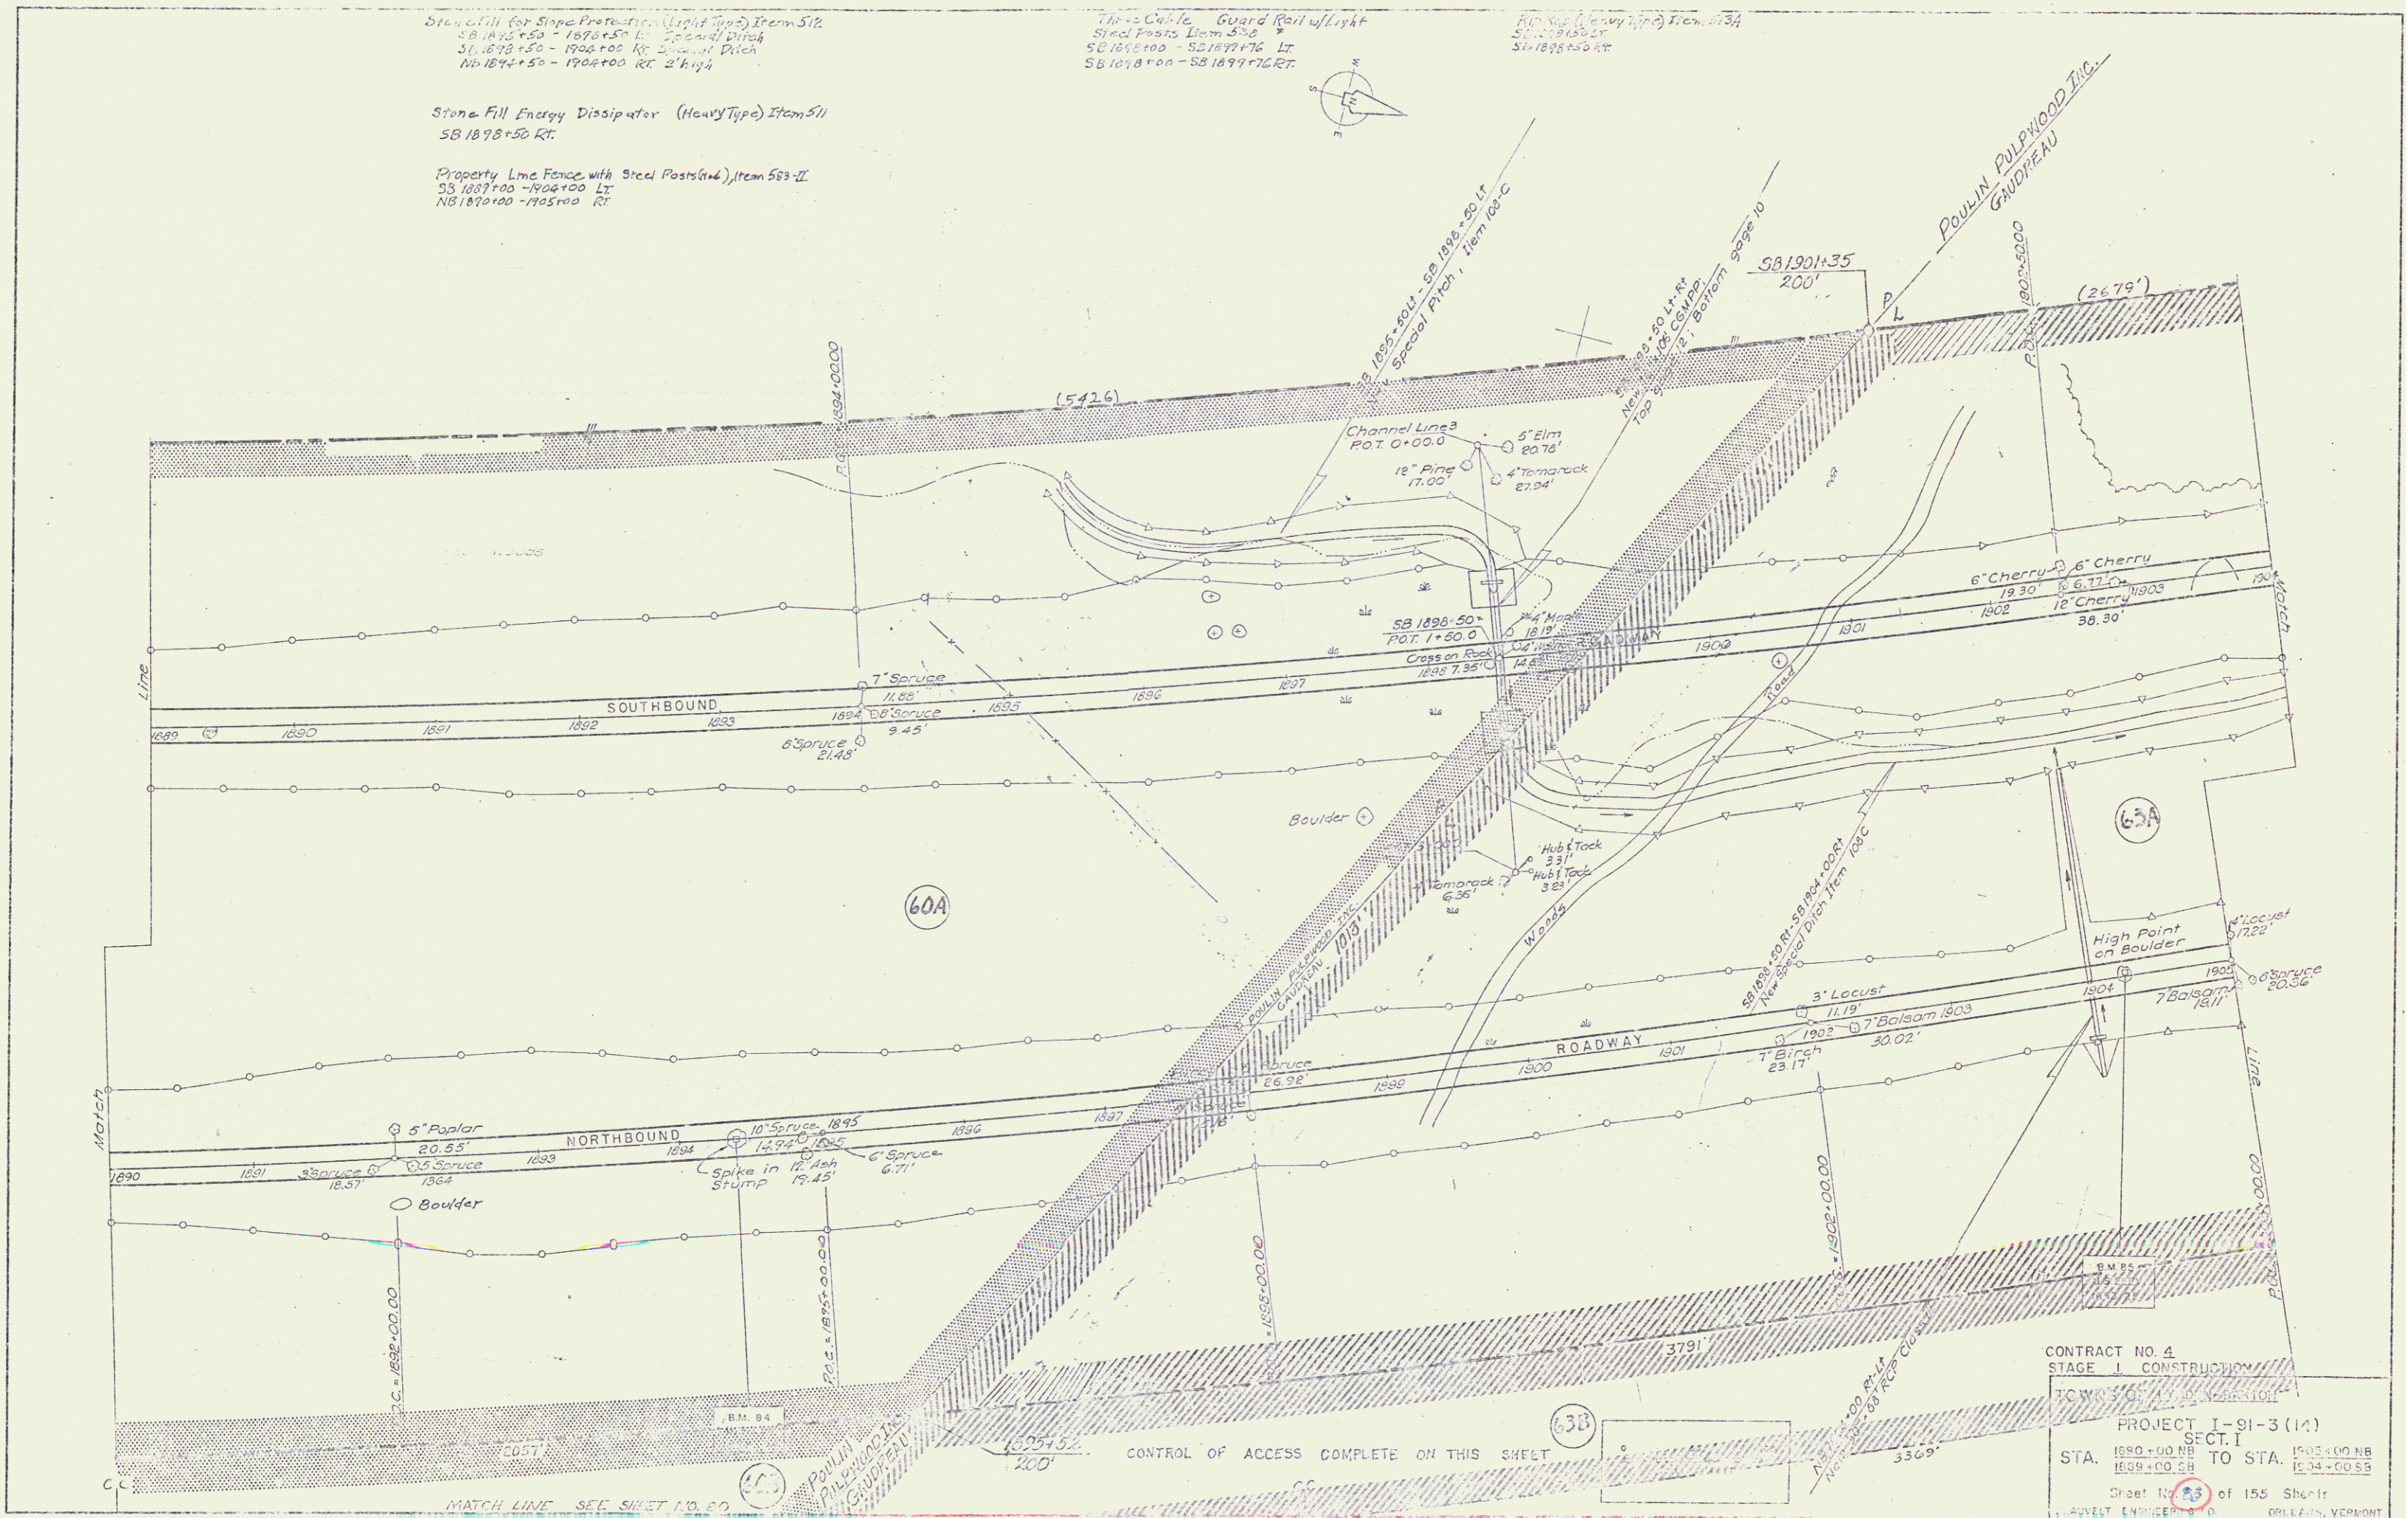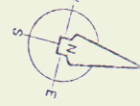

CONTRACT NO. 4  
 STAGE I CONSTRUCTION  
 PROJECT I-91-3 (14)  
 SECT. I  
 STA. 1880+00 NB TO STA. 1905+00 NB  
 1889+00 SB TO STA. 1904+00 SB  
 Sheet No. 33 of 155 Sheets  
 DRILLING VERMONT