

Treated Timber Curb  
Item 538\*

NB 1983+00 - 1987+60 Lt.  
SB 1982+00 - 1983+50 Lt.  
NB 1991+50 - 1994+00 Lt.

Property Line Fence with Steel Posts (Mod.), Item 583 II

SB 1982+00 - 1997+00 Lt.  
NB 1983+00 - 1996+00 Rt.

Stone Fill for Slope Protection (Light Type) Item 512


SB 1986+50 - 1989+00 Lt. - 2' High  
SB 1993+00 - 1994+50 Lt. - 2' High  
NB 1986+50 - 1987+50 Lt. - 2' High  
SB 1985+00 Rt. 15' x 7'  
SB 1988+00 Rt. 10' x 4'  
SB 1994+35 - 1996+00 Lt. Berm

Three Cable Guard Rail with Light Steel Posts, Item 536\*

NB 1990+98 - 1994+50 Lt.  
NB 1983+00 - 1987+90 Lt.  
NB 1985+02 - 1983+02 Rt.  
SB 1982+00 - 1984+06 Lt.  
SB 1982+00 - 1990+50 Rt.

Drilling & Blasting of Solid Rock Subgrade  
Item 115

SB 1997+75 - 1998+00

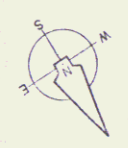

CONTRACT NO. 5  
STAGE I CONSTRUCTION

TOWNS OF LYNDON - BARTON

PROJECT 1-91-3 (14)  
SECT II

STA. 1983+00 NB TO STA. 1992+00 NB  
1982+00 SB

Sheet No. 8 of 34 Sheets

BLAUVELT ENGINEERING CO. GLENVIEW, ILLINOIS

Sheet No. 8

CONTROL OF ACCESS COMPLETE ON THIS SHEET

\* Danah's Stage II Construction

