



Demolition & Disposal of Buildings  
Item 586  
NB 2002+30 106' RT.

Drilling & Blasting for Solid Rock Subgrade, Item 115  
SB 2010+75 - 2011+00  
SB 1997+00 - 2006+25  
NB 1999+50 - 2012+00

Property Line Fence with Steel Posts (Mod) Item 583 II  
SB 1997+00 - 2011+00 Lt.  
NB 1999+00 - 2013+00 Rt.

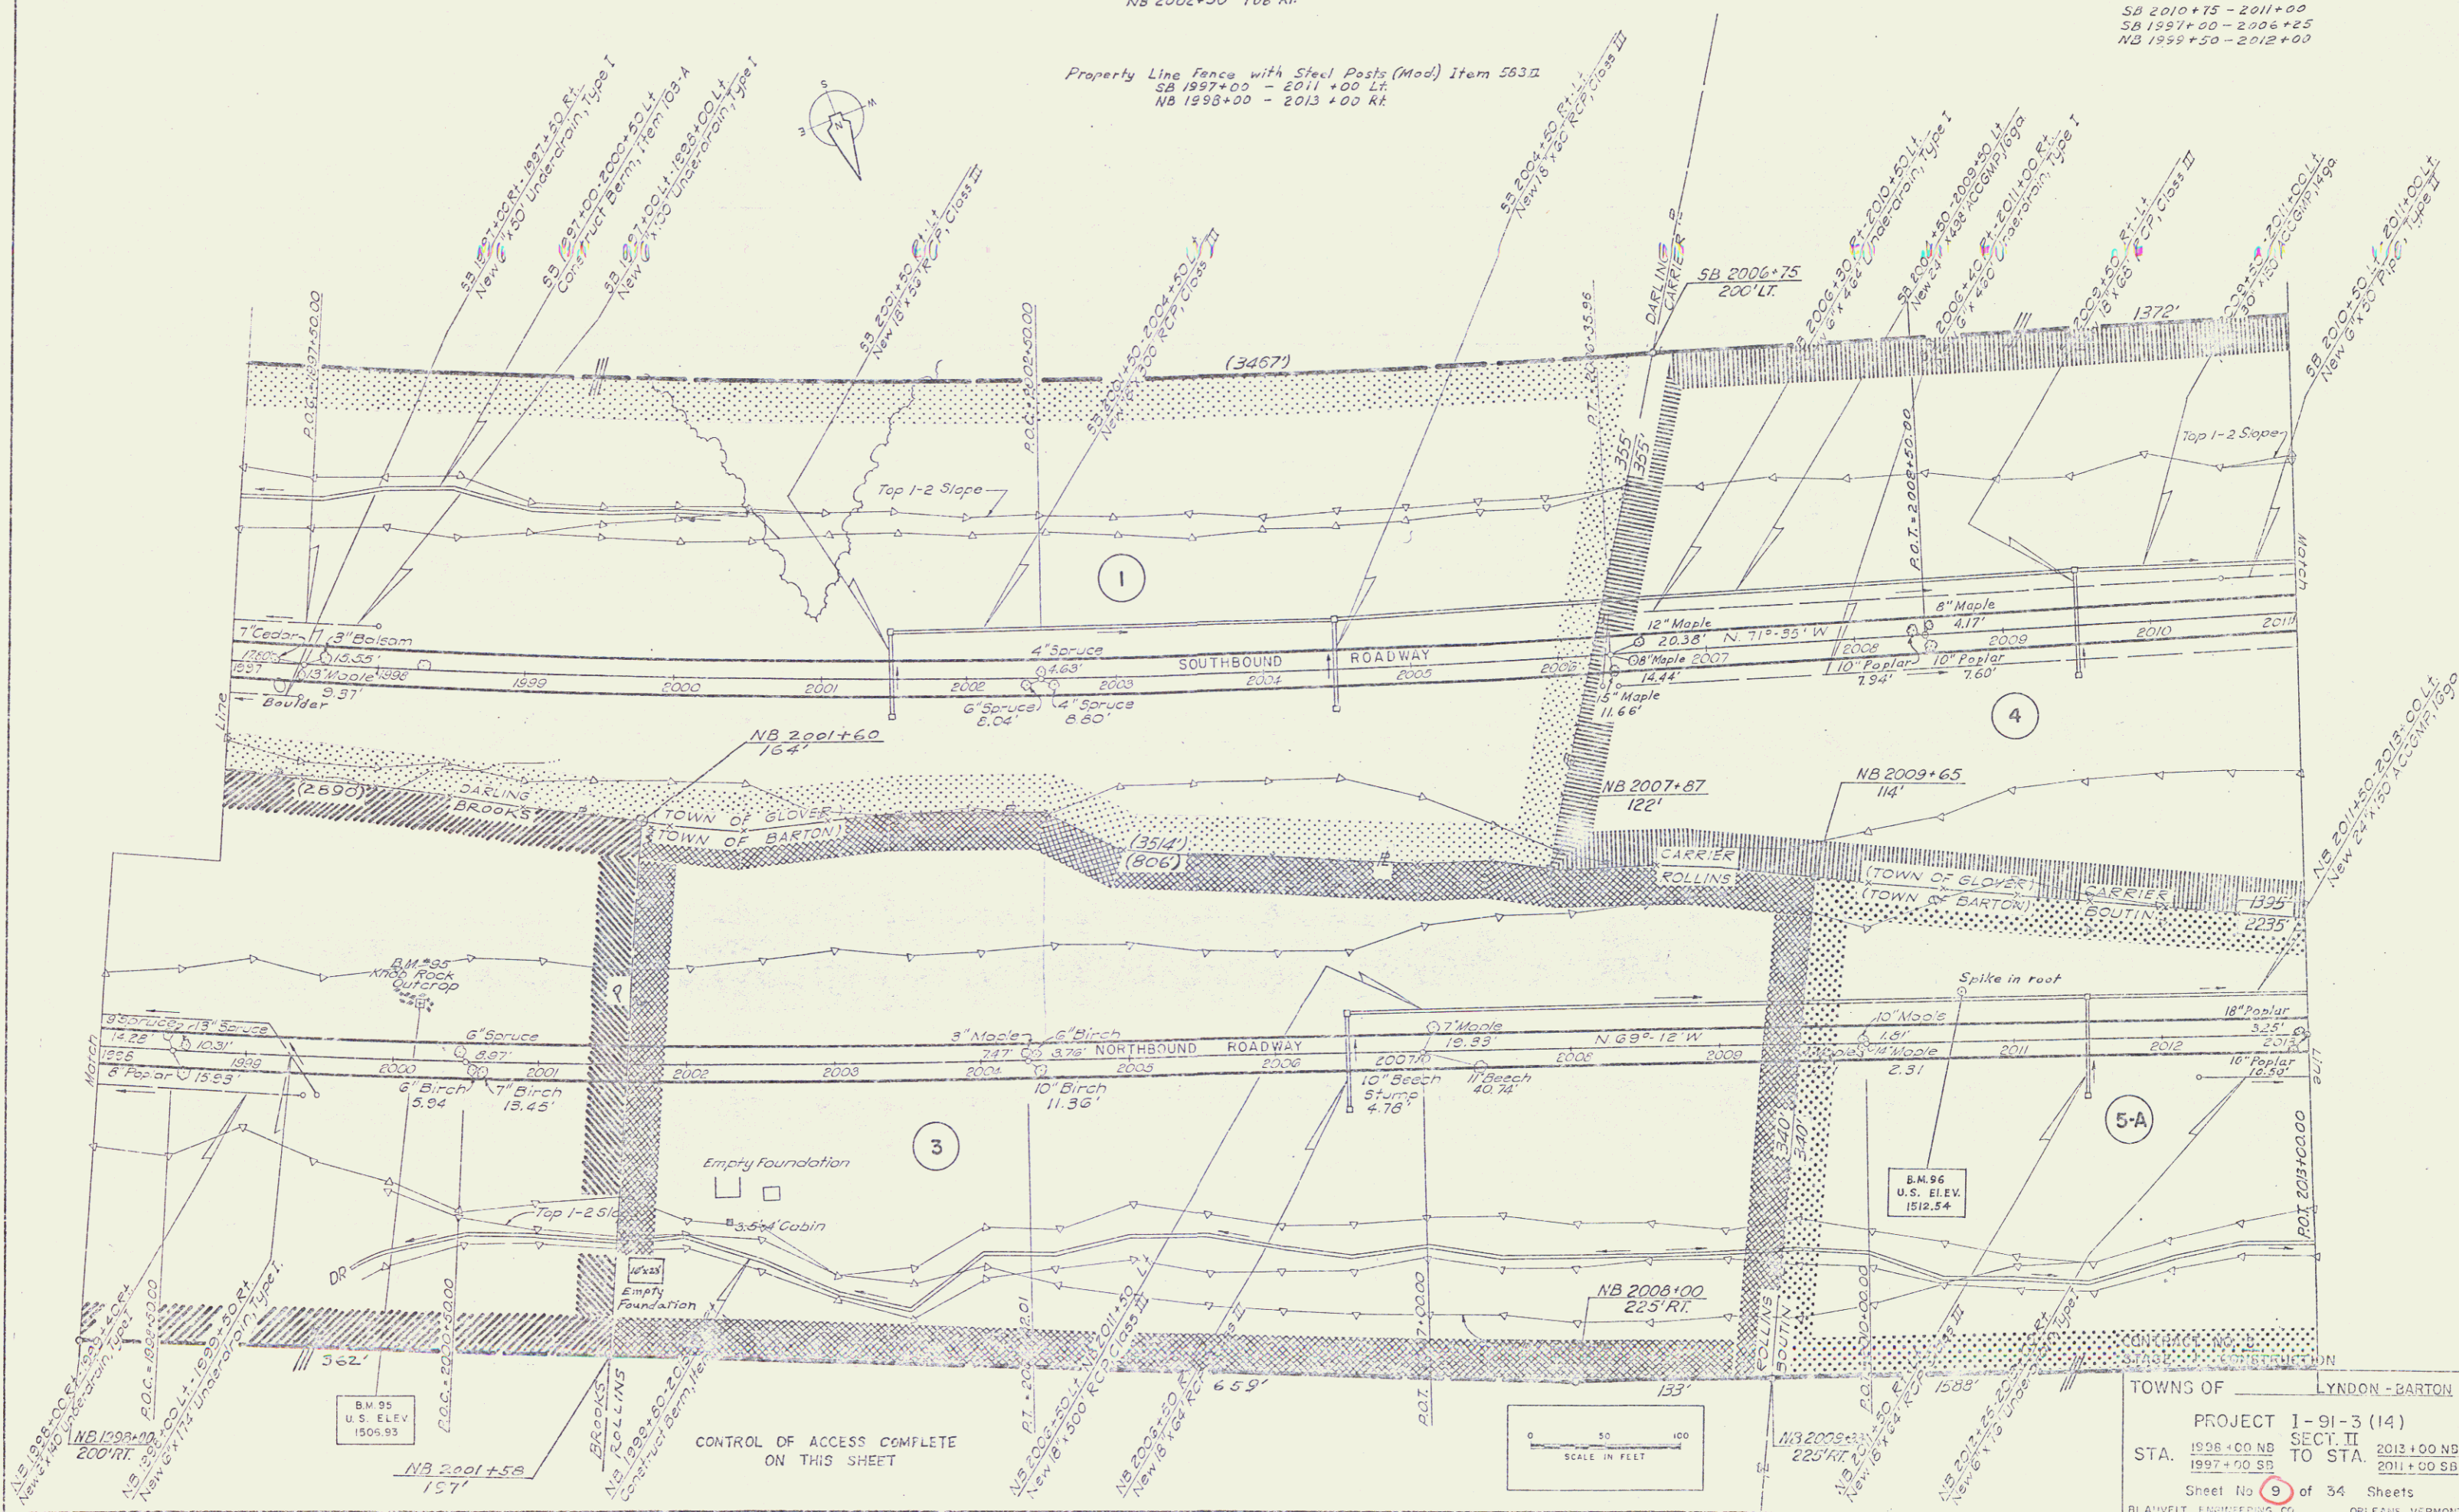

CONTROL OF ACCESS COMPLETE  
ON THIS SHEET

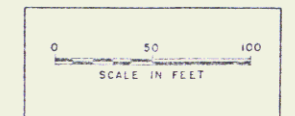

TOWNS OF LYNDON - BARTON  
PROJECT I - 91 - 3 (14)  
SECT. II  
STA. 1996+00 NB TO STA. 2013+00 NB  
1997+00 SB TO STA. 2011+00 SB  
Sheet No. 9 of 34 Sheets  
BLAUVELT ENGINEERING CO. OPLETNS, VERMONT