

Drilling & Blasting of Solid Rock Subgrade, Item 115
 SB 2025+00 - 2025+25

"53"
 $\Delta = 43^{\circ}02'52''$ Et
 $DC = 10^{\circ}30'00''$
 $TXC = 3819.72'$
 $T = 1506.47'$
 $LC = 2869.86'$
 $E = 286.54'$
 $Bnk = 1/2''/ft.$

Jute Matting, Item 423*
 SB 2031+00 - 2033+00 Lt.
 SB 2034+00 - 2038+50 Lt.
 SB 2036+00 - 2038+50 Rt.
 SB 2039+50 - 2040+00 Lt.
 SB 2039+50 - 2040+00 Rt.


Three Cable Guard Rail with
 Light Steel Posts, Item 535*
 SB 2033+20 - 2034+96 Rt.
 SB 2033+20 - 2034+96 Lt.

Stone Fill for Slope Protection
 (Light Type), Item 512
 SB 2033+50 Rt - Special Ditch
 SB 2033+50 Lt. 10'x6'

Property Line Fence with Steel Posts (Hod), Item 5831
 SB 2025+00 - 2040+00 Lt.

CONTROL OF ACCESS COMPLETE ON THIS SHEET

| | |
|---------------------------|-------------------|
| CONTRACT NO. 5 | |
| STAGE I CONSTRUCTION | |
| TOWNS OF LYNDON BARTON | |
| PROJECT I-91-3 (14) | SECT. II |
| STA. 2028+05.5 | TO STA. 2030+05.5 |
| Sheet No. 11 of 34 Sheets | |
| FLAWELT ENGINEERING CO. | ORLEANS, VERMONT |

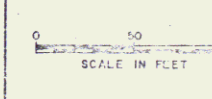

* Denotes Stage II Construction