

STATE OF VERMONT
DEPARTMENT OF HIGHWAYS
RIGHT-OF-WAY PLANS
DETAIL SHEET
OF


TABLE OF PROJECT PROPERTY ACQUISITION

PARCEL NO.	GRANTOR	SHEET NO.	BEGINNING STATION	ENDING STATION	TAKING	REM.	RIGHTS	TITLE TAKEN	DATE	TOWN OR CITY RECORDED	BK.	PG.	REMARKS	
1	DUCARME, GERARD E. & ANGELE (H&W)	21-24	2085+26 NB	2123+14 SB	27.9A	971A								
		21-24	2085+26 NB	2122+16 NB										LOSS OF ACCESS (53.0A)
		21	2093+50 SB					DRAINAGE (P)						
		21	2097+00 SB					DRAINAGE (P)						
		21	2098+30 SB					DRAINAGE (P)						
		22	2102+00 SB					DRAINAGE (P)						
		23	2118+00 SB				DRAINAGE (P)							
		23	2120+00 SB					DRAINAGE (P)						
		24	2122+50 SB					DRAINAGE (P)						
2	AUGER, JEAN CLAUDE & JEANETTE F (H&W)	24	2122+50 NB				SPRING (P)							
3	LEBOUX, CLOVIS & IRENE (H&W)	24	2122+50 NB				SPRING (P)							
4A	SIMONS, OLIN G & MARION E. (H&W)	24-25	2122+16 NB	106+50 SB	40.0A	213.25A							SUGAR HO. & 2 SPRINGS	
		24	2125+00 SB					DRAINAGE (P)						
		24	2128+00 SB					DRAINAGE (P)						
		24	2130+00 SB					DRAINAGE (P)						
		25	2138+50 SB					DRAINAGE (P)						
25, 27	104+00 SB	106+00 SB				Slope (4:100) (T)								
B		25	6+94 SB	95+61 SB	0.8 A									

TABLE OF REVISIONS

REVISION NO.	SHEET NO.	DESCRIPTION OF REVISION	DATE	MADE BY	APPROVED BY
1	51	Parcel # 33 Change of ownership per Change Order # 789	1-26-67	NLD	JL
2	45, 46	Parcel # 43 Change of Title per Change Order # 790	1-26-67	NLD	JL
3	26	Delete Parcel # 5 per Change Order No. 812 and add to Parcel # 7c	8-18-67	NLD	JL
4	12	Parcel No 13, Change of 7/4 Def N Reduce remainder 3.815, per Change Order No. 818	8-22-67	JL	JL
5	47	Parcel # 35 Reduce Remainder from 12.7 A to 8.7 A because of Sale of remaining Property per Change Order # 816.	10-27-67	M.A.R.	JL
6		Parcel # 39 area of lake removed by 3.88 A per CO # 830	11-14-67	LWB	JL
7	40	New parcel # 44 added to plans per C.O. # 857	11-14-67	LWB	JL
8		Parcel # 11 Change total area to 142.8 A per CO # 863	11-15-67	LWB	JL
9	45	New parcel # 45 built added to plans per CO # 891	11-15-67	LWB	JL
10	44	New parcel # 46 built added to plans per CO # 892	11-15-67	LWB	JL
11		Parcel # 17 Total Acreage Changed to 342.2 Acres. Remainder Changed to 327.7 Acres. Per Change Order # 894	11-22-67	JAB	JL
12		Parcel # 27 Total Acreage Changed from 140.8 to 330.8. Due to Addition of Roberts Farm - 190.8. Per Change Order # 891	11-22-67	JAB	JL
13	33, 34	Changed Property Lines on Parcels 17 and 20 as per Change Order # 911	12-11-67	T.A.M.	JL
14		Parcel 14 Change in title per Change Order 967	1-24-68	M.M.M.	T.C.B.
15	31	PARCEL # 6 ADDED WIFE'S NAME TO PLANS PER CHANGE ORDER # 1024	3-13-68	B.L.A.	JL

NO. 25 DATE 2-23-66
CHECKED BY: [Signature] DATE 1-9-68

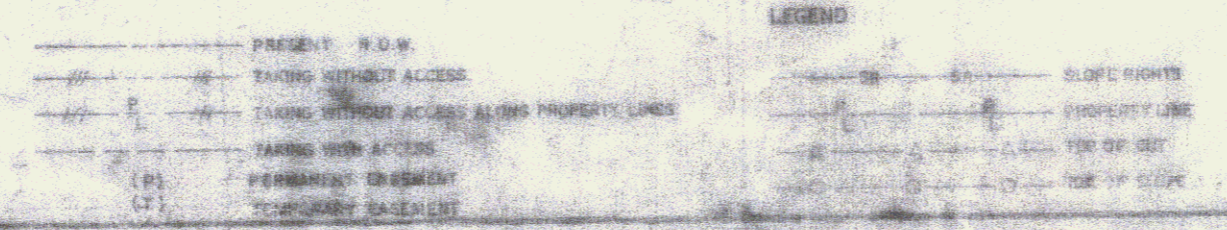

APPROVED: [Signature] DATE 2-23-66
PROJECT: BARTON - 1949
NO. T9-3(15)
SHEET 9