

Plan, Backfill for Slope
Substation, Item 200
N.B. 218+00-218+100.00

Sub-base of Road, Item 200
N.B. 218+00-218+75

* Three Deep Guard Rail
with 12" Posts, Item 200
S.B. 218+00-218+100.00
N.B. 218+00-218+00.00


* Aluminum Concrete Curb
Item 200
S.B. 218+00-218+100.00
N.B. 218+00-218+00.00

Property Line Fence
with Stone Posts, Item 200
S.B. 218+00-218+100.00
N.B. 218+00-218+00.00

* STAGE 2 CONSTRUCTION



N.B. STA 218+00.00
END PROJECT BEGIN PROJECT
I 91-3(10) I 91-3(11)

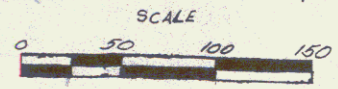

VERMONT DEPARTMENT OF HIGHWAYS
RIGHT-OF-WAY PLANS
PROJECT BARTON-IRASBURG
NO I 91-3(15)
SHEET 23 Of 88