


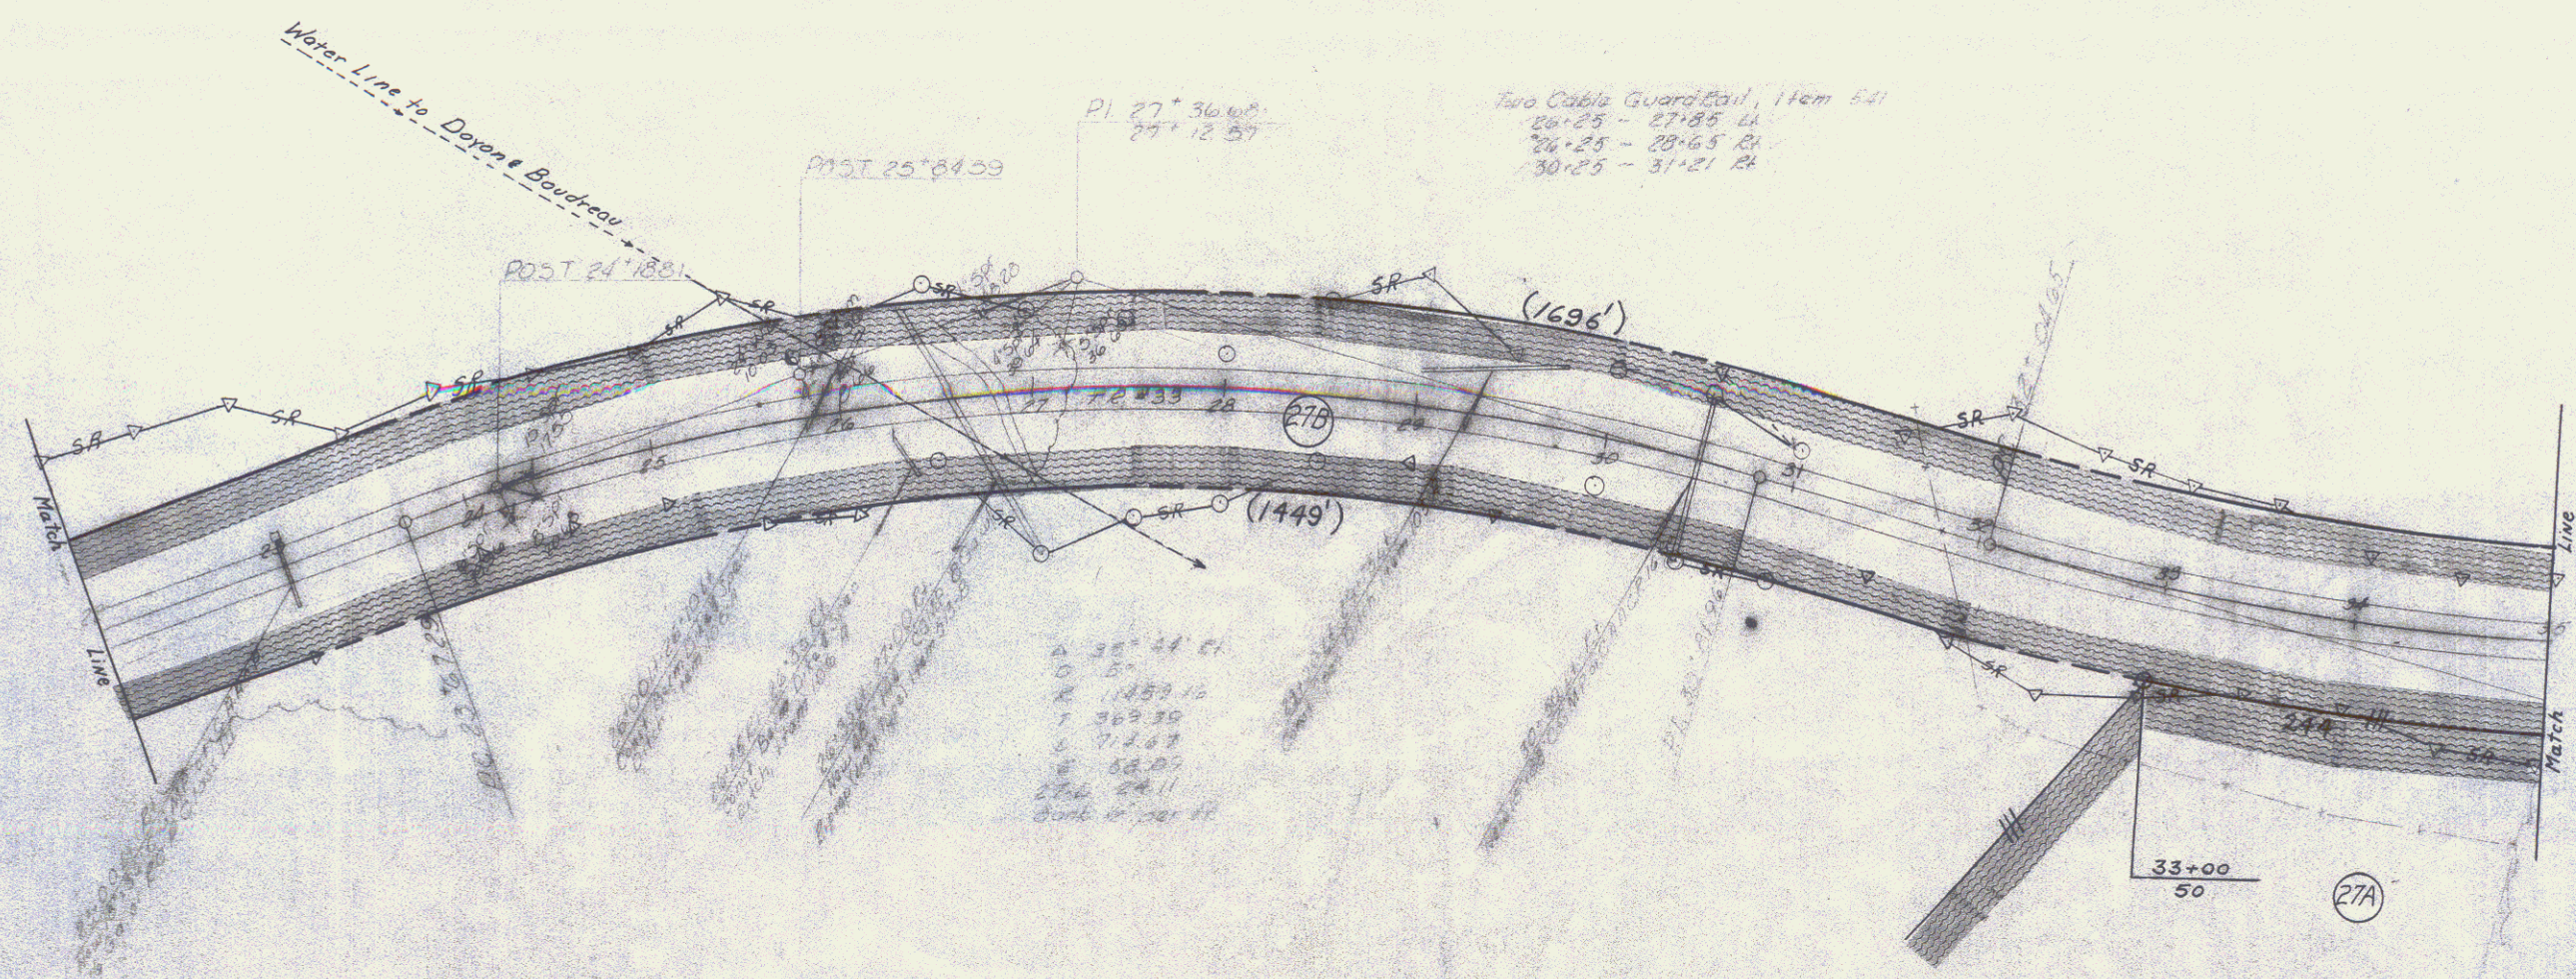

VERMONT DEPARTMENT OF HIGHWAYS
RIGHT-OF-WAY PLANS
BARTON-IRASBURG
I 91-3(15)
42 88