
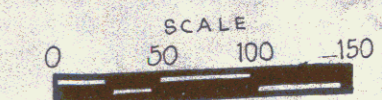


Type of Instr. Agreement Date Town Book & Page
 Agreement Jan 23, 1975 Barton 59/180-82

End Relinquishment No. IV
 49+17 E (4167')

CONSTRUCT DRIVE
 AT STATION 23+50 Lt.

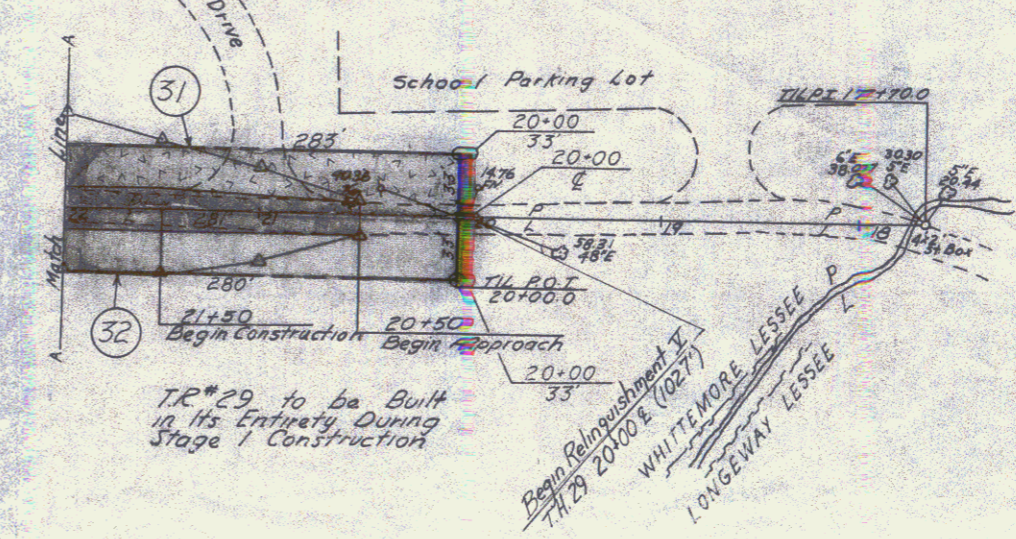

VERMONT DEPARTMENT OF HIGHWAYS
RIGHT-OF-WAY PLANS
 BARTON - TRASBURG
 I 91-3(15)
 SHEET **44** OF 88