


7. Triple Cable Guard Rail
 S.B. 2423400 - 2423460 LF
 N.B. 2423100 - 2423116 LF

Bituminous Concrete Curbs
 Item 555
 S.B. 2423400 - 2423450 LF

Subgrade Item 115
 S.B. 2423400 - 2423400
 N.B. 2423475 - 2423475

S.B. 2423400 - 2423400 LF
 N.B. 2423400 - 2423400 LF

* STAGE 2 CONSTRUCTION

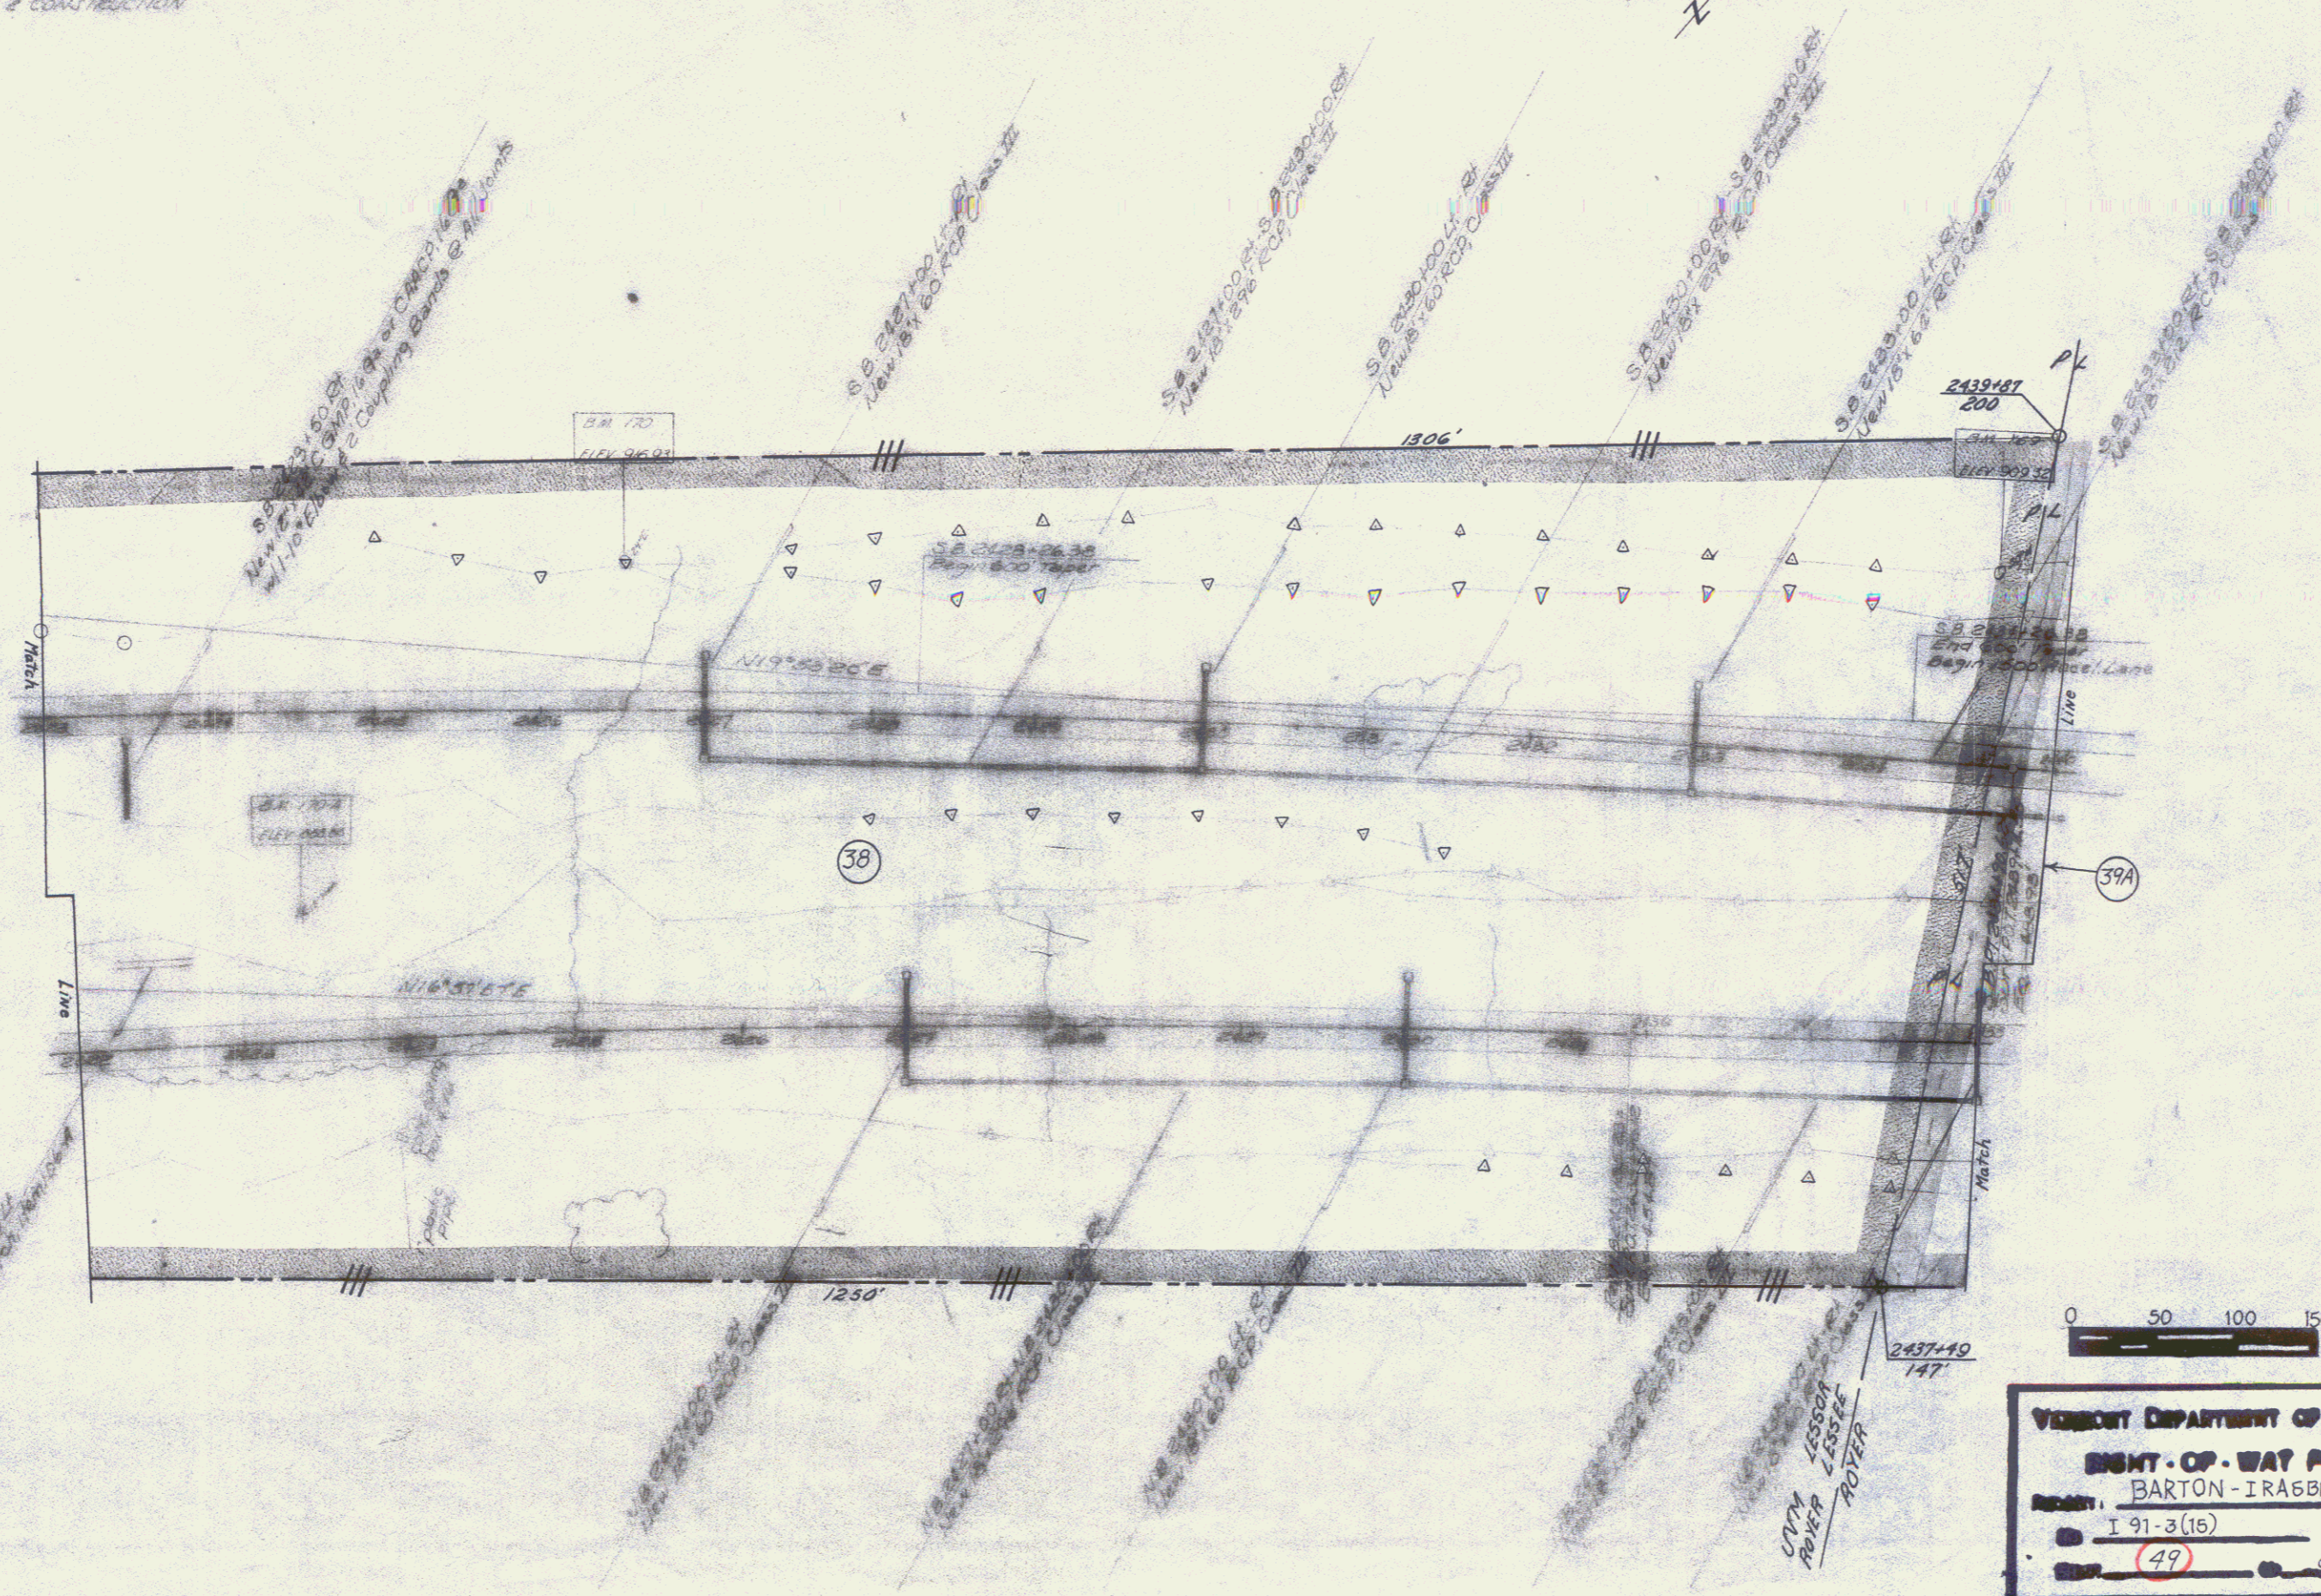

VERMONT DEPARTMENT OF HIGHWAYS
 EIGHT-OF-WAY PLANS
 BARTON - IRASBURG
 I 91-3(15)
 49 88