

Gravel Backfill for Slope
Stabilization, Item 202-A Mod.
N.B. 2113+00-2120+00 Lt.


Sub-base of Sand, Item 202
N.B. 2113+00-2119+75

* Three Cable Guard Rail
Light w/ Steel Posts
S.B. 2113+00-2122+00 Lt.
N.B. 2113+00-2122+00 Lt.

* TREATED Timber Curb
S.B. 2113+00-2122+00 Lt.
N.B. 2113+00-2122+00 Lt.

Property Line Fence
w/ Steel Posts, Item 583-II, Mod.
N.B. 2113+00-2122+00 Lt.
S.B. 2113+00-2122+00 Lt.

* STAGE 2 CONSTRUCTION

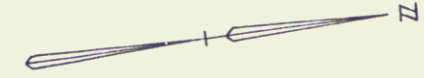

II
STAGE CONSTRUCTION
BARTON-IRASBURG

SURVEYED BY LoVelle DATE 7/63
DRAWN BY _____ DATE _____
TRACED BY R.L.E. DATE 5/66

PROJ. I NO. 91-3(11) (10)
SHEET 22 OF 50A

53 JUL 11 1974