


Sub-base of Sand from 202
VI 16 71.30 - 71.00


Property Line Fence w/ Steel Posts
Item 583-II Mod
92+00 - 94+00 Lt.
92+00 - 94+00 Rt.

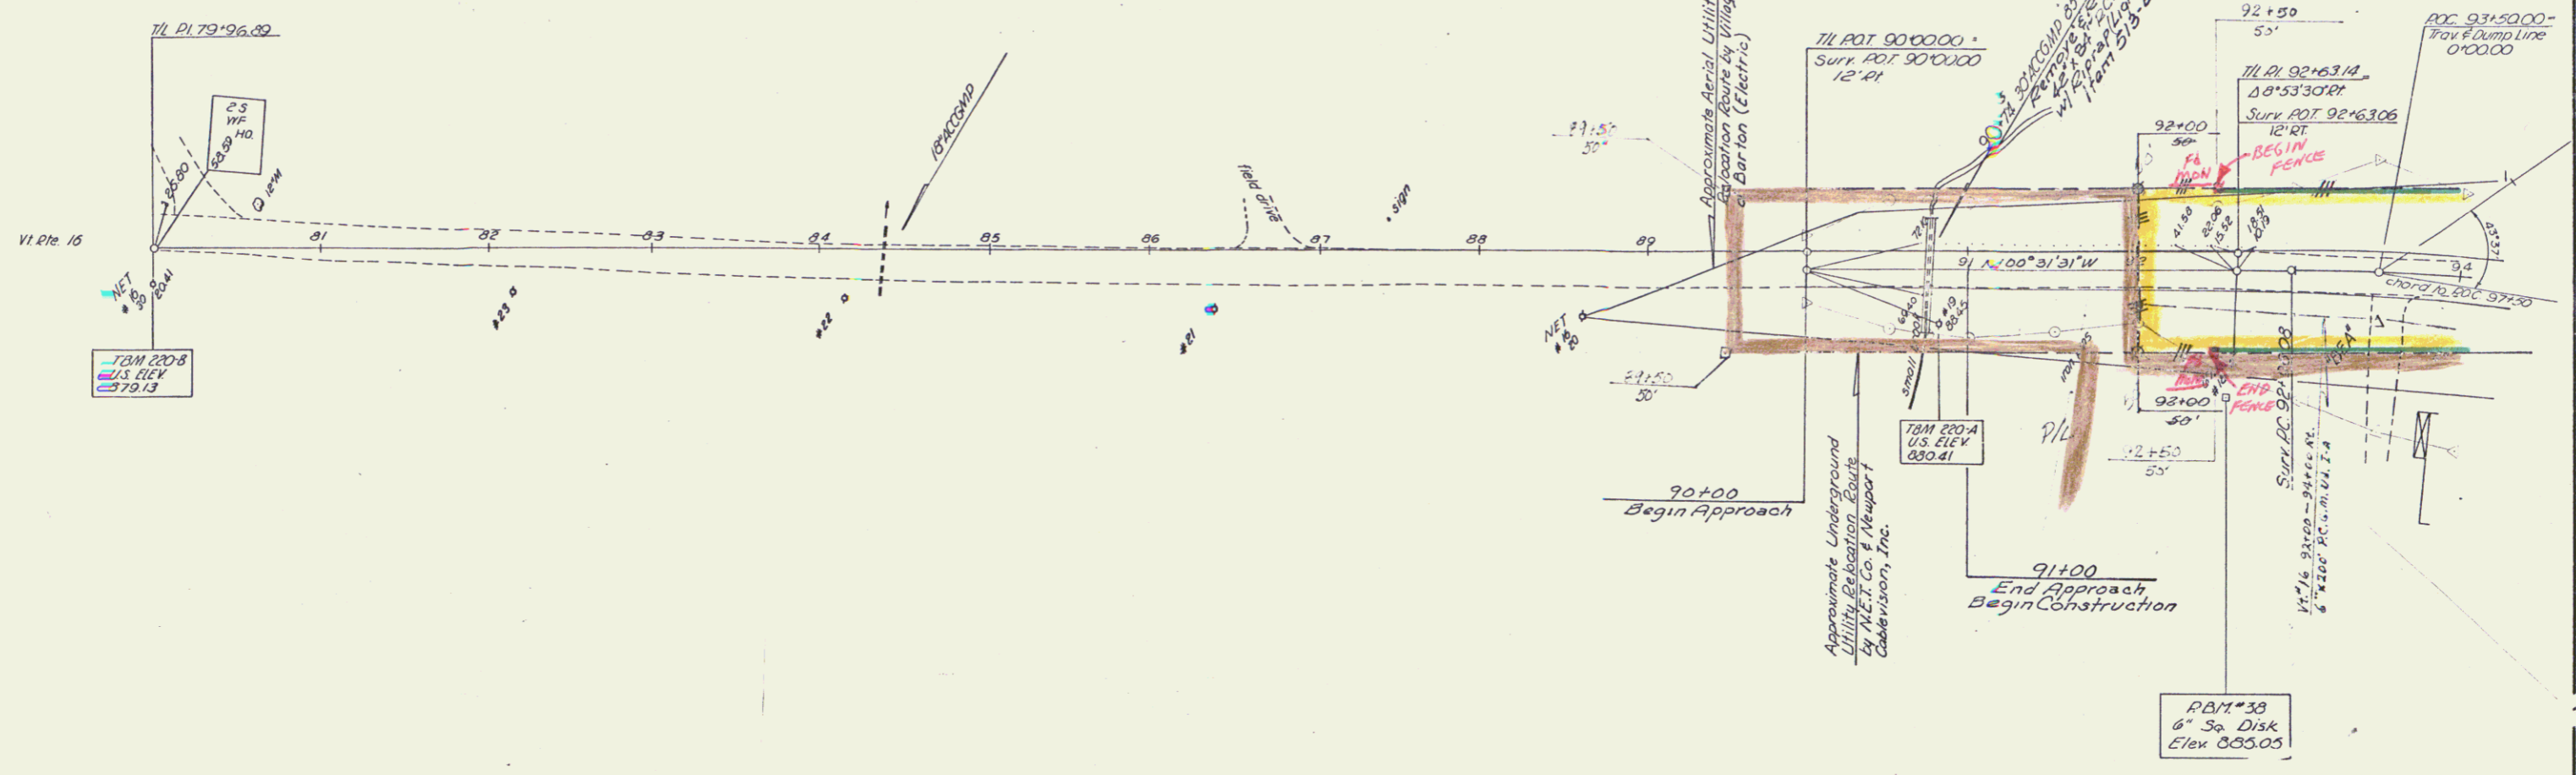

Stage 1 Construction
VI Rte 16 To Be Built
In Its Entirety During
Stage 1 Construction

BARTON-IRASBURG

SURVEYED BY	M/Me	DATE	6/62
DRAWN BY		DATE	
TRACED BY		DATE	
PROJ.	I	NO.	91-3(11)
SHEET	60	OF	670

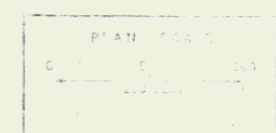

JUL 11 1974 56