

* Standard Steel Beam Guard Rail
w/ Steel Posts (6'3" spacing) Item 345-A
N.B. 2185+00 - 2197+00

Drilling & Blasting Of
Solid Rock Subgrade
Item 115
S.B. 2185+00 - 2200+75
N.B. 2185+50 - 2197+10
N.B. 2195+20 - 2197+75


* STAGE 2 CONSTRUCTION

Drilling & Blasting Of
Solid Rock
Item 115
N.B. 2195+00 - 2199+20
S.A. 2185+00 - 2197+00

Stone Fill For Slope
Protection (Light Type)
Item 512
N.B. 2195+00 - 2197+00
S.B. 2185+00 - 2197+00


Property Line Fence
w/ Steel Posts, Item 533-2 Mod.
N.B. 2185+00 - 2201+00
S.B. 2185+00 - 2201+00
To be erected prior to Construction

Jute Matting Item 623
N.B. 2197+70 - 2199+50
N.B. 2200+20 - 2201+00

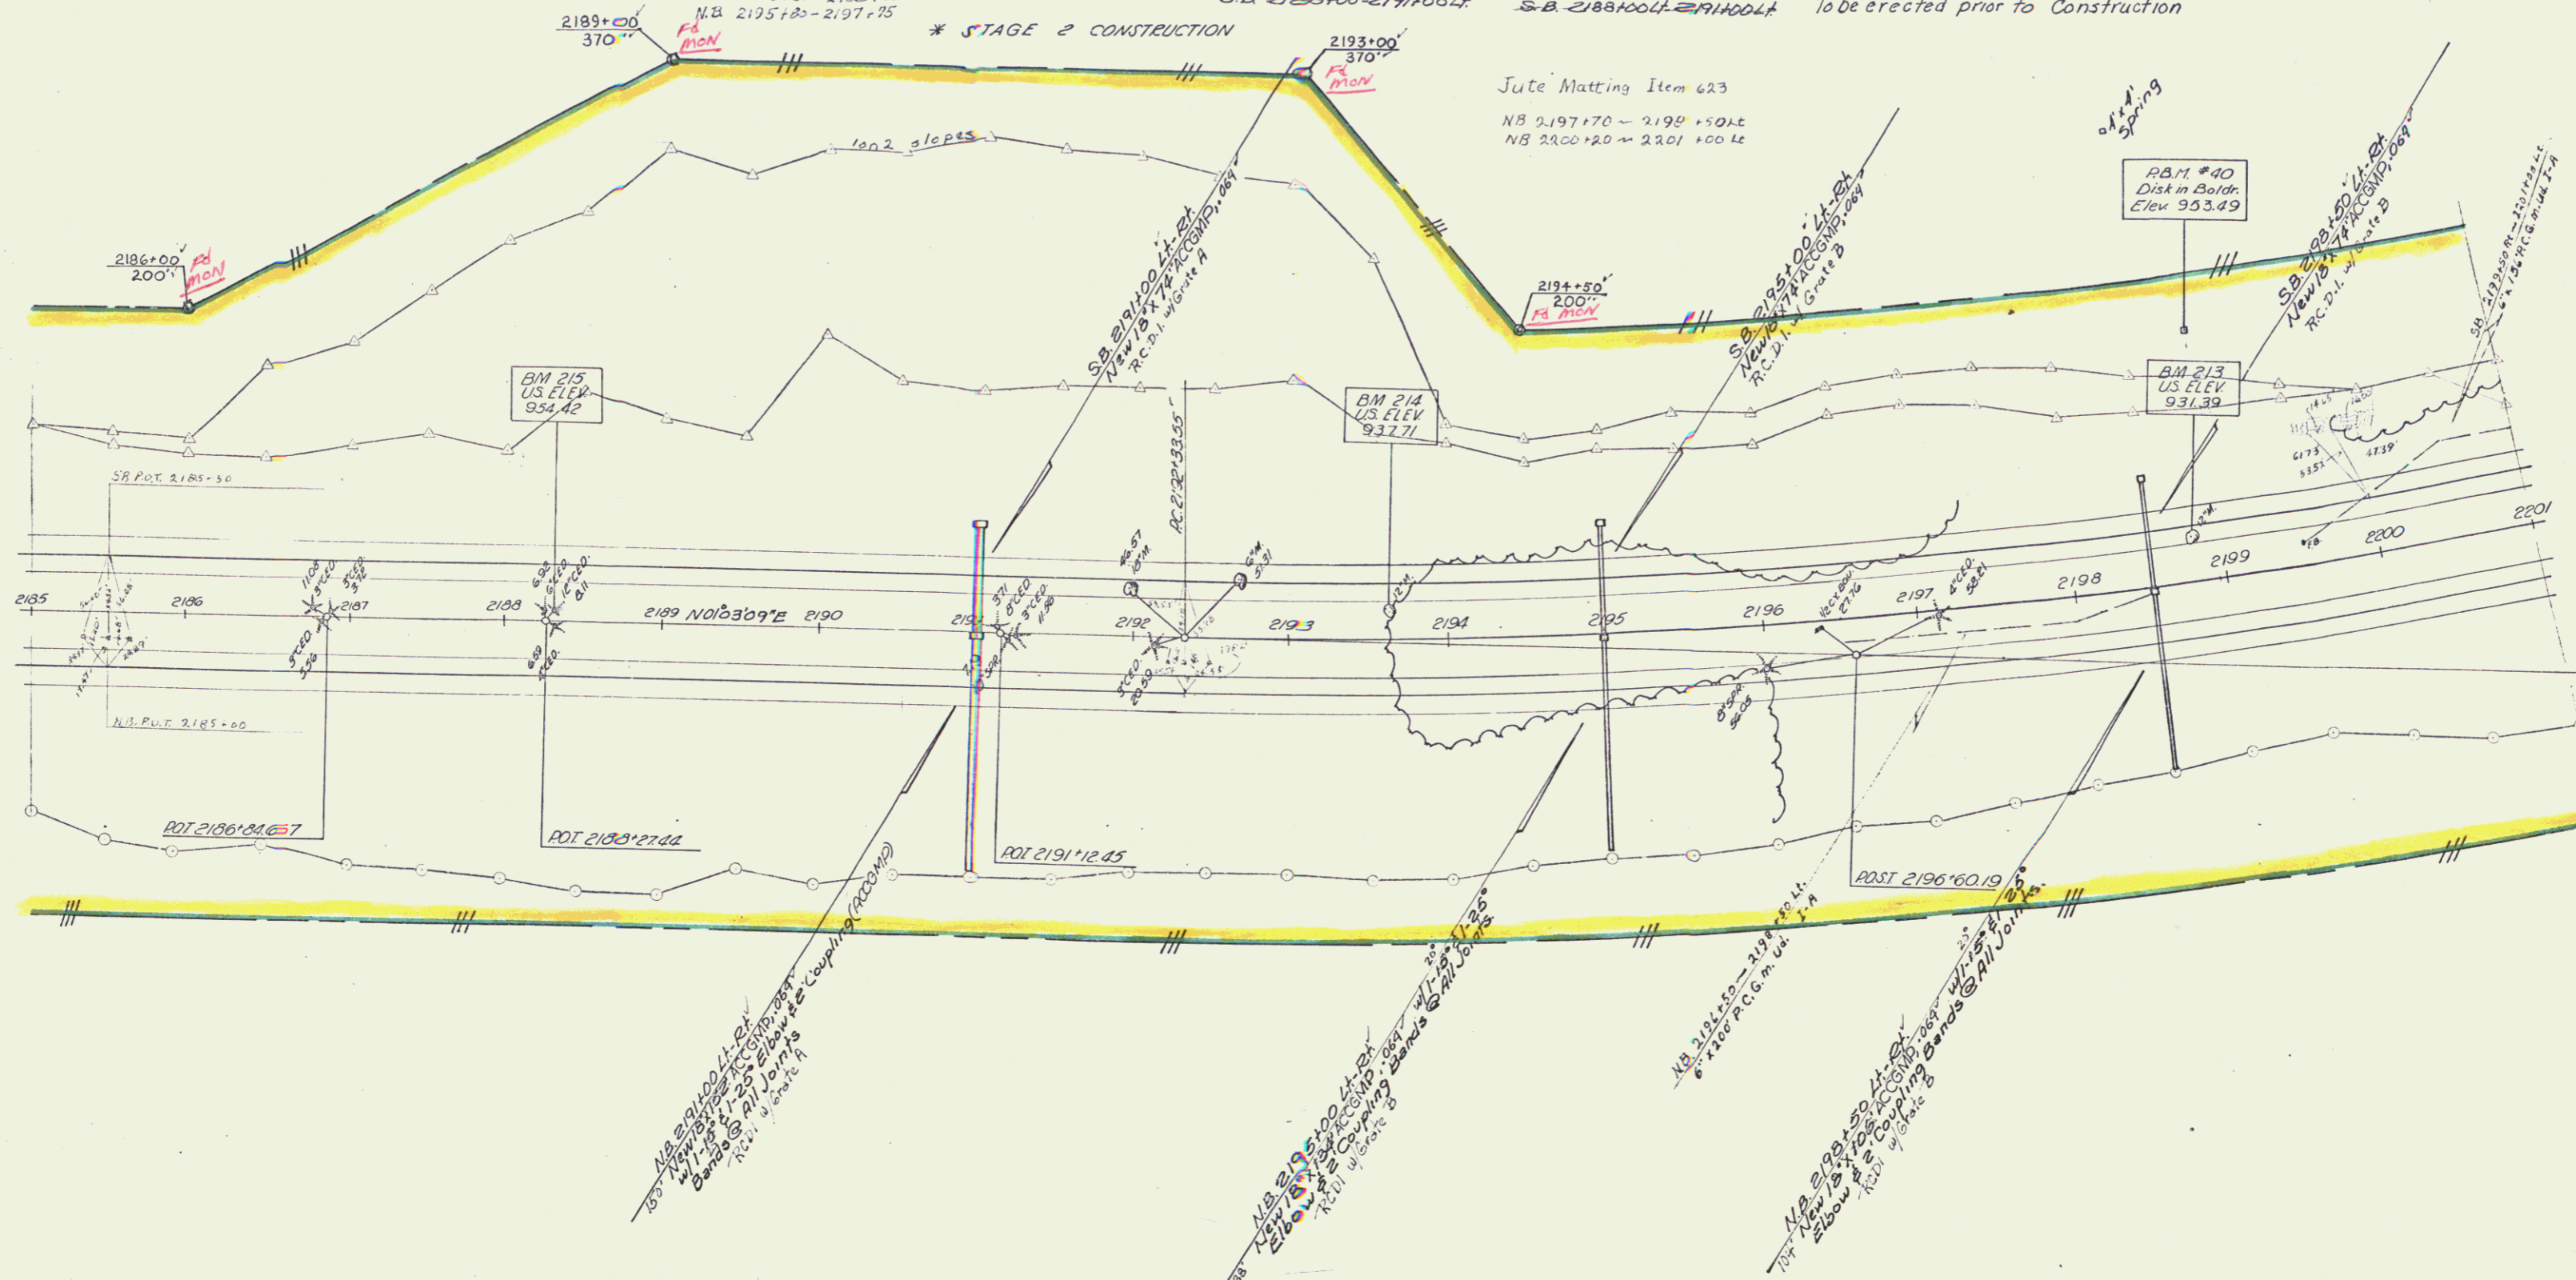

STAGE 2 CONSTRUCTION
BARTON

SURVEYED BY Spaulding DATE 1/68
DRAWN BY Austin DATE 2/68
TRACED BY Clark DATE 3/68

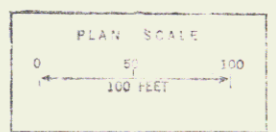

PROJ. EMP. NO. 91-3 (19)
SHEET 69 OF 114

JUL 11 1974