

Treated Timber Curb  
Item 558  
SB 2281+00-2283+57.47  
NB 2281+57-2283+17.47  
SB 2290+76-2293+79.12  
NB 2290+77-2293+96.72

Three Cable Guard Rail  
Light Steel Posts, Item 538  
SB 2281+00-2286+74.4  
SB 2289+50-2294+94.4  
SB 2290+50-2294+50.00  
SB 2290+57-2295+28.76

Standard Steel Beam Guard Rail  
w/Steel Posts (6' spacing) Item 545-A  
NB 2281+00-2283+25.11 NB 2290+00-2293+00.11  
SB 2281+00-2284+50.00 NB 2290+00-2293+00.00  
NB 2281+00-2283+25.01 NB 2290+00-2293+00.00  
SB 2281+00-2283+25.01 NB 2290+00-2293+00.00  
\* STAGE 2 CONSTRUCTION


Sub-base of Sand, Item 202  
SB 2294+25-2297+00

PROPERTY LINE FENCE w/STEEL  
POSTS ITEM 583 II MOD  
NB 2281+00-2297+00.00  
SB 2281+00-2297+00.00

N.B. Curve Data  
A 100' Radius  
Q 90° 35'  
R 9822.13  
T 857.35  
L 1714.29  
E 37.52  
Bank 1/4" @ 33 1/4"

STAGE 2 CONSTRUCTION

BARTON  
SURVEYED BY \_\_\_\_\_ DATE \_\_\_\_\_  
DRAWN BY \_\_\_\_\_ DATE \_\_\_\_\_  
TRACED BY AJA DATE 11/65  
PROJ. EMP. I No. 91-3 (19)  
SHEET 83 OF 114

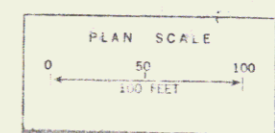

JUL 11 1974