




* Three Cable Guard Rail
w/ Steel Posts - Item 533
N.B. 2335100-2344125 RT
S.B. 2335100-2343100 LT
S.B. 2335100-2343100 LT
N.B. 2335145-2344125 LT

* Treated Timber Curb
Item 558
N.B. 2334100-N.B.2335102 RT
S.B. 2335100-S.B.2335152 LT & RT
N.B. 2335125-N.B.2335102 LT

* Topsoil Stockpiled
NB 2334100-2338100 RT

Property Line Fence
w/ Steel Posts, Item 533-1/2 Mod.
N.B. 2335100-2343100 RT
S.B. 2335100-2343100 LT

* STAGE 2 CONSTRUCTION

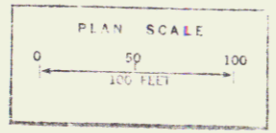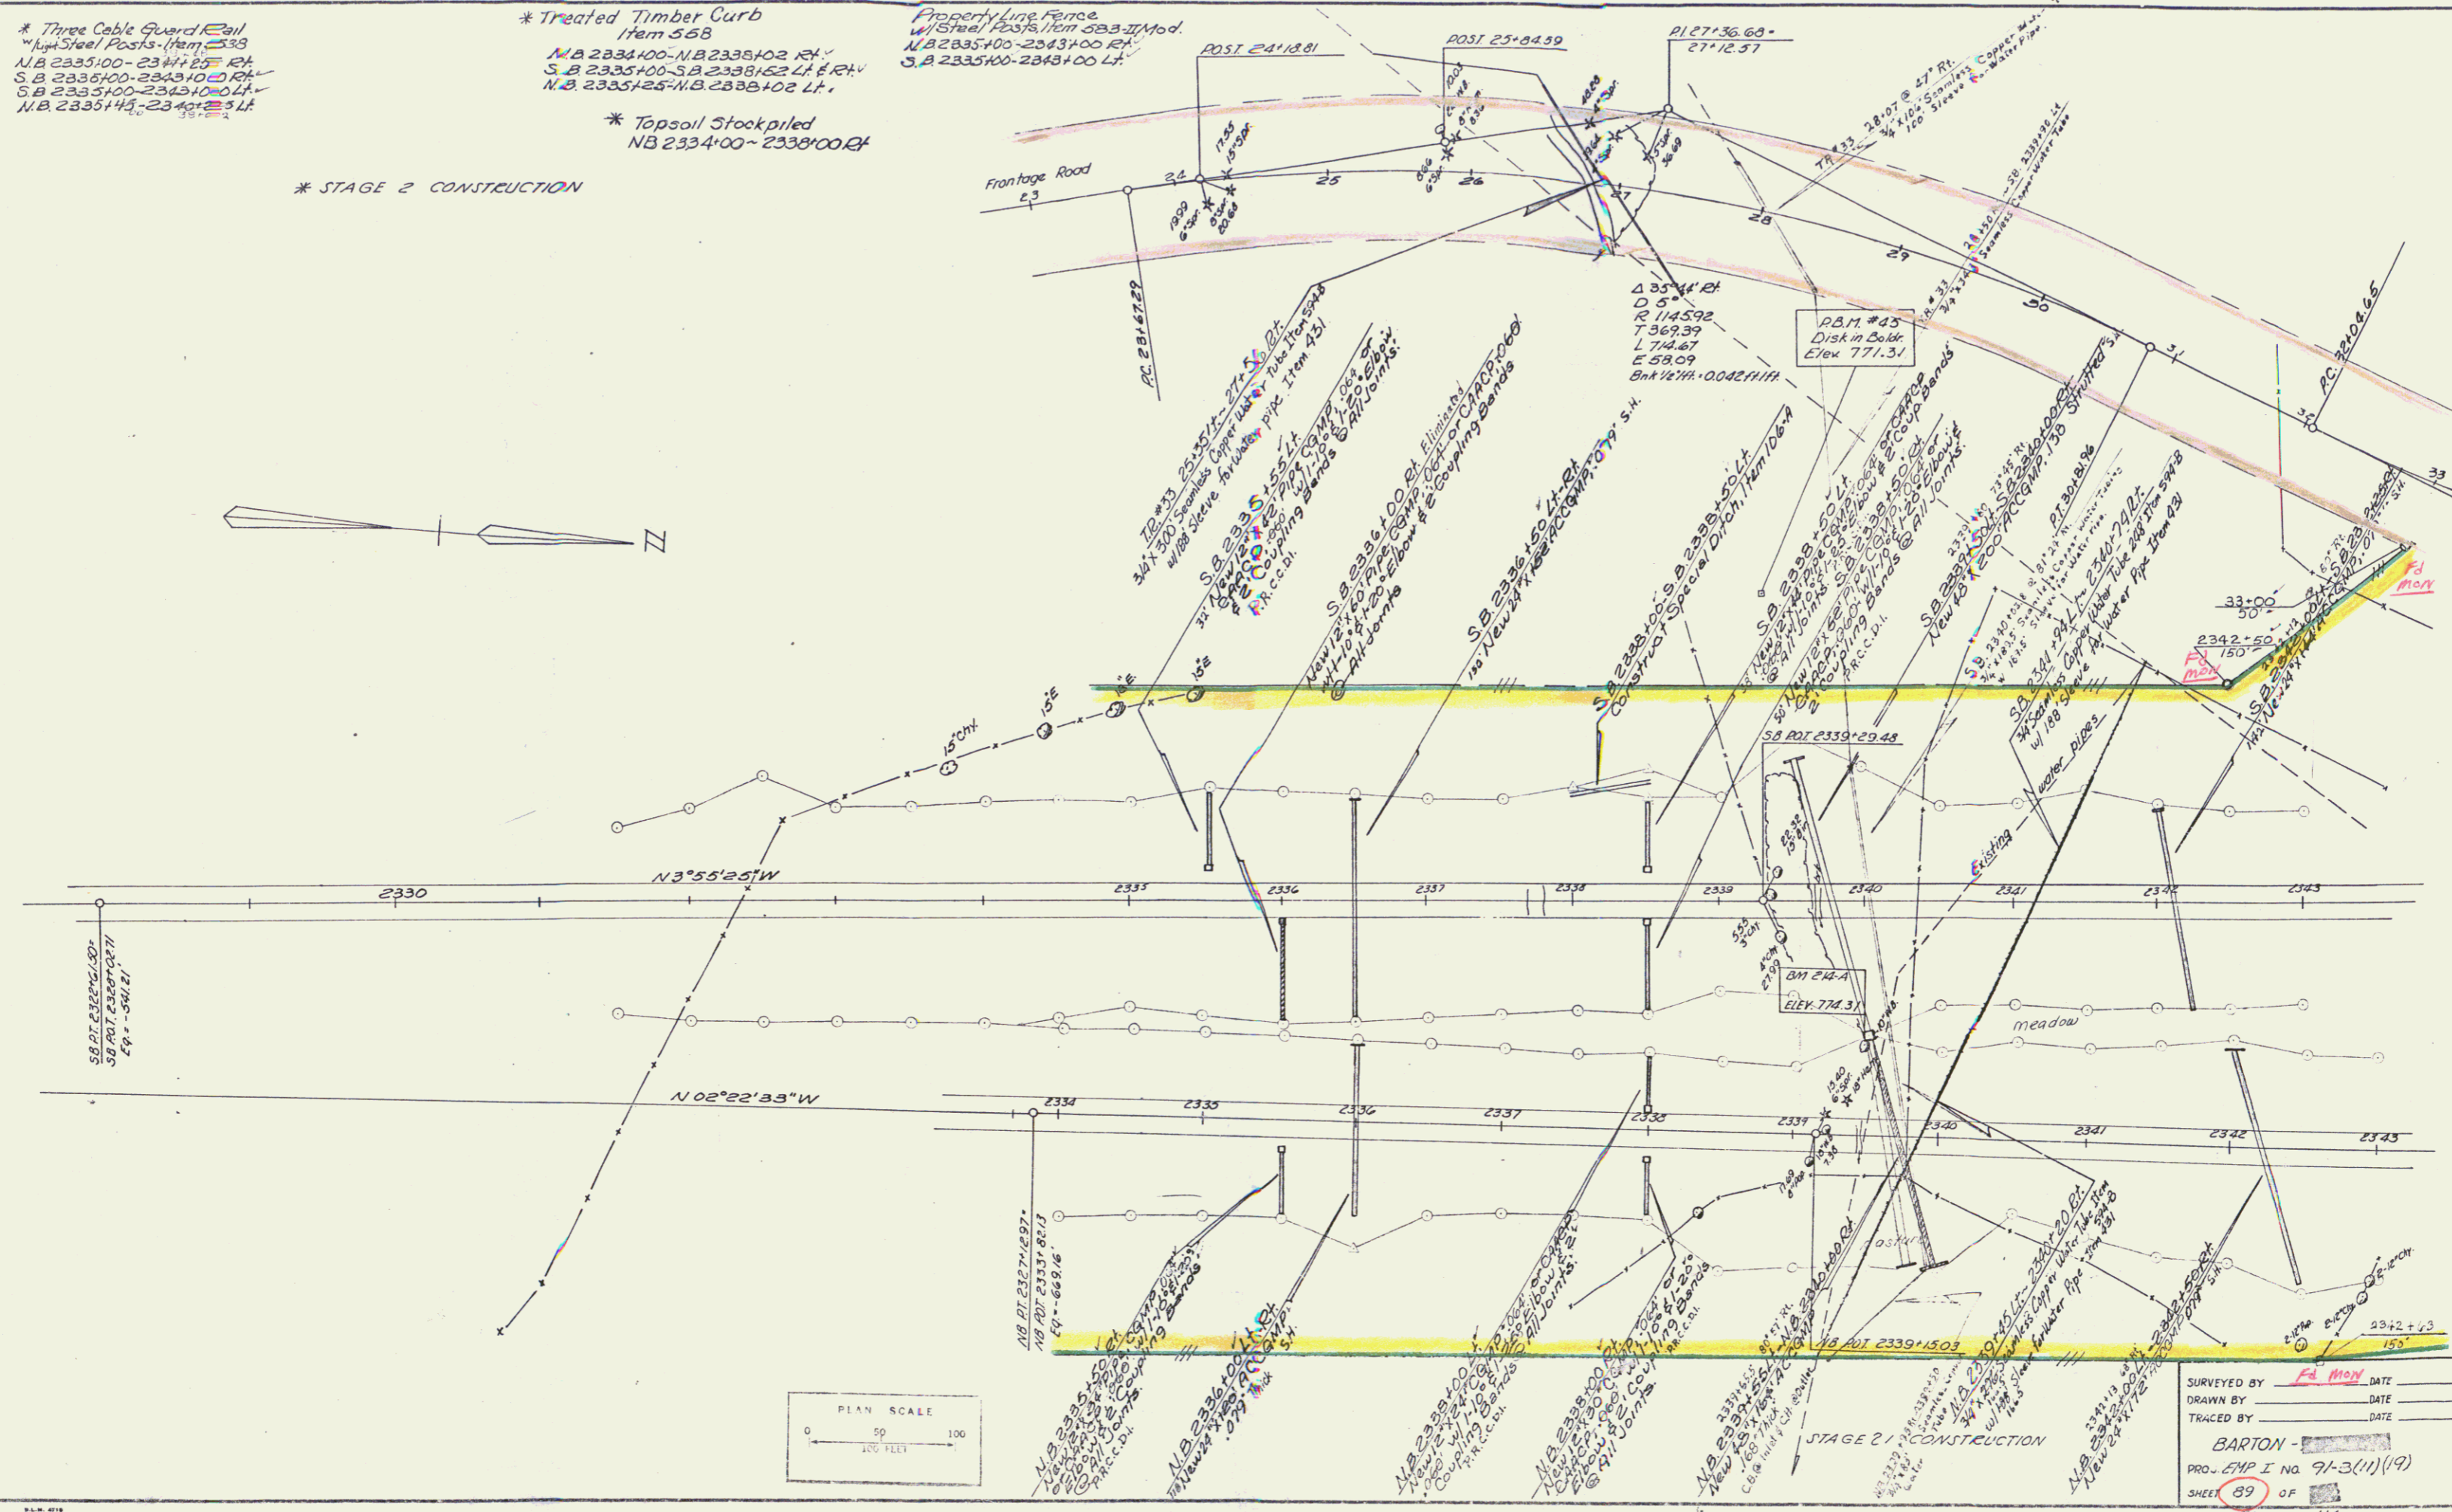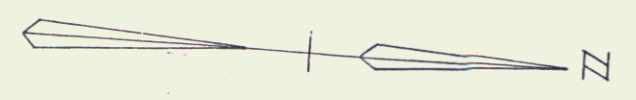

SURVEYED BY Fd. Mon. DATE _____
 DRAWN BY _____ DATE _____
 TRACED BY _____ DATE _____
 BARTON - _____
 PROJ. EMP I NO. 91-3(11)(9)
 SHEET 89 OF 114

72
 JUL 11 1974