
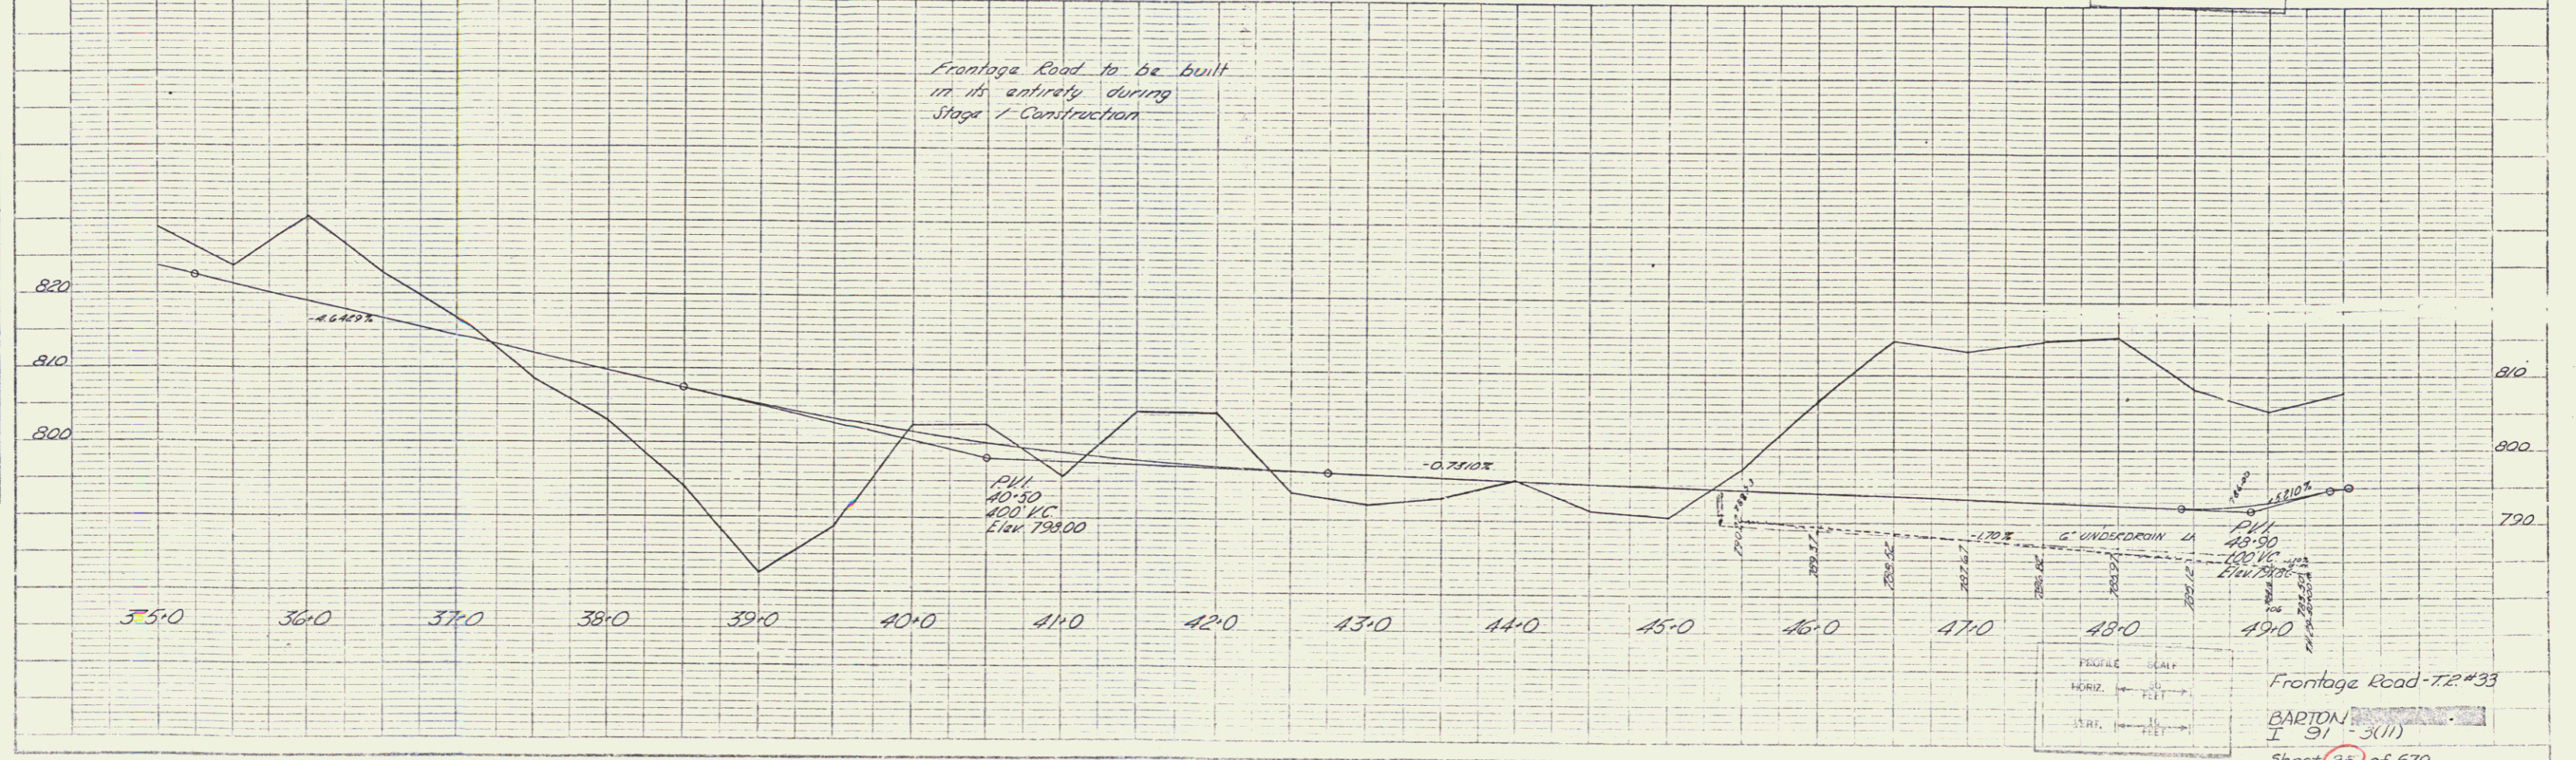


PLAN  
 2/28/74  
 5/1/74

PROFILE  
 5-16  
 5-16

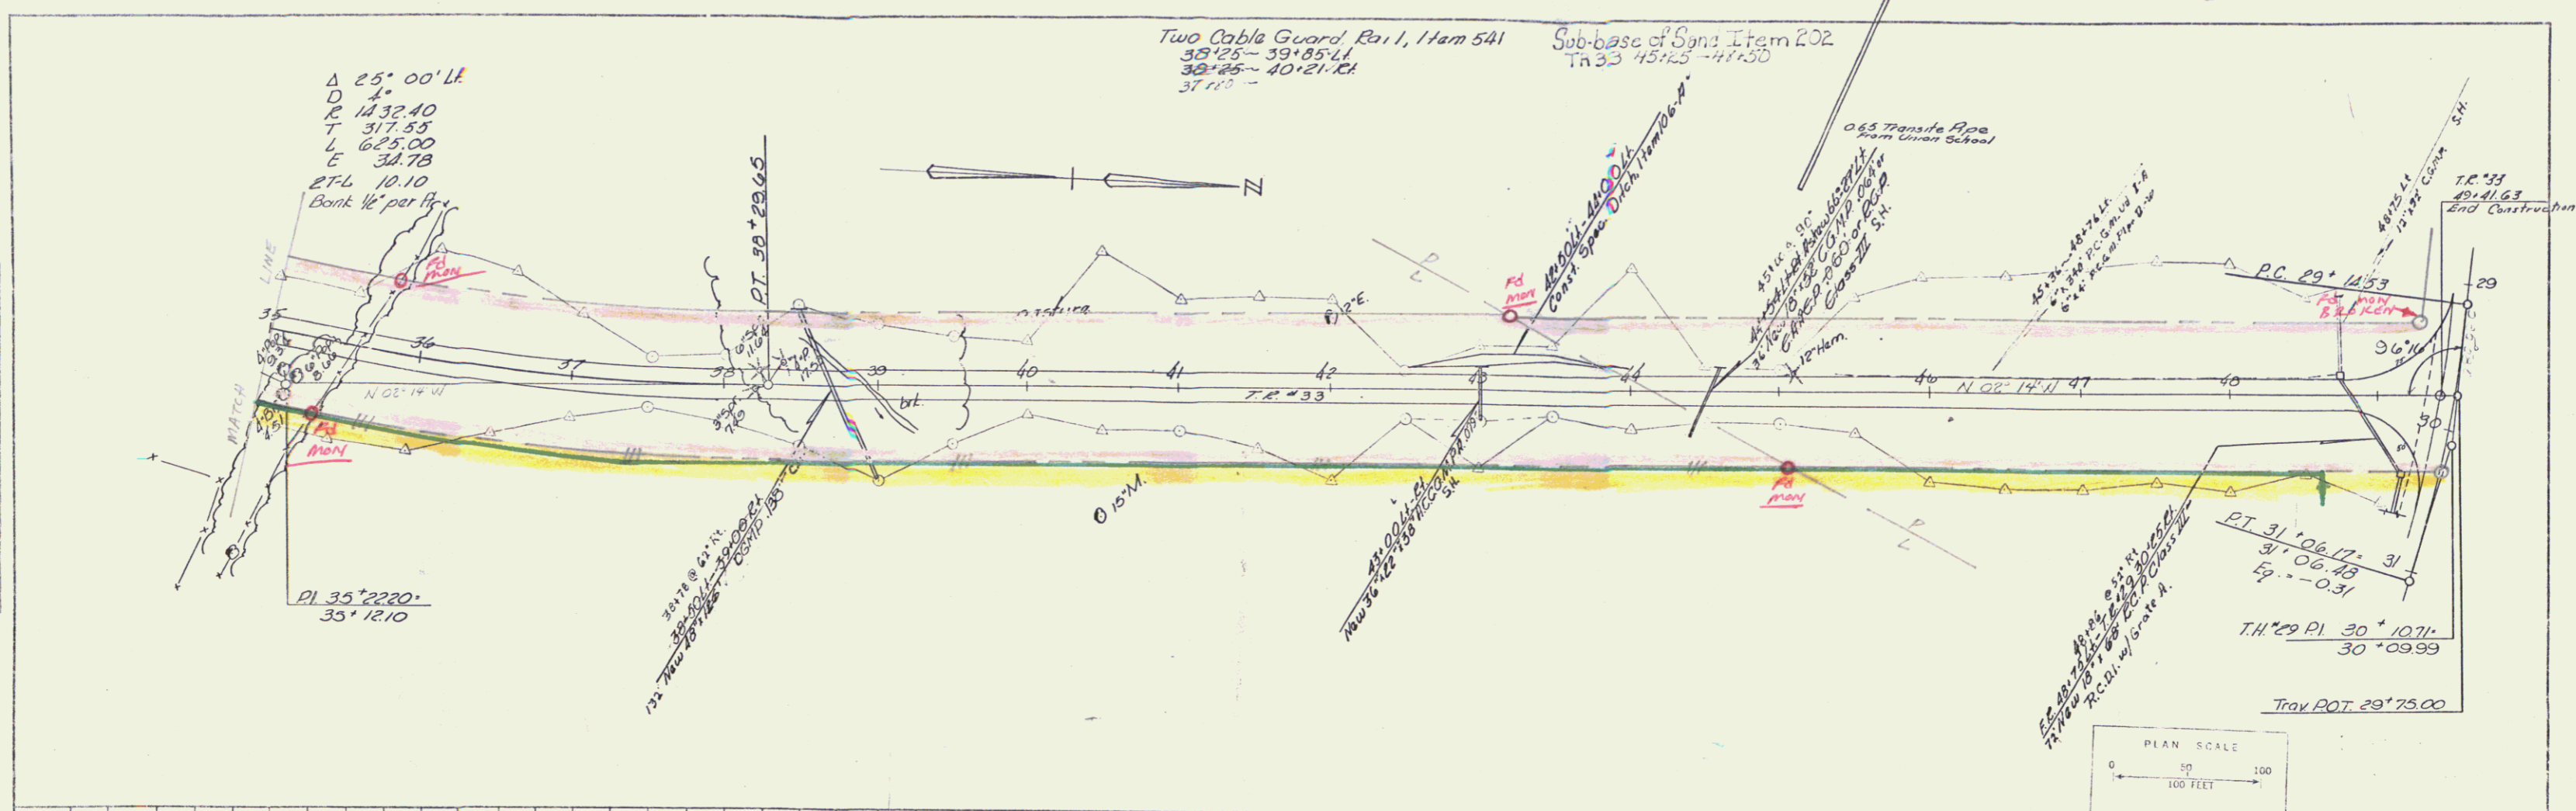

JUL 11 1974