

\* TREATED TIMBER CURB  
Item 5-58

S.B. 2377+95 - 2389+00 RT  
S.B. 2380+00 - 2386+18 LT  
N.B. 2380+00 - 2390+10 LT  
N.B. 2380+00 - 2391+00 RT

\* Three Cable Guard Rail  
Wght Steel Posts, Item 5-33

S.B. 2378+00 - 2386+96 LT  
S.B. 2375+50 - 2390+62 RT  
N.B. 2375+50 - 2390+54 LT

\* STAGE 2 CONSTRUCTION


Sub-base of Sand Item 202  
S.B. 2390+25 - 2391+00

Property Line Fence  
w/ Steel Posts, Item 5-33 II, Mod.  
N.B. 2375+00 - 2391+00 RT

S.B. 2375+00 - 2391+00 RT

Muck Excavation, Item 17  
S.B. 2375+00 - 2376+75  
S.B. 2379+50 - 2381+50  
N.B. 2384+50 - 2386+00

Standard Steel Beam Guard Rail  
w/ Steel Posts (6'-3" spacing) Item 5-45-A  
N.B. 2373+00 - 2391+00 RT

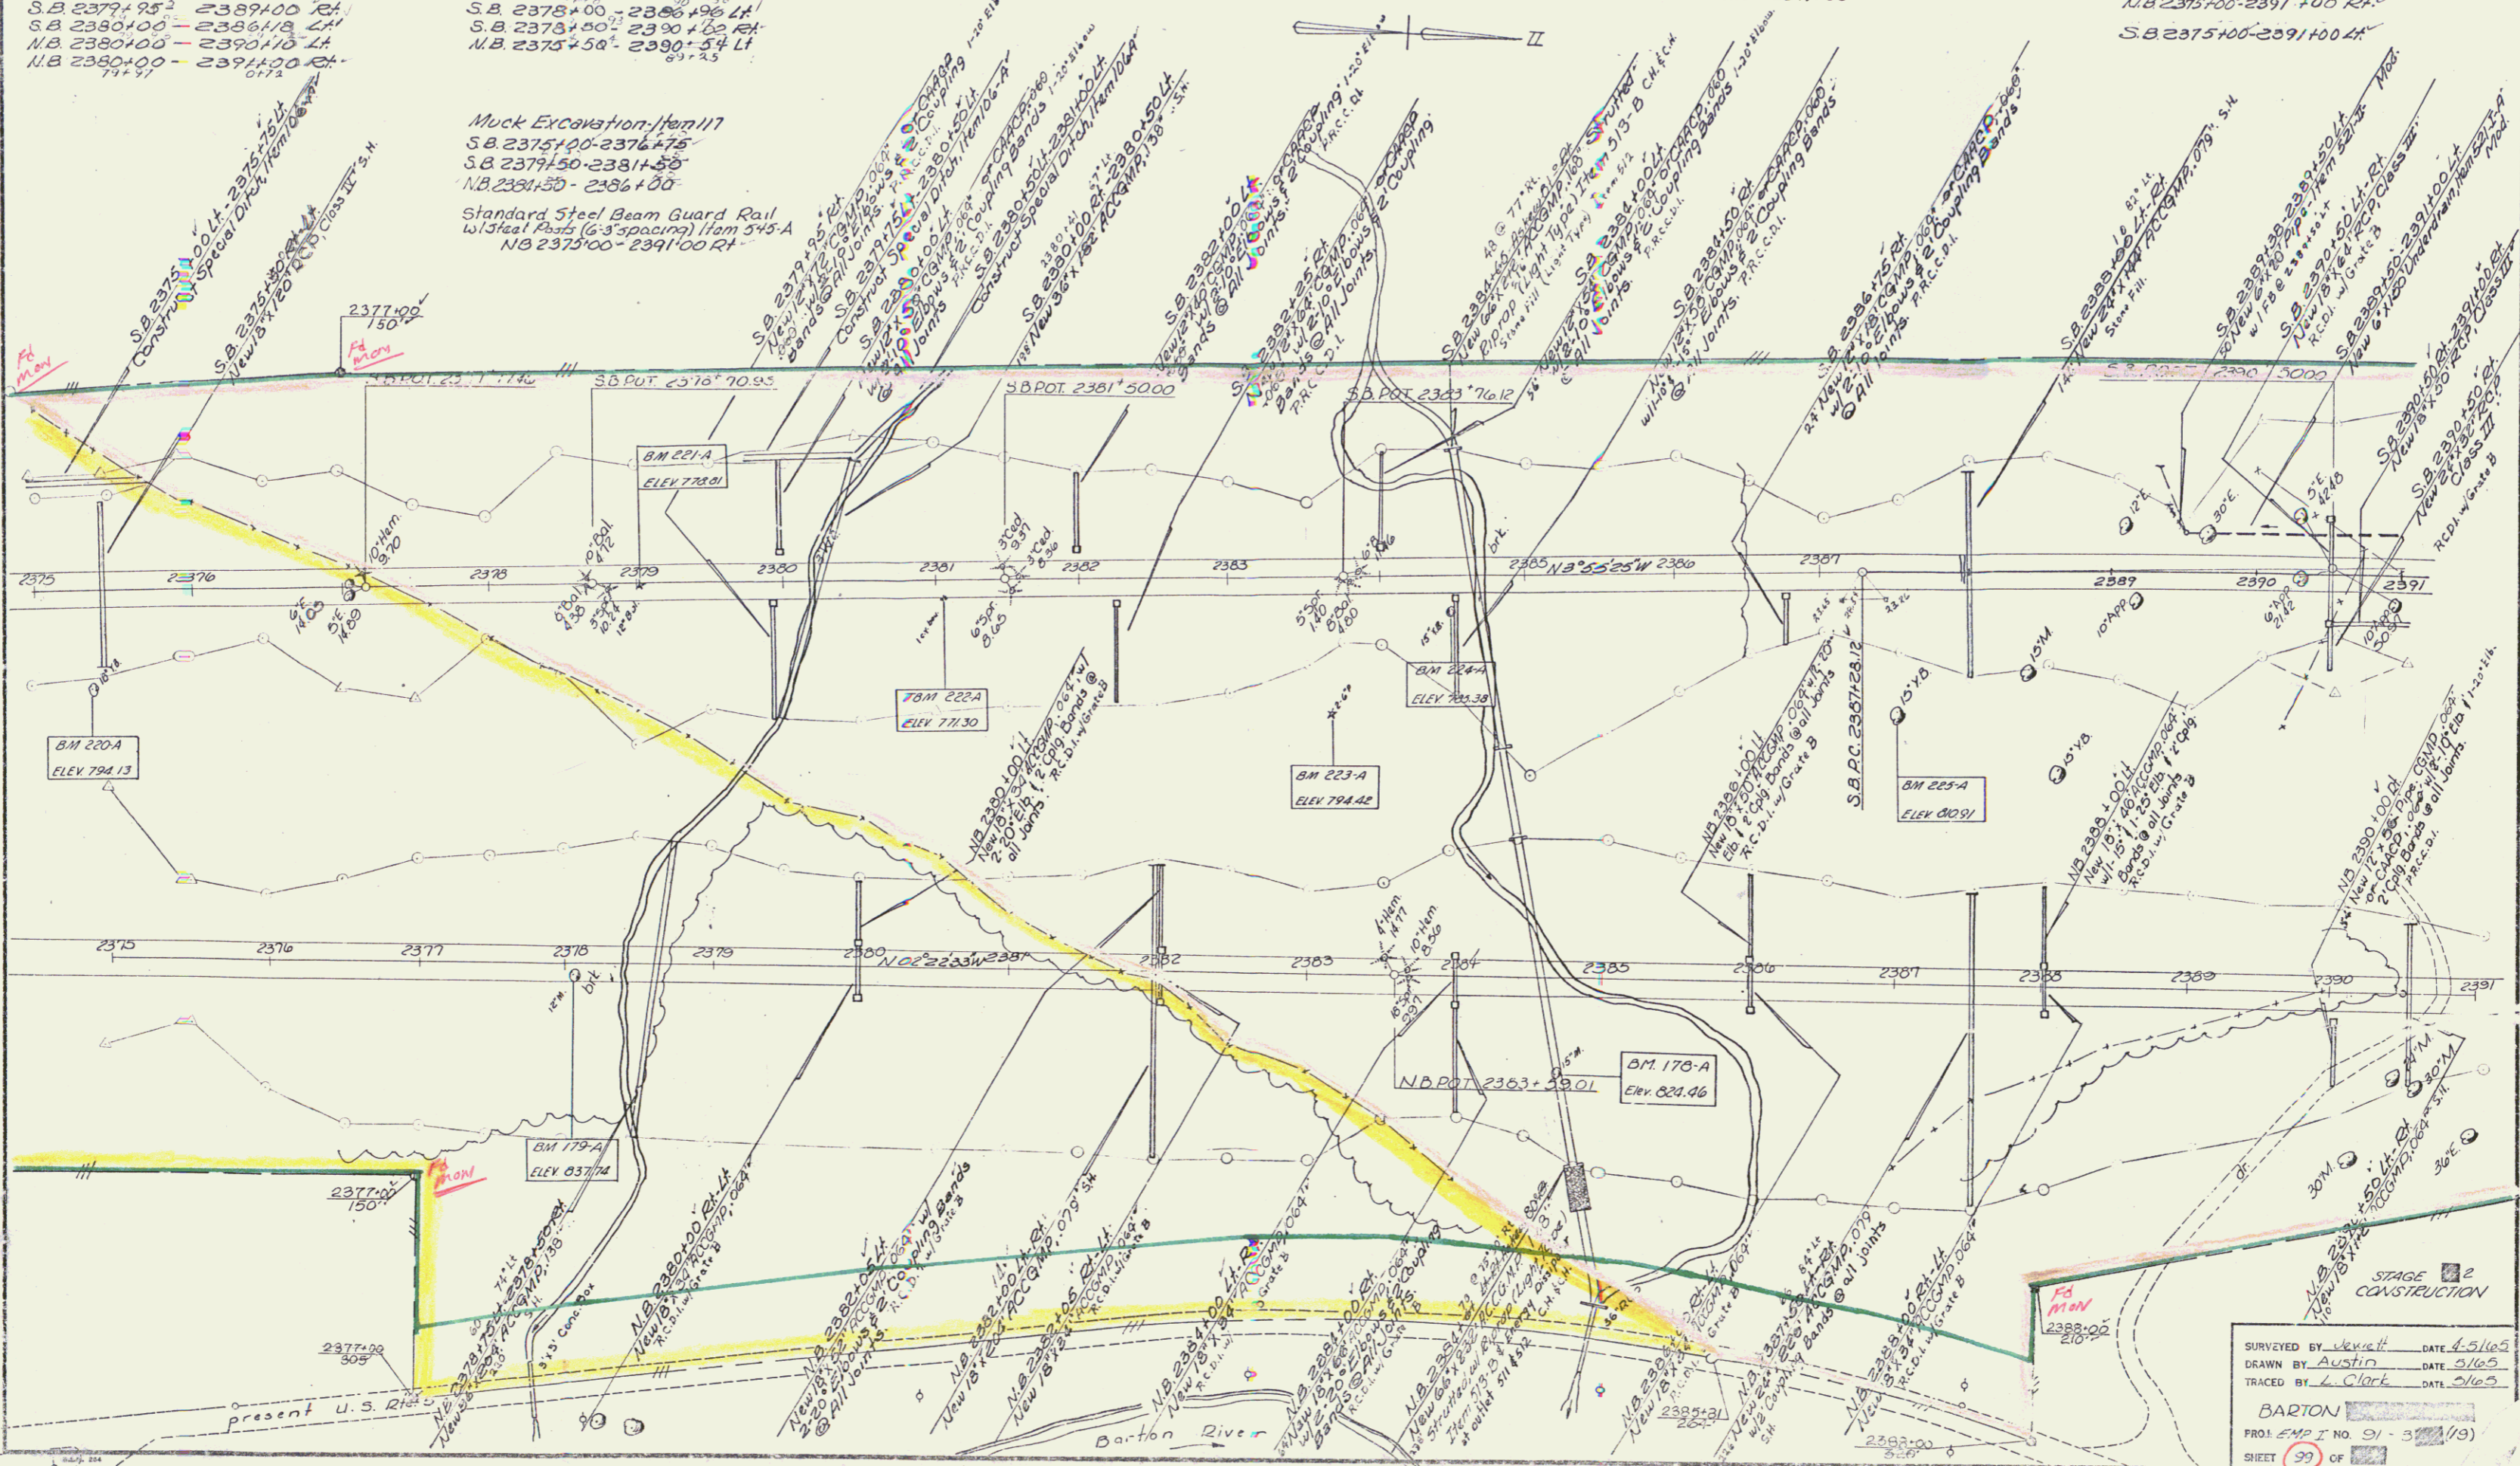

STAGE 2 CONSTRUCTION

SURVEYED BY *W. Austin* DATE 4-5-65  
 DRAWN BY *Austin* DATE 5-16-65  
 TRACED BY *L. Clark* DATE 2-16-65

**BARTON**

PROJ. EMP. I NO. 91 - 5 (19)  
 SHEET 99 OF 60

JUL 11 1974