


* Three Cable Guard Rail
w/ Light Steel Posts, Item 538
S.B. 2423+00 - 2424+46.00 Rt
N.B. 2422+00 - 2423+58.00 Lt
S.B. 2423+00 - 2423+32 Lt
* STAGE 2 CONSTRUCTION

* TREATED TIMBER CURB
Item 658
S.B. 2423+00 - 2423+50 Rt
Construct Maintenance U-Turn
242400(NBL) - 242522(SBL)


Drilling & Blasting of Solid Rock
Subgrade, Item 115
S.B. 2425+23 - 2440+00
N.B. 2424+75 - 2438+00

Property Line Fence
w/ Steel Posts, Item 53.5. Mod.
N.B. 2422+00 - 2438+00 Lt
S.B. 2423+00 - 2440+00 Rt

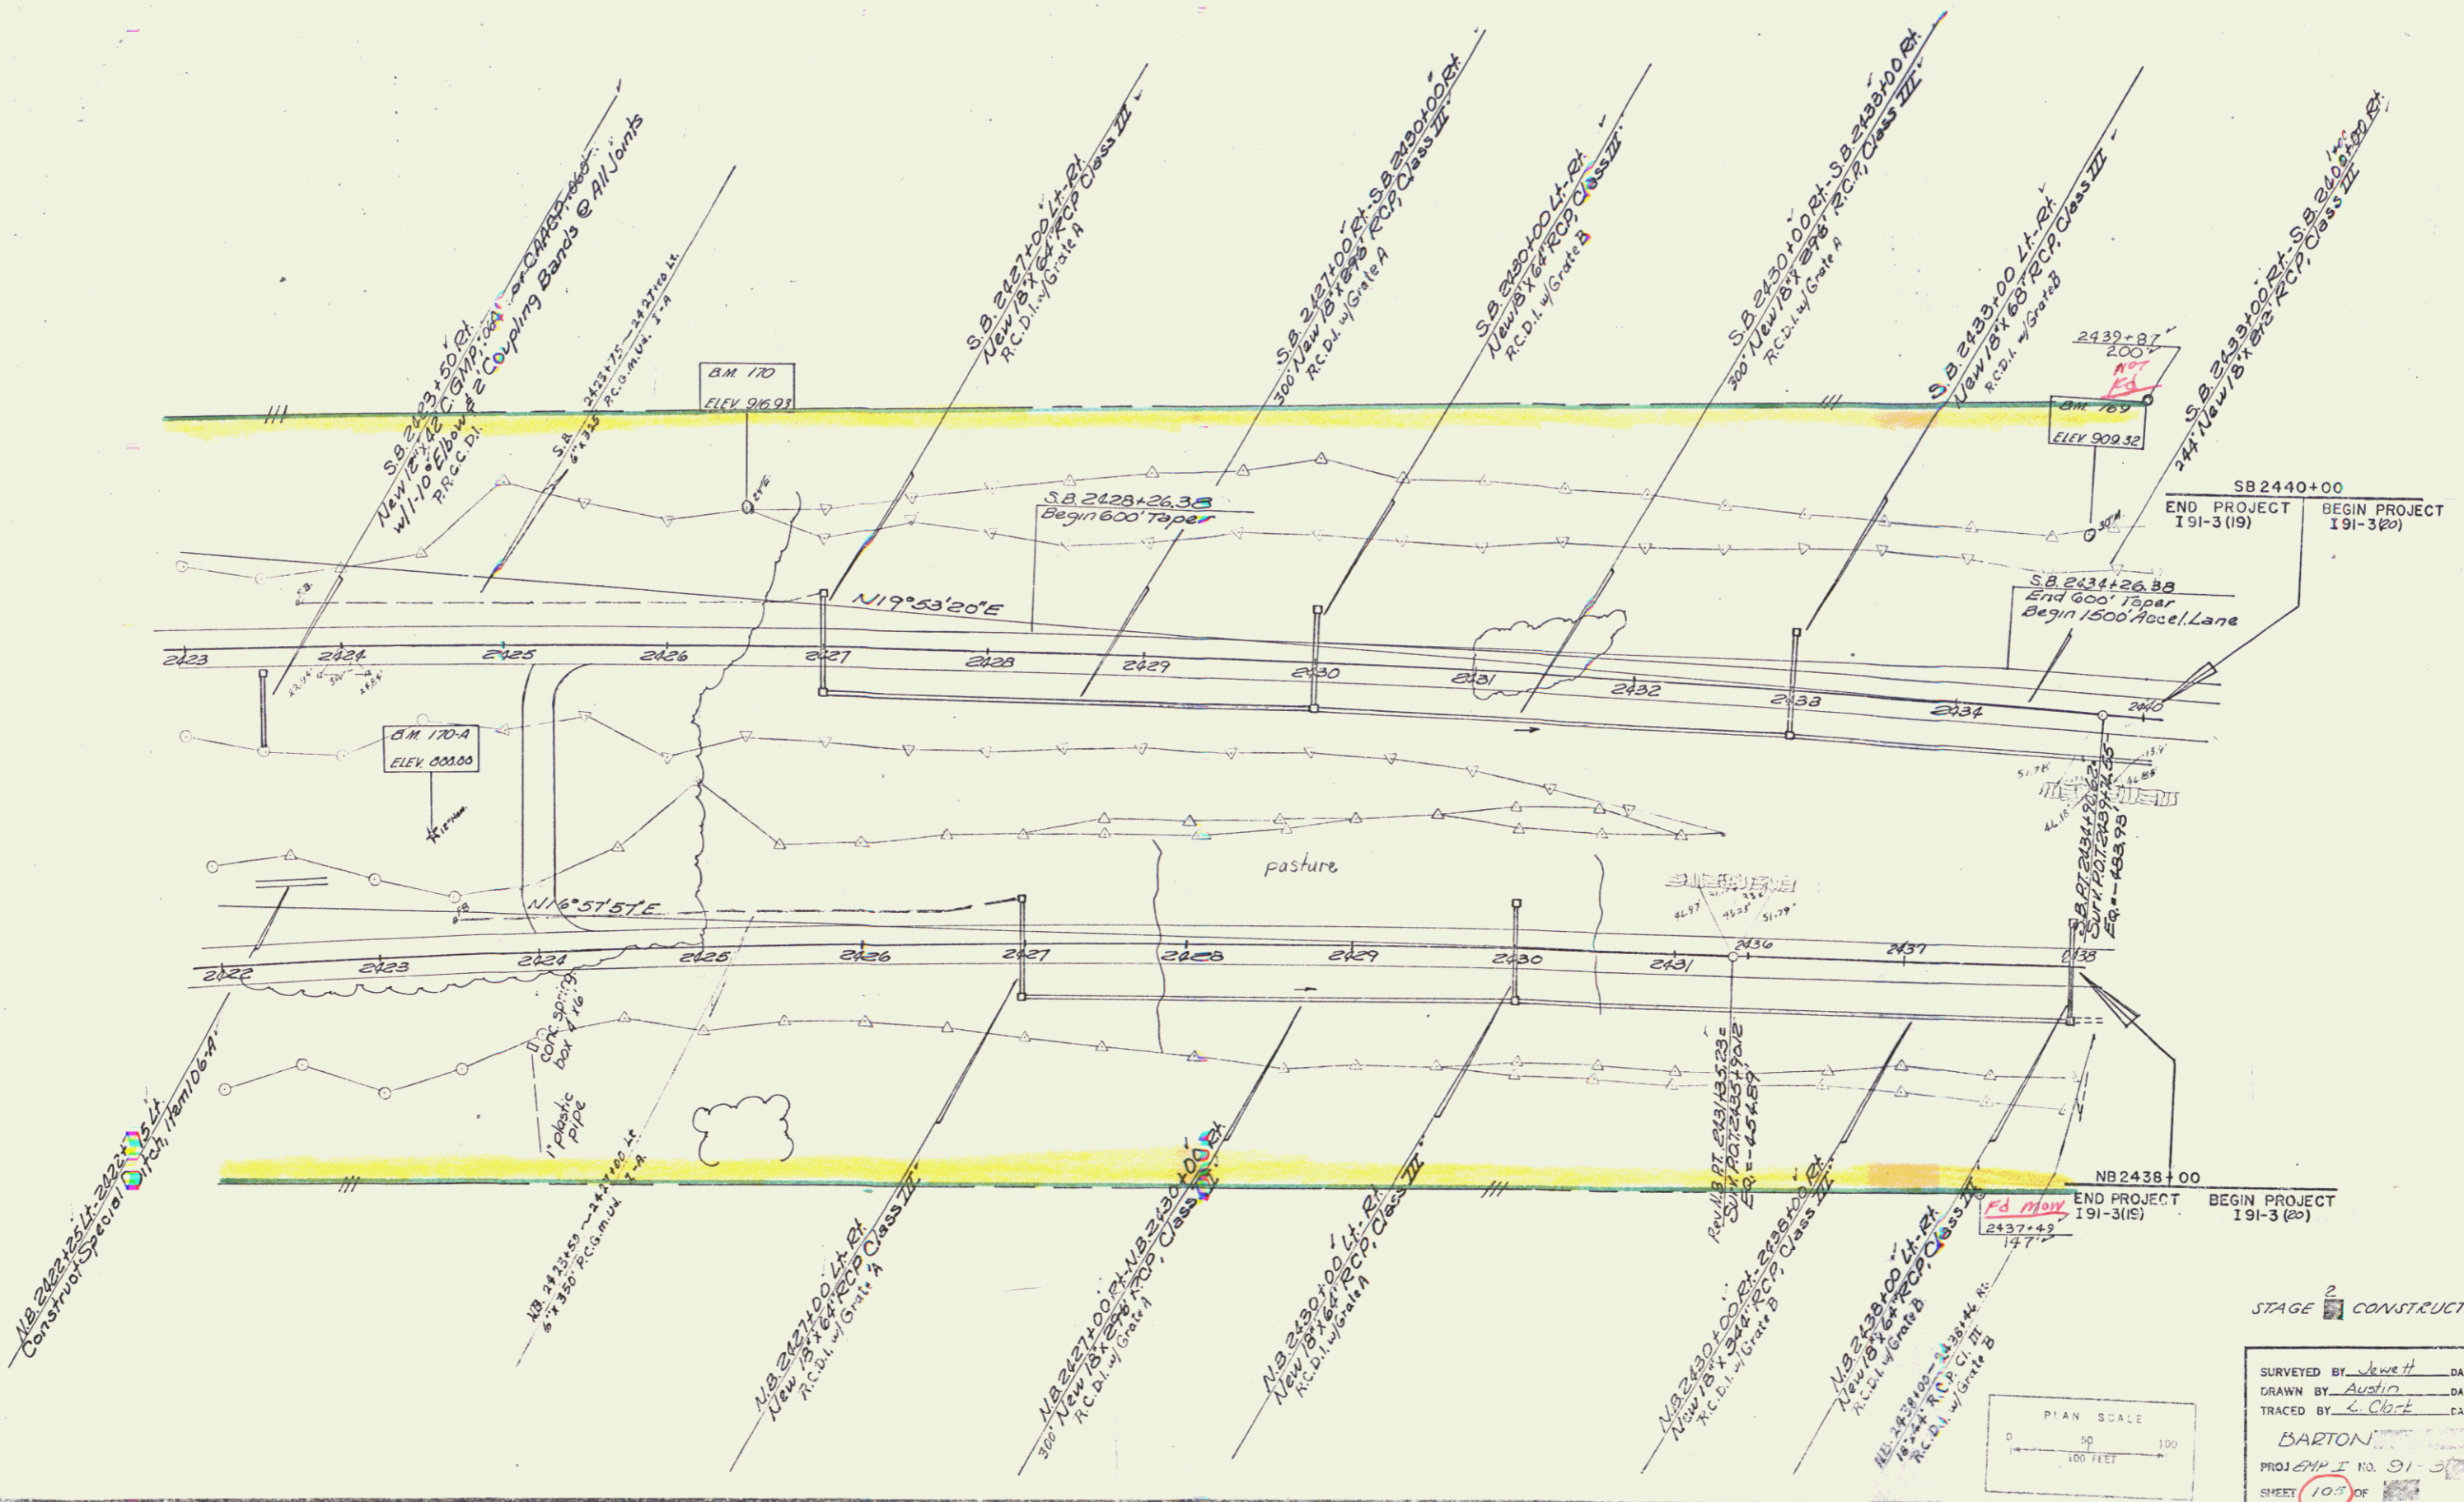

STAGE 2 CONSTRUCTION

SURVEYED BY: J. Clark DATE: 4/5/63
DRAWN BY: Austin DATE: 5/1/63
TRACED BY: L. Clark DATE: 5/1/63
BARTON
PROJECT NO. 91-3(19)
SHEET 103 OF 114

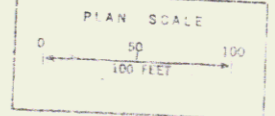

JUL 1 1974