

* Three Chain Guard Rail w/
Light Vertical Posts, Item 508
- N.B. 2471+07 - 2480+00 R/L
+ 2470+00 - 2480+00 R/L



* STAGE 2 CONSTRUCTION

Property Line Fence
w/ Steel Posts Item 505 3/4 Mod.
N.B. 2470+00 - 2480+00 R/L
S.B. 2477+00 - 2480+00 L/S

Sub-base of Sand
11.69 EOL
S.B. 2472+00 - 2475+00

Stone Fill For Slope Protection
(Light type) Item 512
N.B. 2470+00 - 2480+00 R/L
S.B. 2474+00 - 2475+00 L/S

Construct U-Turn
2470+00 NB LH - 2471+35.35 R/L

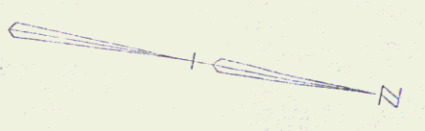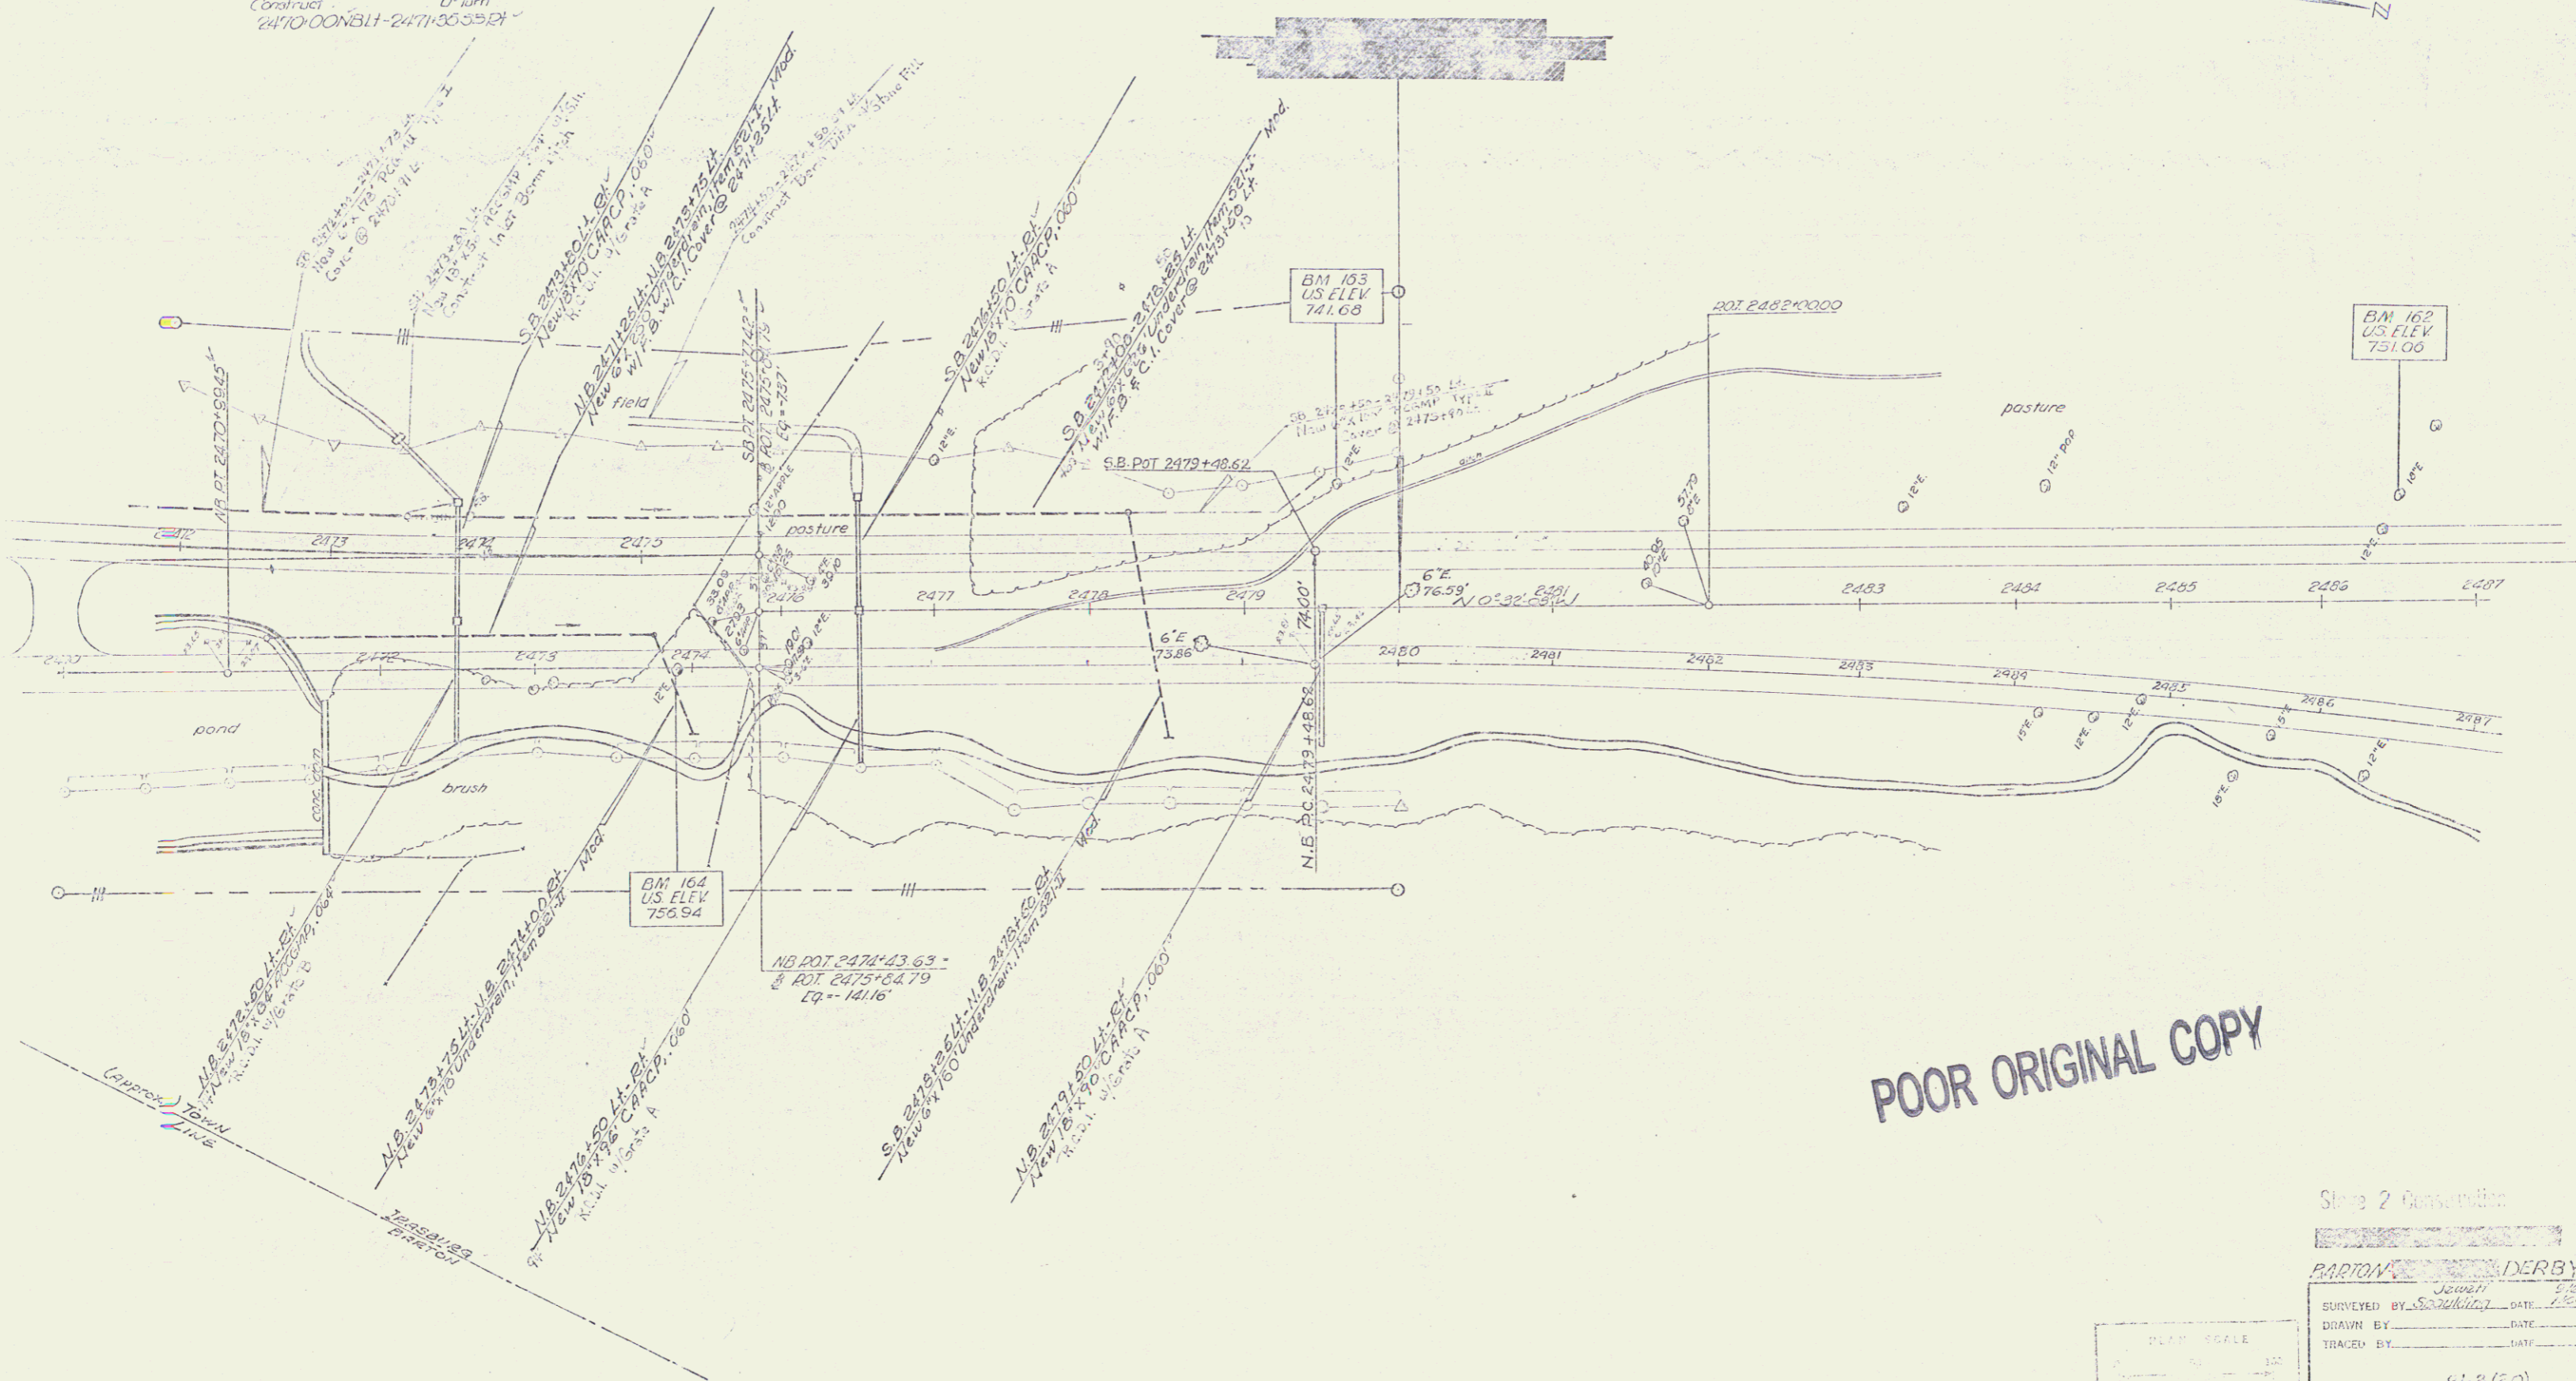

POOR ORIGINAL COPY

Sheet 2 of 4

PARTON		DERBY	
SURVEYED BY	DATE	DRAWN BY	DATE
TRACED BY	DATE		
PROJ. E.M.P. No. 54-3 (P.)			
SHEET 22 OF 118			
46	16		