


Sheet 11 for 191-3(16) ROW
 Station 2461+00 to 2461+30
 Station 2461+30 to 2461+65
 Station 2461+65 to 2461+94
 Station 2461+94 to 2462+25


Removal of Existing Present Guard Rail
 Item 100
 S.B. 2461+75 - 2462+00
 N.B. 2461+30 - 2461+65

Standard Steel Beam Guard Rail
 Item 100
 S.B. 2461+75 - 2462+00
 N.B. 2461+30 - 2461+65

Granite Slope Facing, Item 100
 S.B. 2461+75 - 2462+00
 N.B. 2461+30 - 2461+65

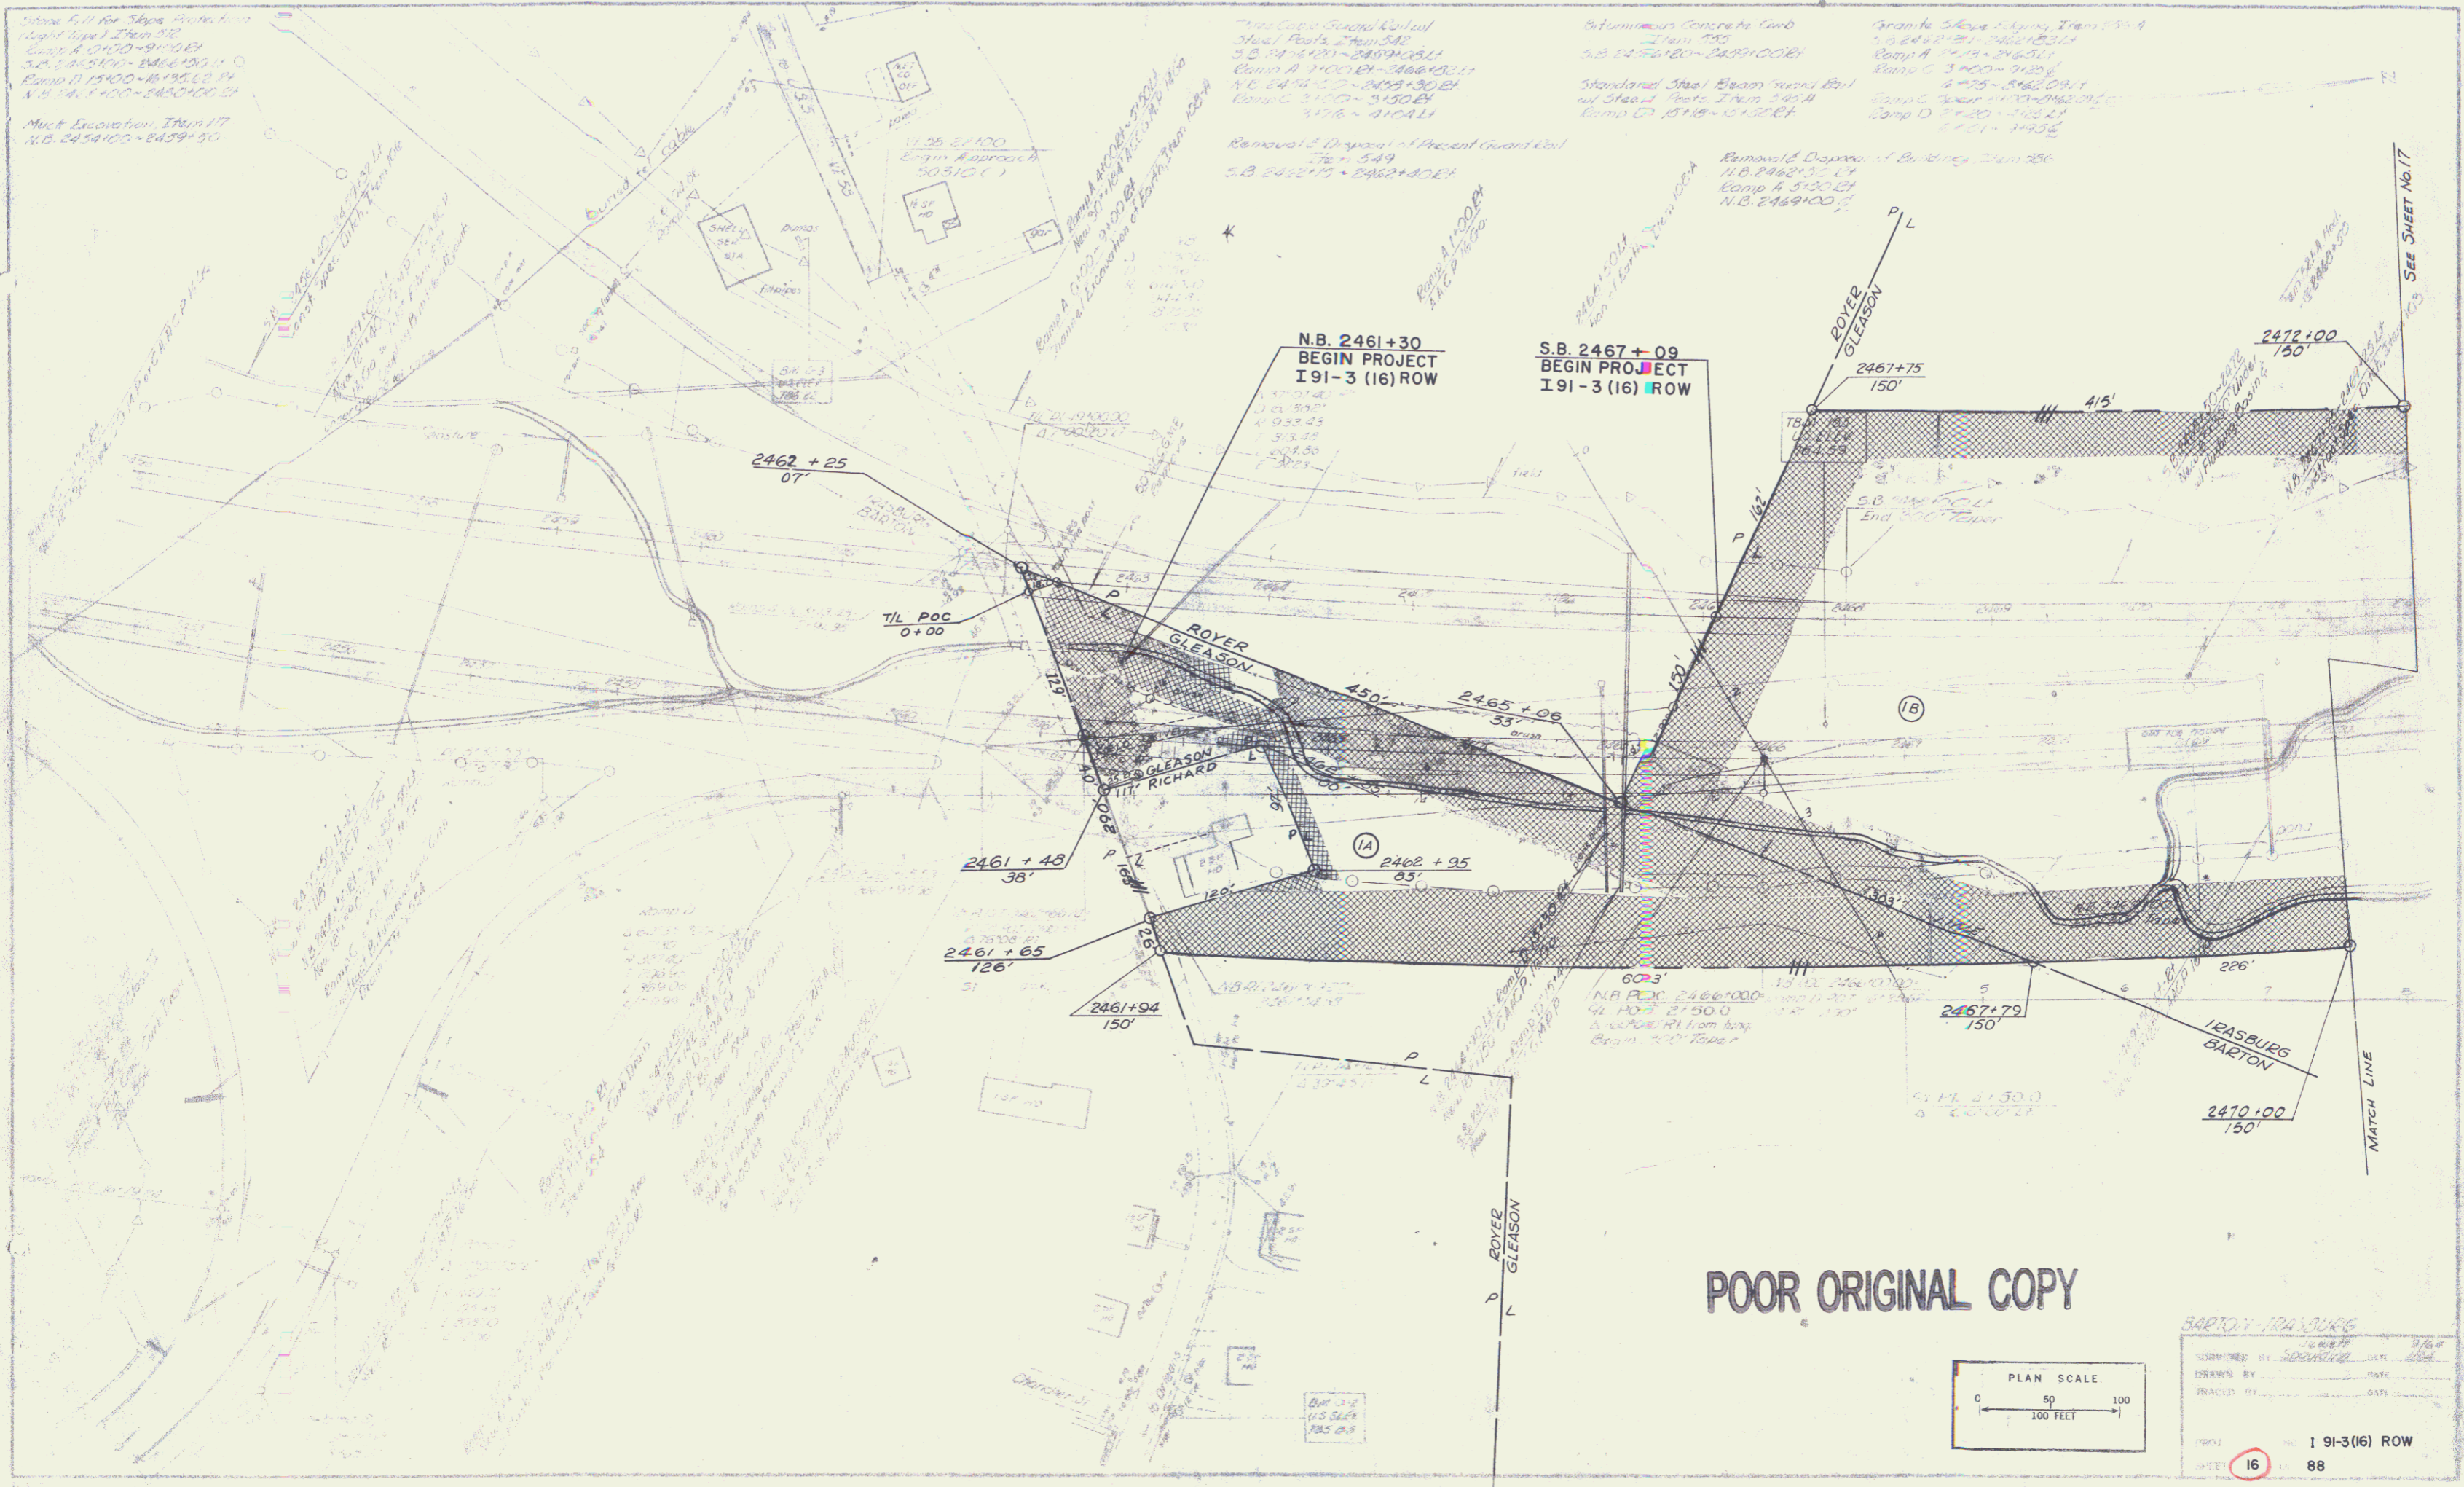

POOR ORIGINAL COPY

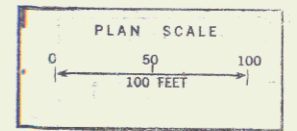

BARTON - LEASBURG	
DESIGNED BY	DATE
DRAWN BY	DATE
PROJECT	191-3(16) ROW
SHEET	16 OF 88