

Seeding Fertilizer Muck  
3059+00 - 3075+00 E 14.41

THREE CABLE GUARD RAIL  
with STEEL POSTS  
3064+28.14 - 3073+72.14  
105' - 31.7' + 38.4'


DRILLING & BLASTING of SOLID  
ROCK, SUBGRADE, ITEM III MOD.  
3071+66 - 3081+48  
35.0' - 31.0' + 40'

PROPERTY LINE FENCE w/ STEEL  
POSTS - MOD  
3071+70 - 3075+80 LA  
37.0' - 34.0' + 40'

EARL E & GLADYS M HACKETT

GRANTOR  
STATIONS  
TAKING  
TITLE TAKEN  
RECORDED

1810 BURNING  
3071+70 - 3073+80  
QUARRYING AND MINERAL RIGHTS

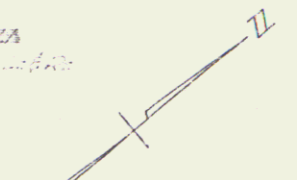

P.L. 3073+61.1 -  
3072+20.4

N.B. P.L. 3075+30.55 -  
3073+43.23

FLOYD L & JUNE M SHERLAW

TREES  
ACROSS

P.M. 50-A  
U.S. Elev.  
1070.13

P.M. 160-A  
U.S. Elev.  
1041.02

P.M. 50-A  
U.S. Elev.  
1039.00

P.M. 50-A  
U.S. Elev.  
1039.05



EARL E & GLADYS M HACKETT

Surveyline	Northbound	Southbound
$\Delta 42^{\circ}30'00''$	$\Delta 43^{\circ}52'55''$	$\Delta 44^{\circ}49'49''$
D 1'30"	D 1'45"	D 1'00"
E 3510.72	E 4583.05	E 3779.56
T 1293.03	T 1843.44	T 2363.23
L 2193.93	L 3510.56	L 4483.00
E 282.85	E 357.93	E 460.20
	Bank 1/2 per ft.	Bank 1/2 per ft.

DERBY  
Project E 91-3 (5)  
Surveyed by Spaulding  
Checked by Turner, Traced by [unclear]  
Sheet 18 of 153

JUL 11 1974

4