

PLANK GUARD RAIL w/ PRESERVATIVE TREATMENT
 TR #16 8+50
 TR #16 11+50
 TR #39 31+00
 Seeding Fertilizer Mulch
 3075+00 - 3077+00 ULRH

PROPERTY LINE FENCE w/ STEEL
 POSTS - 1800
 3080+00 - 3090+00 LA
 3080+00 - 3070+00 RB
 3070+00 - 3080+00 LA

B.M. 54
 U.S. Elev.
 1070.24

FLOYD L & JUNE M SHERLAW

SHIRLEY H & EVELYN WALLACE

PARCEL STATIONS TAKING
 1 C
 3075+05 - 3080+93±
 3.6 A± L.A.

P.O.T. 11+41.0 Side Line
 0+100 C Line Δ 133° 30' 21"

PARCEL STATIONS TAKING
 8 A
 308+40 - 312+91±
 2.5 A± L.A.

B.M. 54
 U.S. Elev.
 1070.24


PARCEL STATIONS TAKING
 8 A, B
 SHIRLEY H & EVELYN WALLACE
 309+22 - 312+91±
 2.8 ± L.A.
 1.8 ± L.A.
 CULVERT
 TITLE TAKEN
 RECORDED
 STA. 3089+50, 3097+00, 3107+52± NB
 WD. 2/10/61
 DERBY - BK 52 - PG 375-F - 2/1/76

B.M. 56
 U.S. Elev.
 1092.76

TREE ACROSS
 NOT FR.

P.O.C. 3077+00.0

(SURPLUS - 2.7 A±)

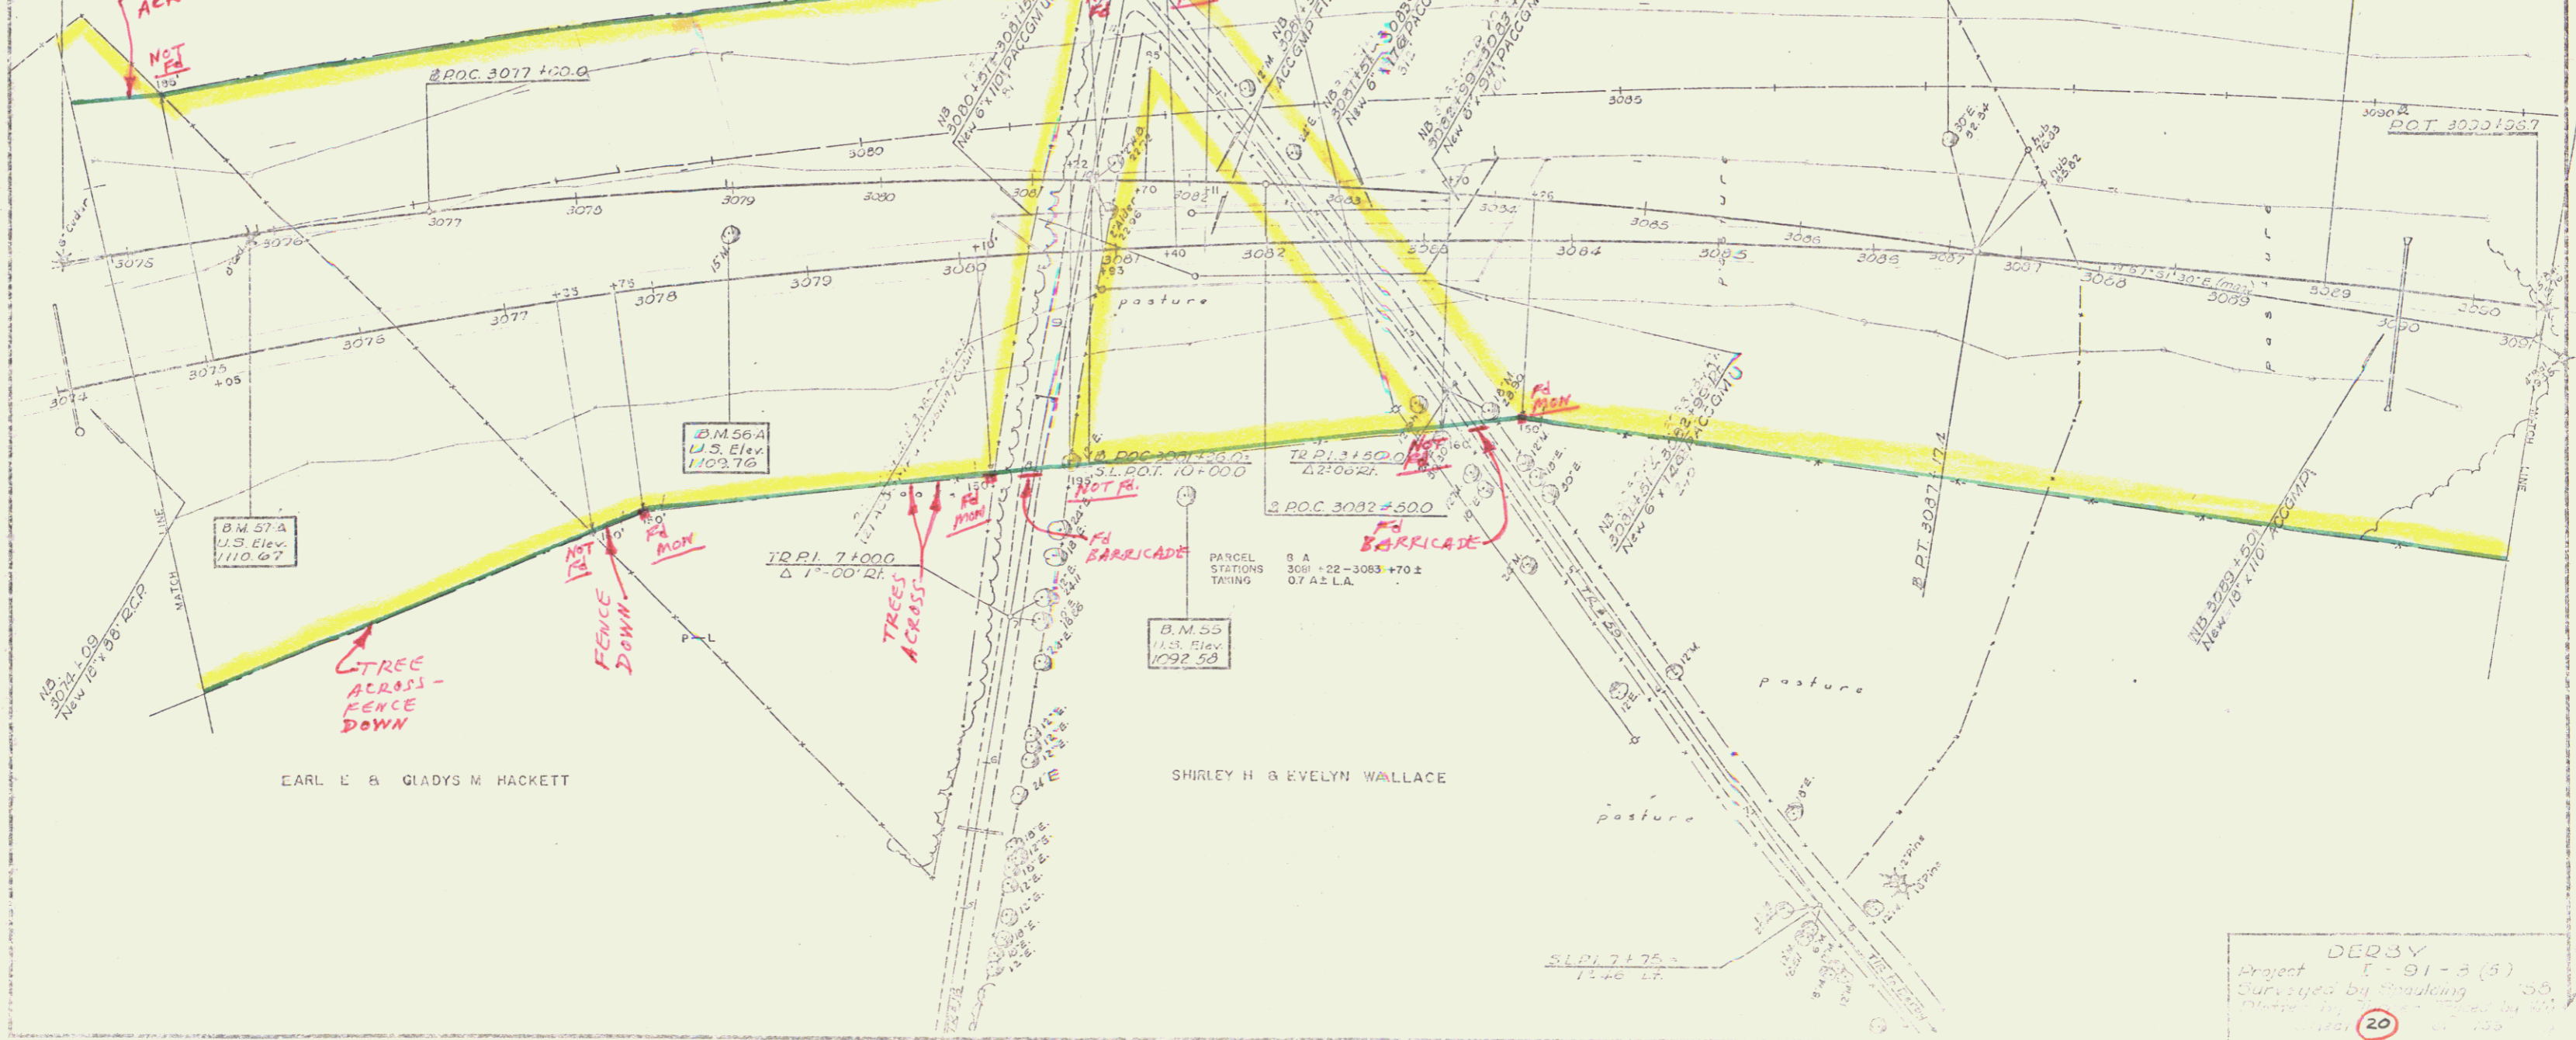

B.M. 57
 U.S. Elev.
 1110.67

EARL E & GLADYS M HACKETT

B.M. 55
 U.S. Elev.
 1092.58

SHIRLEY H & EVELYN WALLACE

P.O.C. 3082+50.0

DERBY
 Project F-91-3(5)
 Surveyed by [unclear]
 20

JUL 11 1974 5