


Seeding, Fertilizer, Muck
3091+00 - 3107+00 L&R

SPECIAL DITCH - ITEM 103-A
NB 3096+50 Rt - 3104+51 Rt

PROPERTY LINE FENCE w/ STEEL POSTS - MOD
3094+50 - 3106+00 RA

SHIRLEY H & EVELYN WALLACE

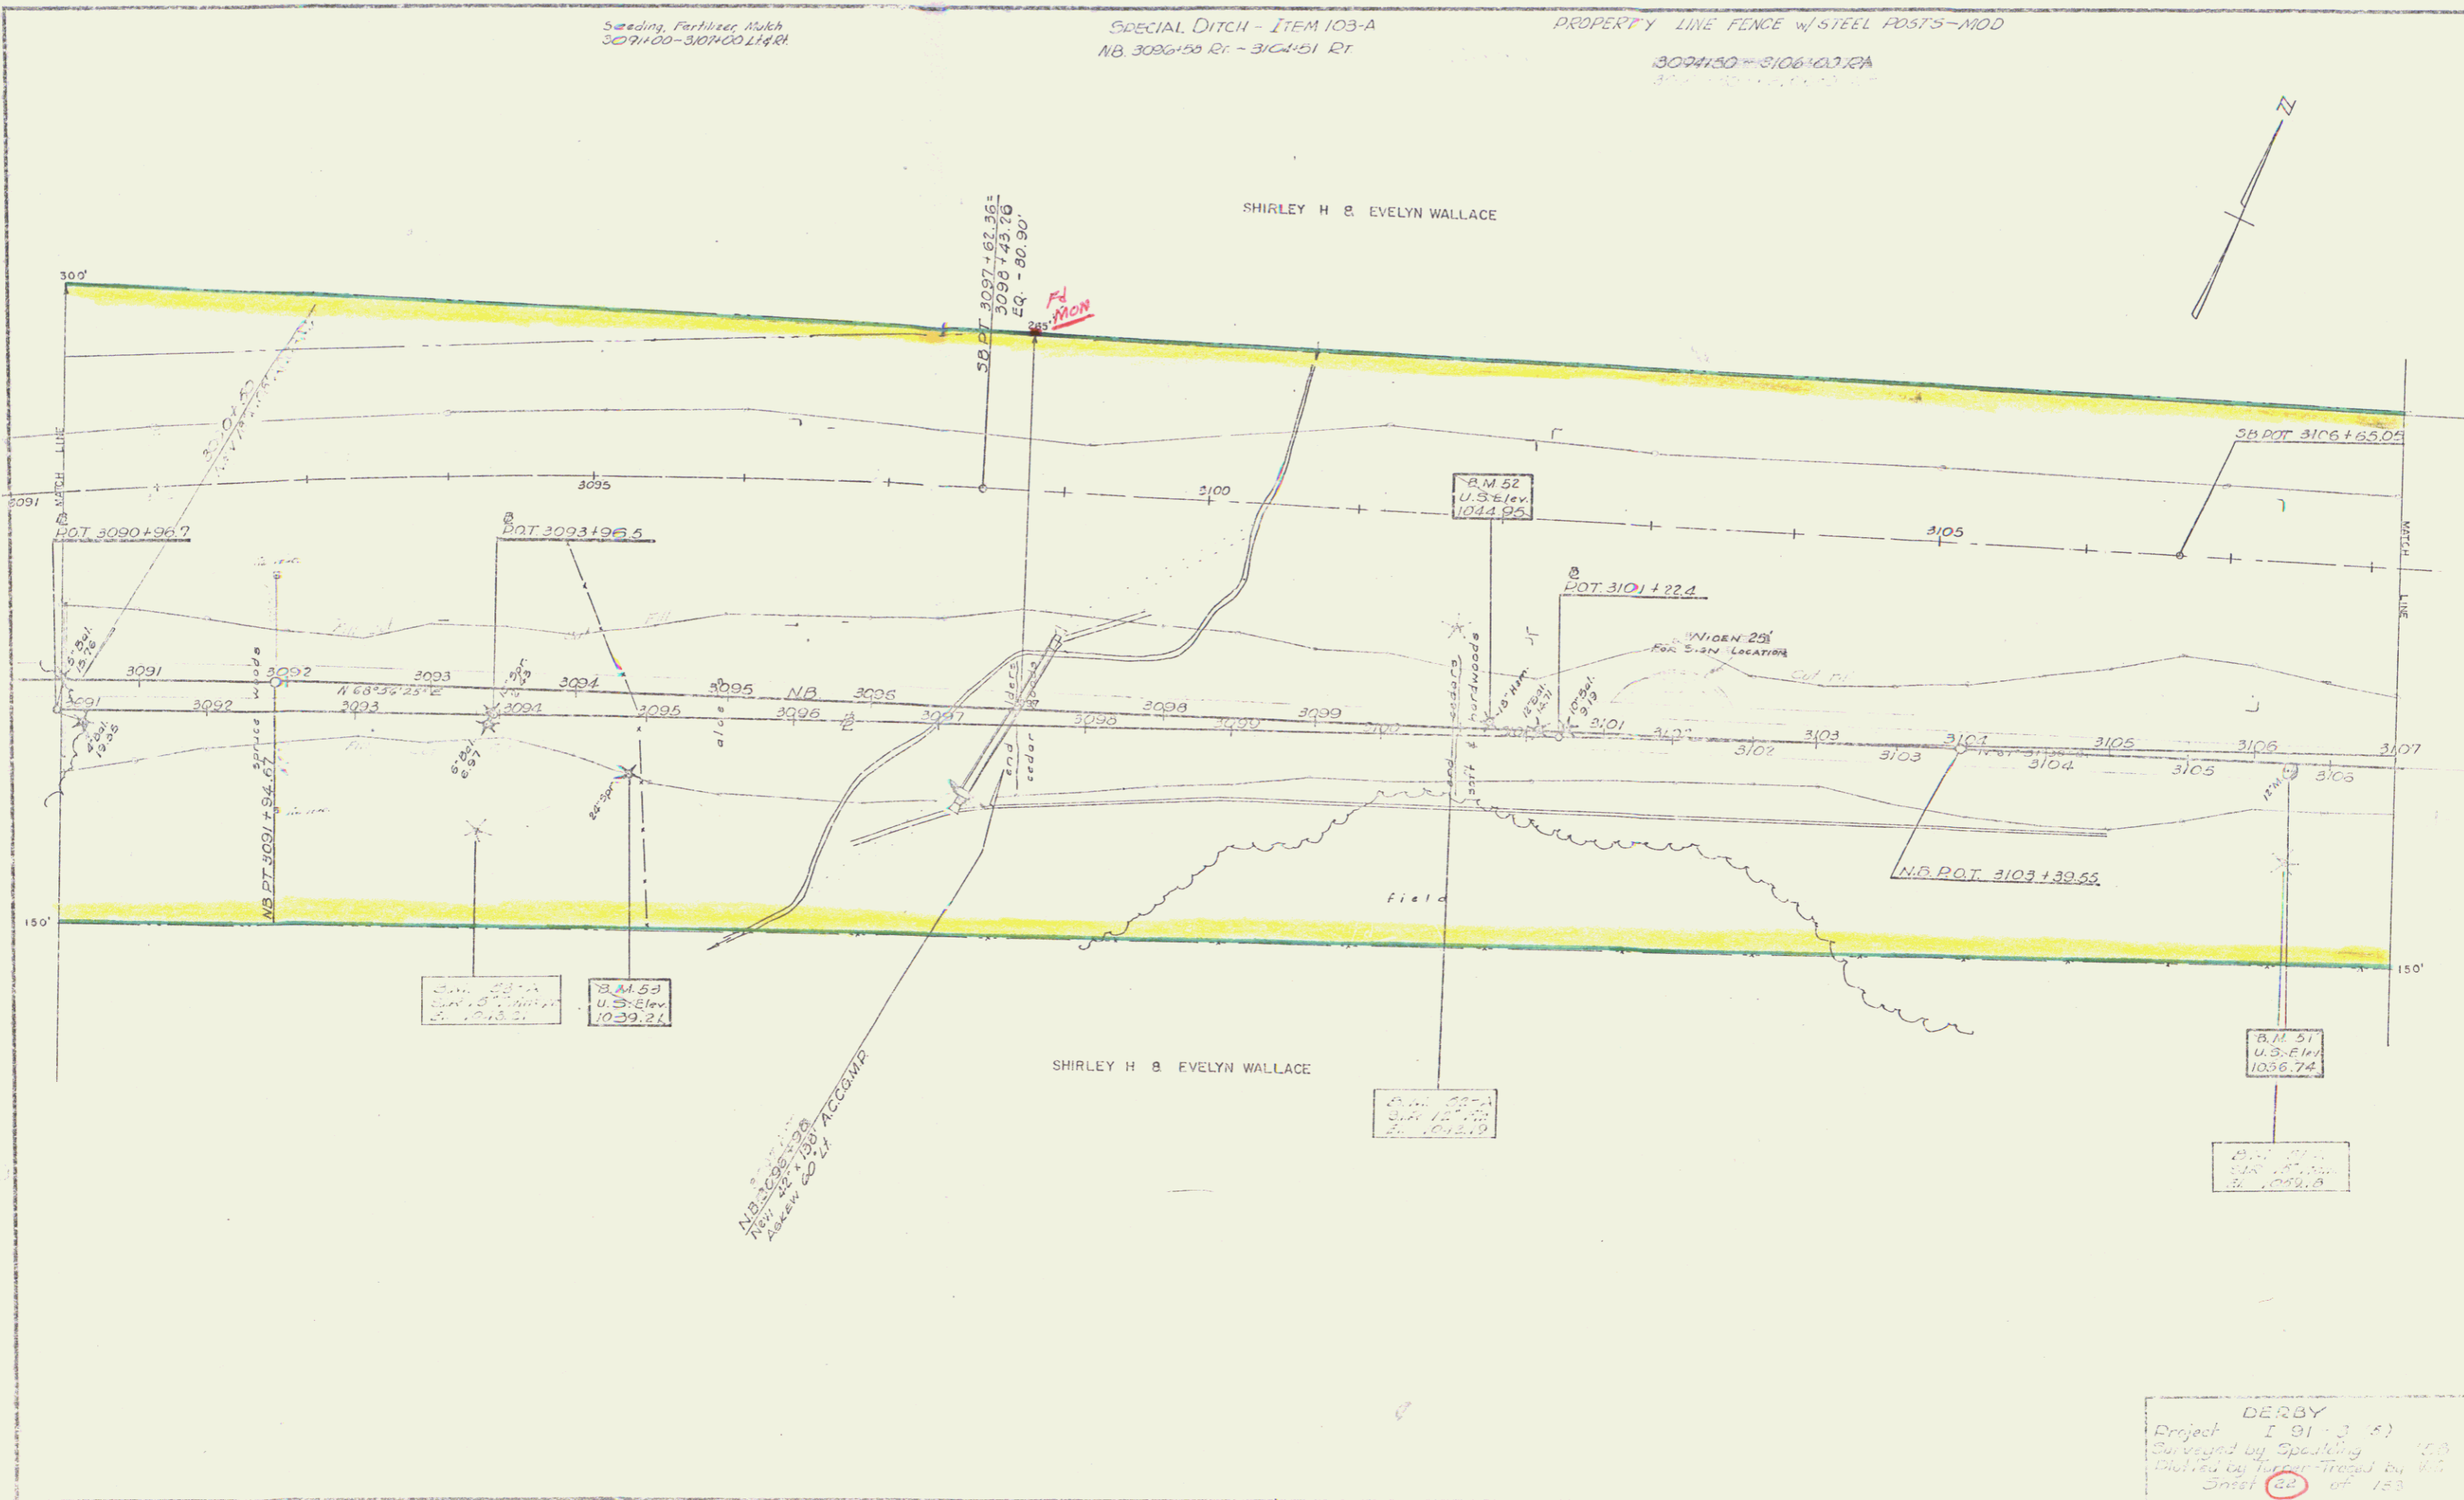

DERBY
 Project I 91-3-5
 Surveyed by Spedding 100
 Checked by Turner/Treadwell 100
 Dated 6/20/74
 Sheet 60 of 153

JUL 11 1974

6