
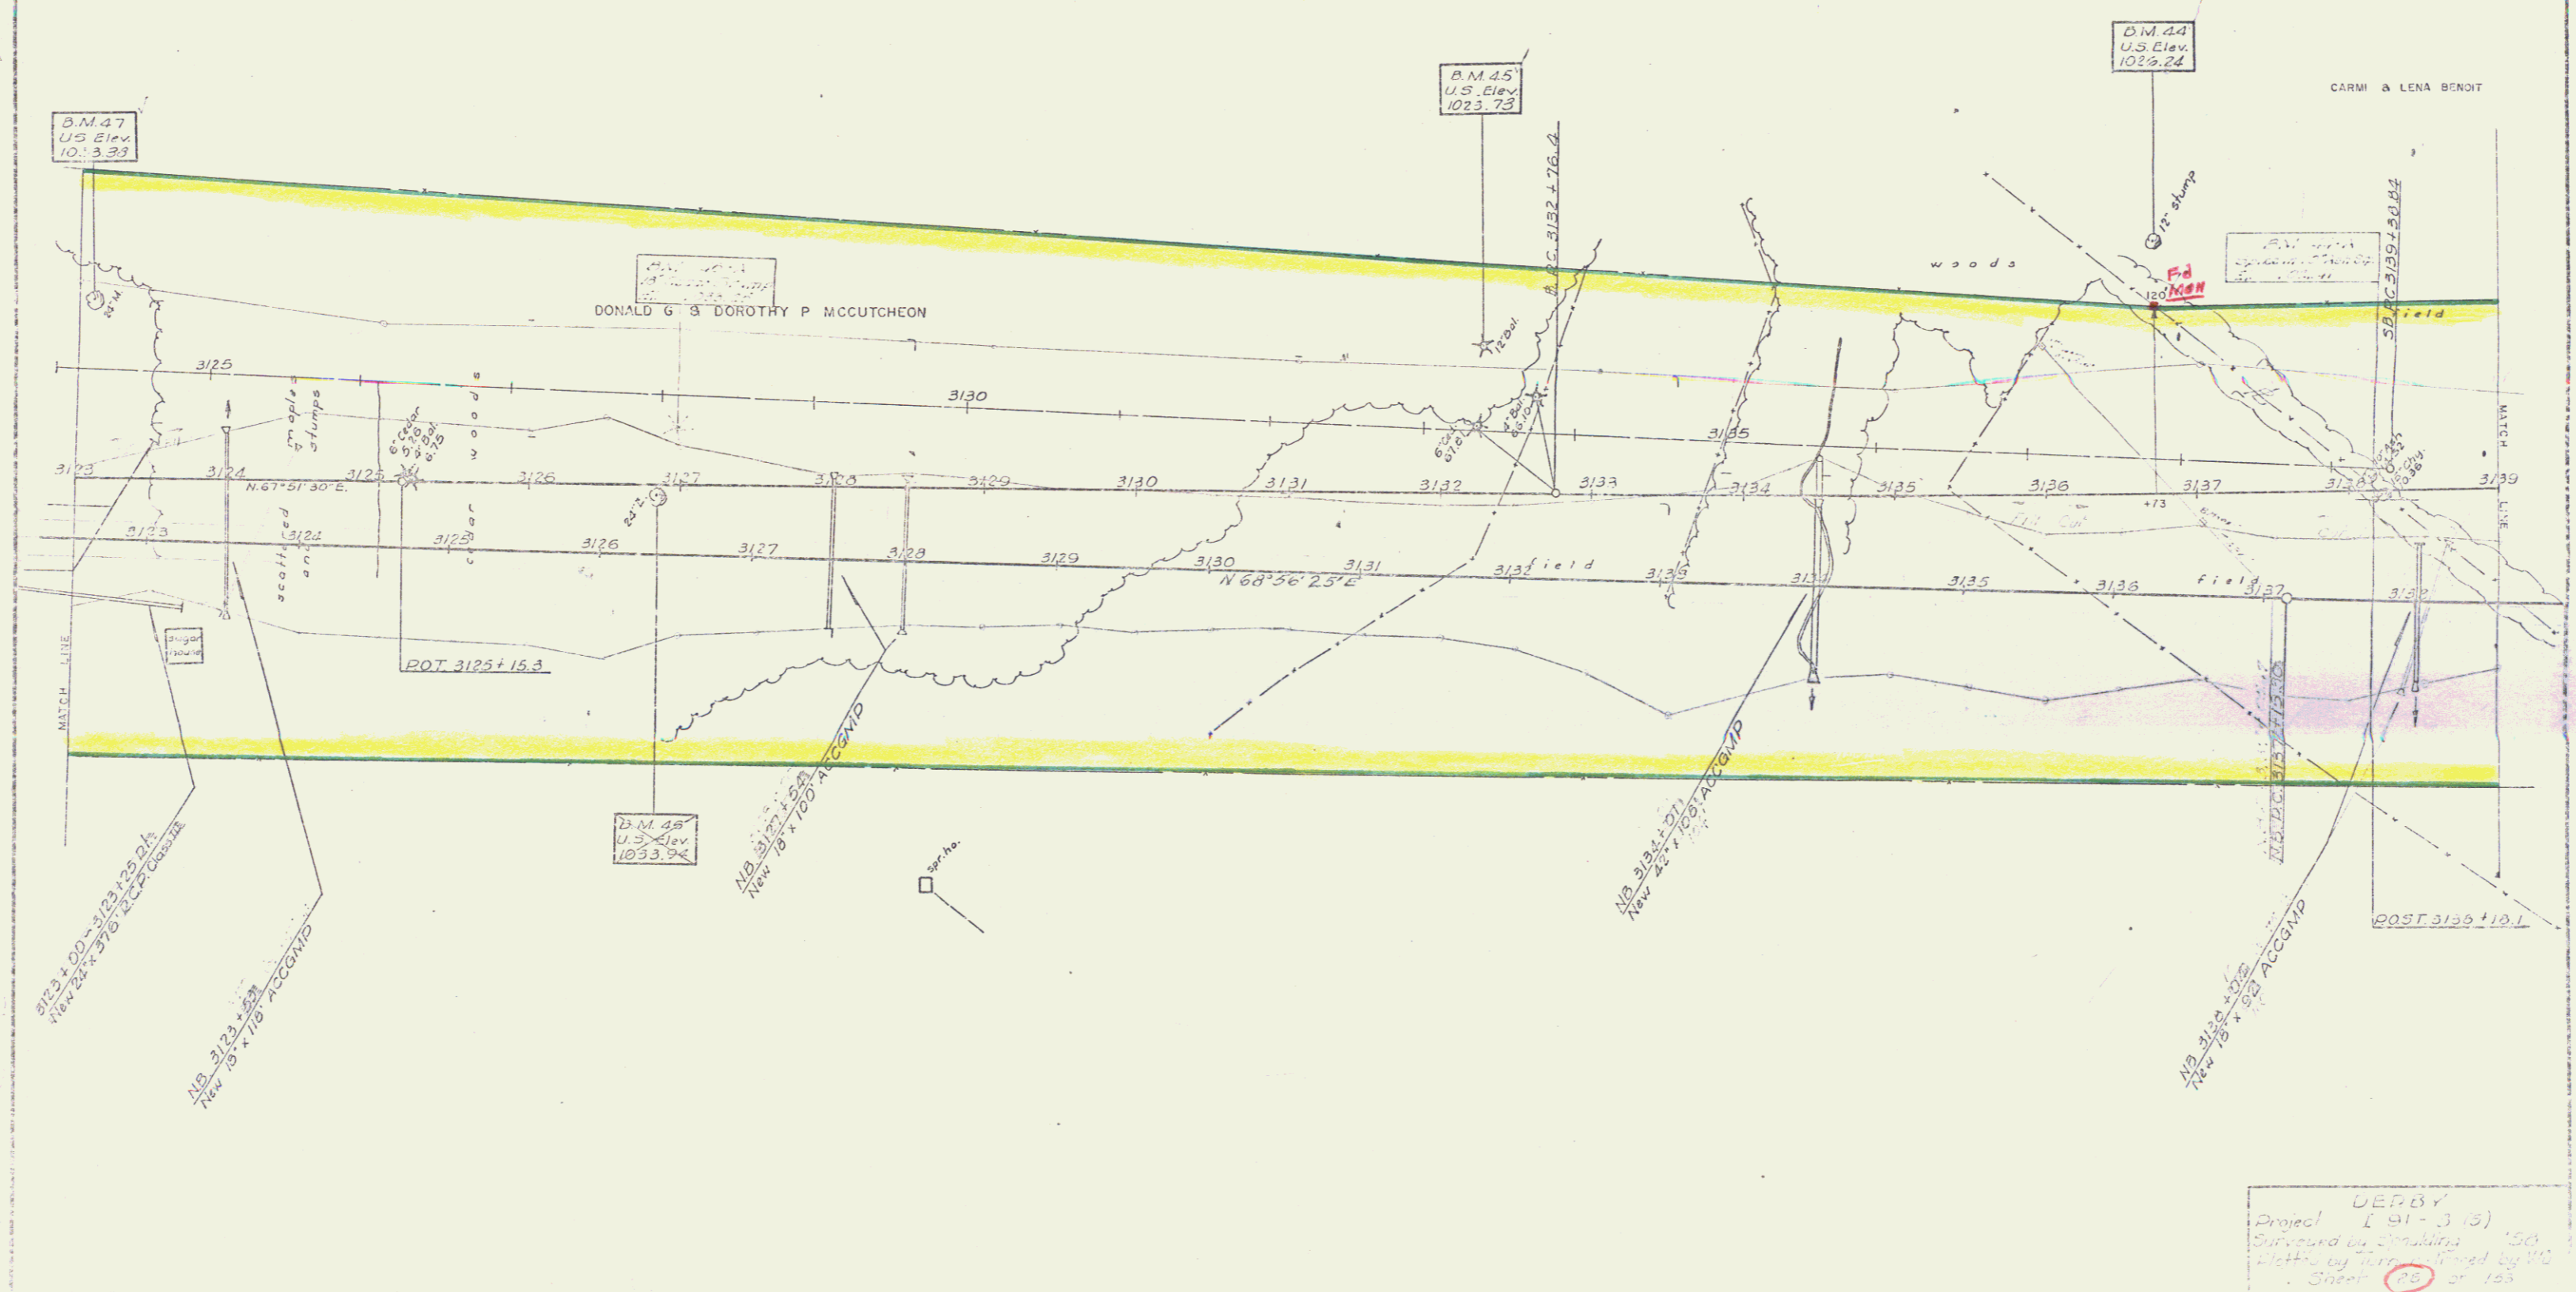


PARCEL GRANTOR IOA DONALD G. & DOROTHY P. MCCUTCHEON
Demolition & Removal of Building
3123+25 Rt

Seeding Fertilizer Mutch
3123+00 - 3139+00 11.4 Rt

THREE CABLE GUARD RAIL
with STEEL POSTS
3133+35 Lf - 3134+67 Lf
3133+37 Rt - 3135+13 Rt

PROPERTY LINE FENCE w/ STEEL
POSTS - Med
3123+00 - 3134+00 RT
3132+00 - 3139+00 LF

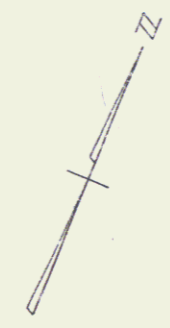

CARM & LENA BENDIT

DEPBY
Project 91-313
Surveyed as Contiguous
Plotted by [unclear] [unclear] by [unclear]
Sheet 26 of 123

JUL 11 1974