


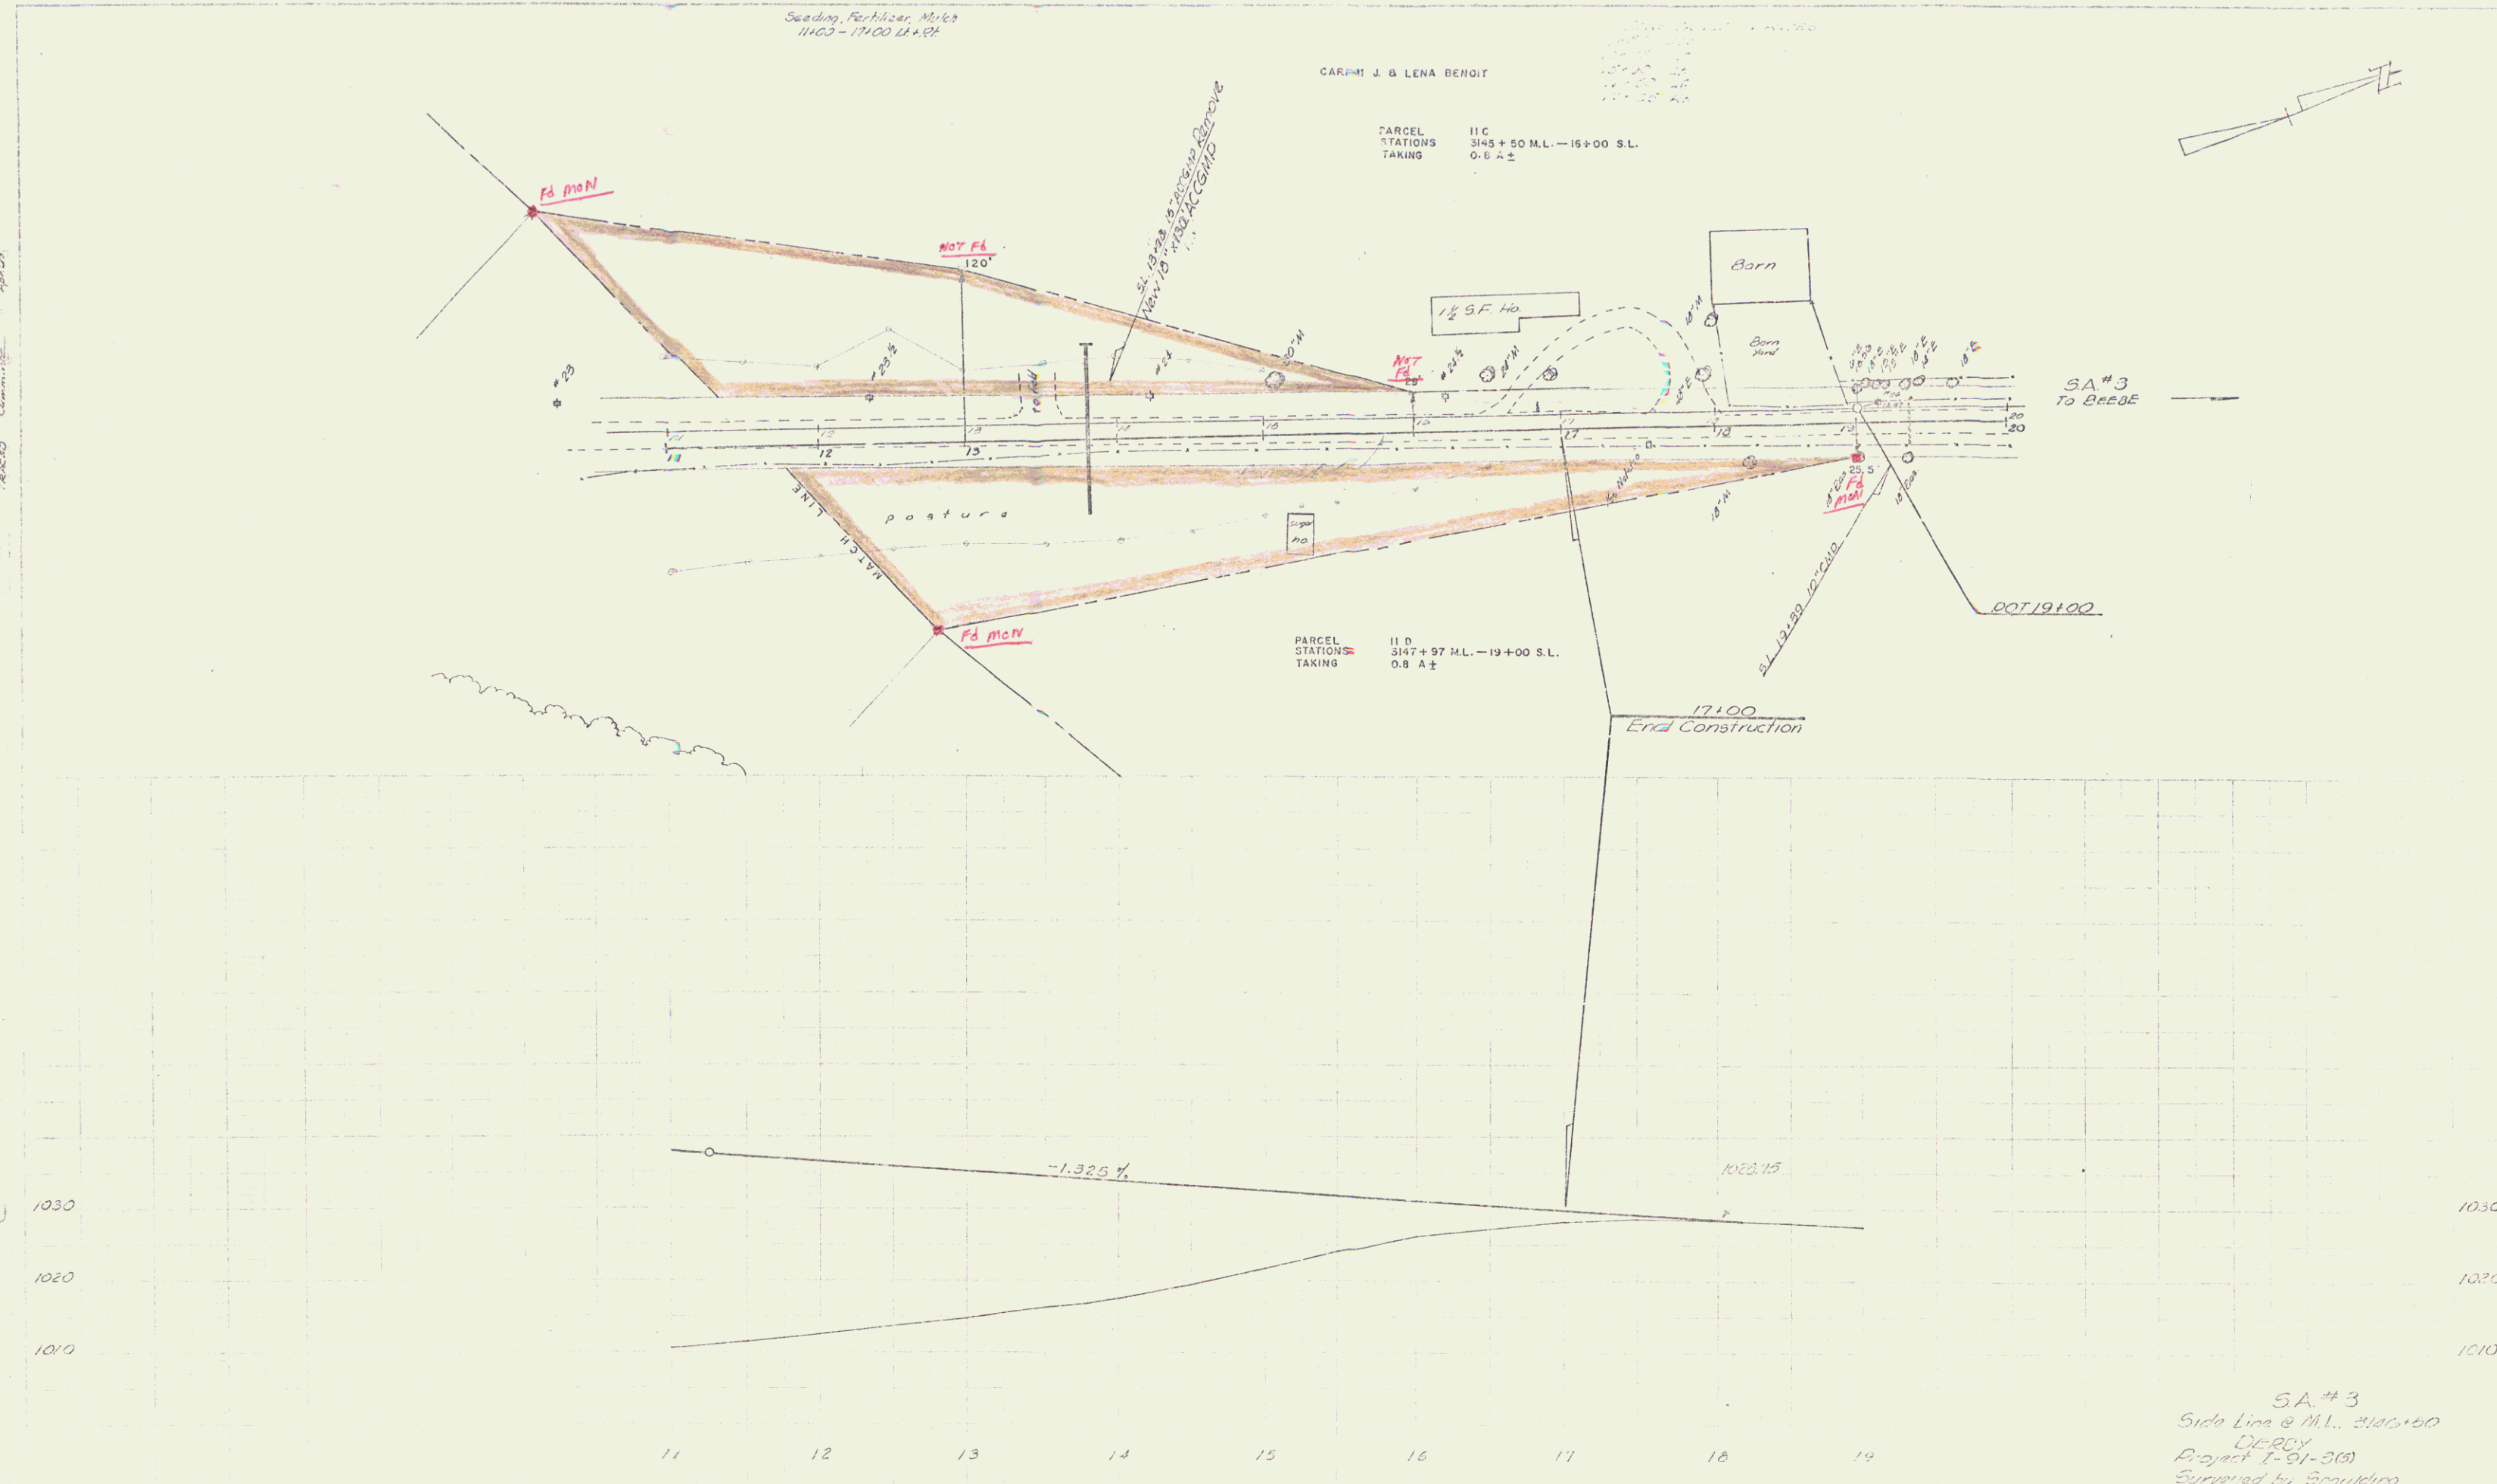

SA #3
Side Line & M.L. 3140+50
DE-ROY
Project I-91-3(9)
Surveyed by Spradling
10/1/73
Checked by [Signature]
JUL 11 1974

12