

CARRI J. & LENA L. BENOIT


PROPERTY LINE FENCE
W/STEEL POSTS AND ITEM 30.3-A
3154+00 - 3171+00 RL
3154+00 - 3171+00 LL

THREE CABLE GUARD RAIL
with STEEL POSTS
50
3164+40 LL - 3171+00 LL
3164+55 RL - 3171+00 RL
3164+58

Southbound
Δ 4°43'30" Rt.
D 0'30"
T 11,459.16
L 482.00
E 965.0
L 10.17
Bnk. R.C.

PARCEL 12
GRANTOR WILLIAM & MARY JOHNSTON
STATIONS 3160+00 - 3164+25.1
TAKING 0.5 A2
REMAINDER 64.4 A2
RIGHTS NONE
TITLE TAKEN NO. 10728/50
RECORDED DERBY - PG 52 - PG 342-3 - 11/9/60

PARCEL 9
STATIONS 3158+00 - 3180+60
TAKING 15.1 A1

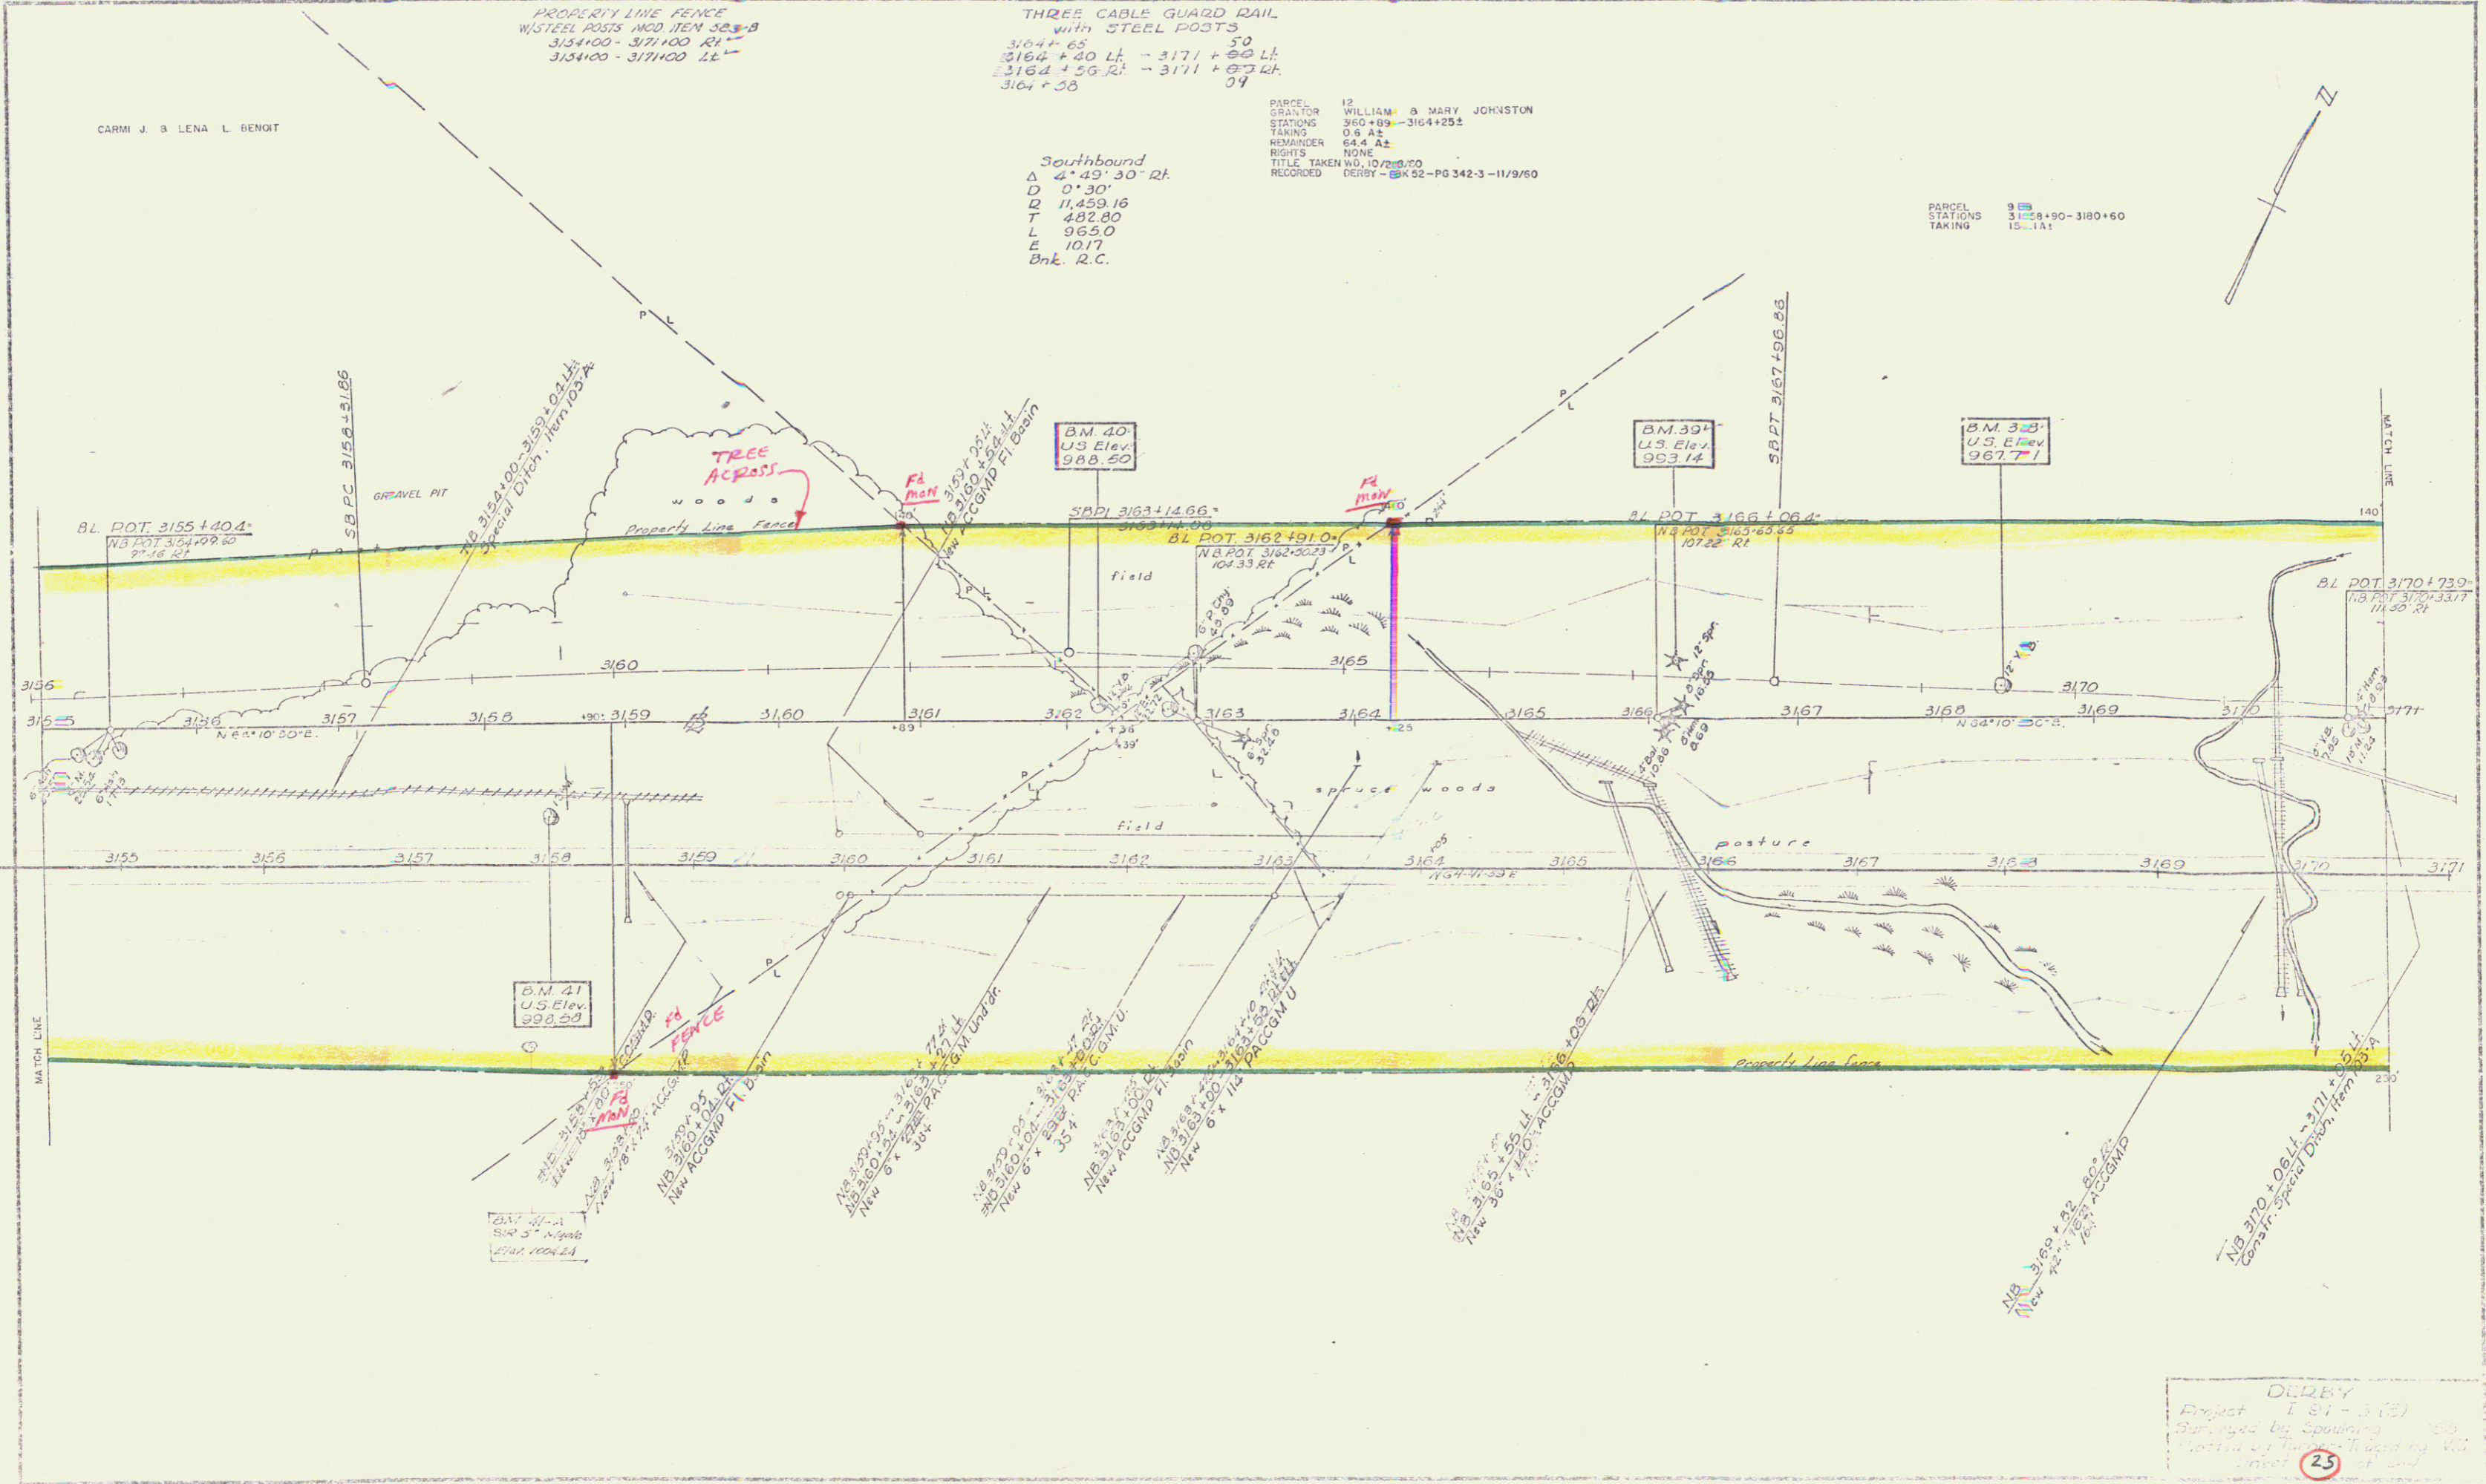

DERBY
Project I 81-3 (2)
Designed by Spawing
Checked by T. J. ...
13
25

JUL 11 1974