

NOTE - EXACT LOCATION & SCHEDULING OF UTILITIES - AS DIRECTED BY THE ENGINEER.

CONSTRUCT APPROACH  
15+19 LI  
DRILLING & BLASTING OF SOLID ROCK  
SUBGRADE - ITEM 114 MOD.  
10+00 - 11+00  
12+50 - 21+00


PARCEL 16  
GRANTOR: WYNN N AMES  
STATIONS: 19+55 - 24+41  
TAKING: U.S.A.  
REMAINDER: U.S.A.  
RIGHTS: U.S.A.  
TITLE TAKEN: U.S.A.  
RECORDED: WYNN N AMES - BK 52 - PG 334-5 - 11/18/60

PARCEL 17  
GRANTOR: DERBY FISH AND GAME CLUB  
STATIONS: 15+00 - 19+59  
TAKING: 0.24 ±  
REMAINDER: 34.0 ±  
RIGHTS: 15' ±  
TITLE TAKEN: DERBY - BK 52 - PG 334-5 - 10/29/60

A 35° 28' 00" R/L  
D 3' 00"  
R 1900.26  
T 61.74'  
L 1138.22'  
E 95° 23'  
Bk: 7/15 per ft.

U.S. ROUTE # 5 STA 22+8632 = 23+1520  
END CONSTRUCTION

EQUATION  
-23.88'

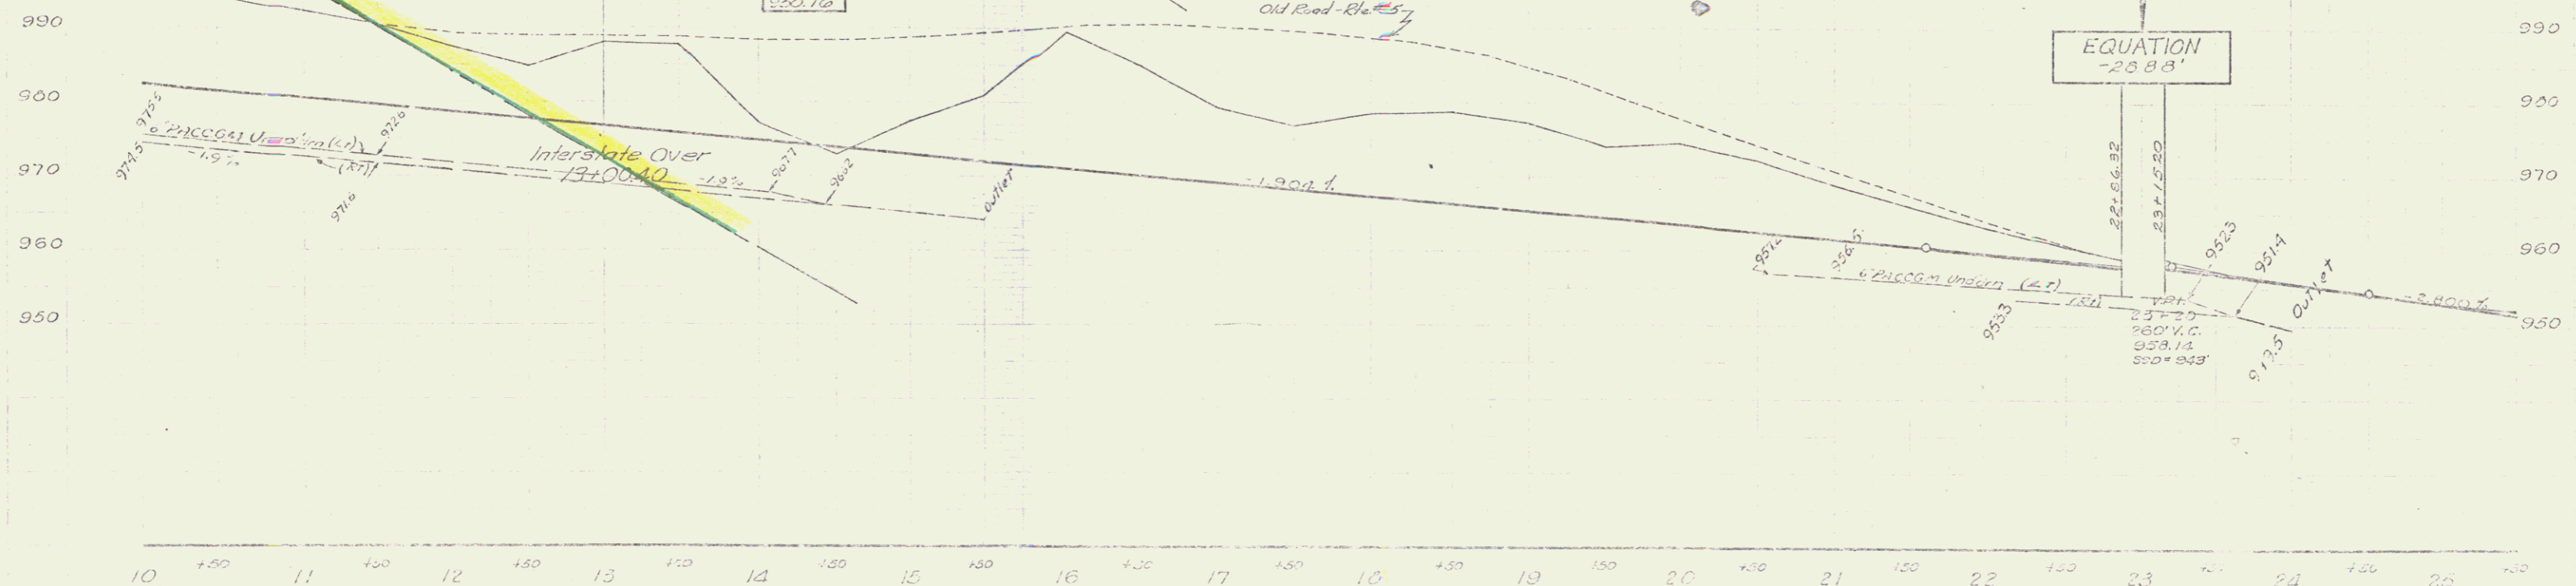

DERBY - U.S. 5  
3 (S)  
34  
JUL 11 1974