

DRILLING AND BLASTING OF SOLID ROCK SUBGRADE ITEM 115
 N.B. 2915+00-2921+00 LF
 S.B. 2914+00-2922+75 LF

SUBBASE OF SAND ITEM 202
 N.B. 2920+00-2922+50
 S.B. 2915+00-2916+25
 * TREATED TIMBER CURB ITEM 353
 N.B. 2926+00-2929+00 LF
 N.B. 2927+00-2931+00 LF
 S.B. 2928+75-2931+00 LF

* THREE CABLE GUARD RAIL W/ * STANDARD STEEL BEAM GUARD RAIL W/ STEEL POSTS ITEM 522
 N.B. 2925+00-2931+00 LF
 N.B. 2926+46-2929+00 LF
 S.B. 2926+56-2931+00 LF
 N.B. 2916+75-2918+29 LF
 S.B. 2917+00-2919+34 LF
 S.B. 2917+00-2919+34 LF



GRAVEL BACKFILL FOR SLOPE STABILIZATION Item 222 A
 S.B. 2918+00-2922+80 LF

SUB-BASE OF SAND ITEM 202
 S.B. 2922+50-2924+50

SELECTIVE THINNING AND TRIMMING ITEM 601
 S.B. 2915+00-2916+75 LF
 S.B. 2922+50-2931+00 LF
 S.B. 2915+00-2931+00 LF
 N.B. 2915+00-2929+10 LF

PROPERTY LINE FENCE, Item 533-Z, Mod.
 S.B. 2923+75-2931+00 LF
 N.B. 2920+50-2931+00 LF

* STAGE 2 CONSTRUCTION

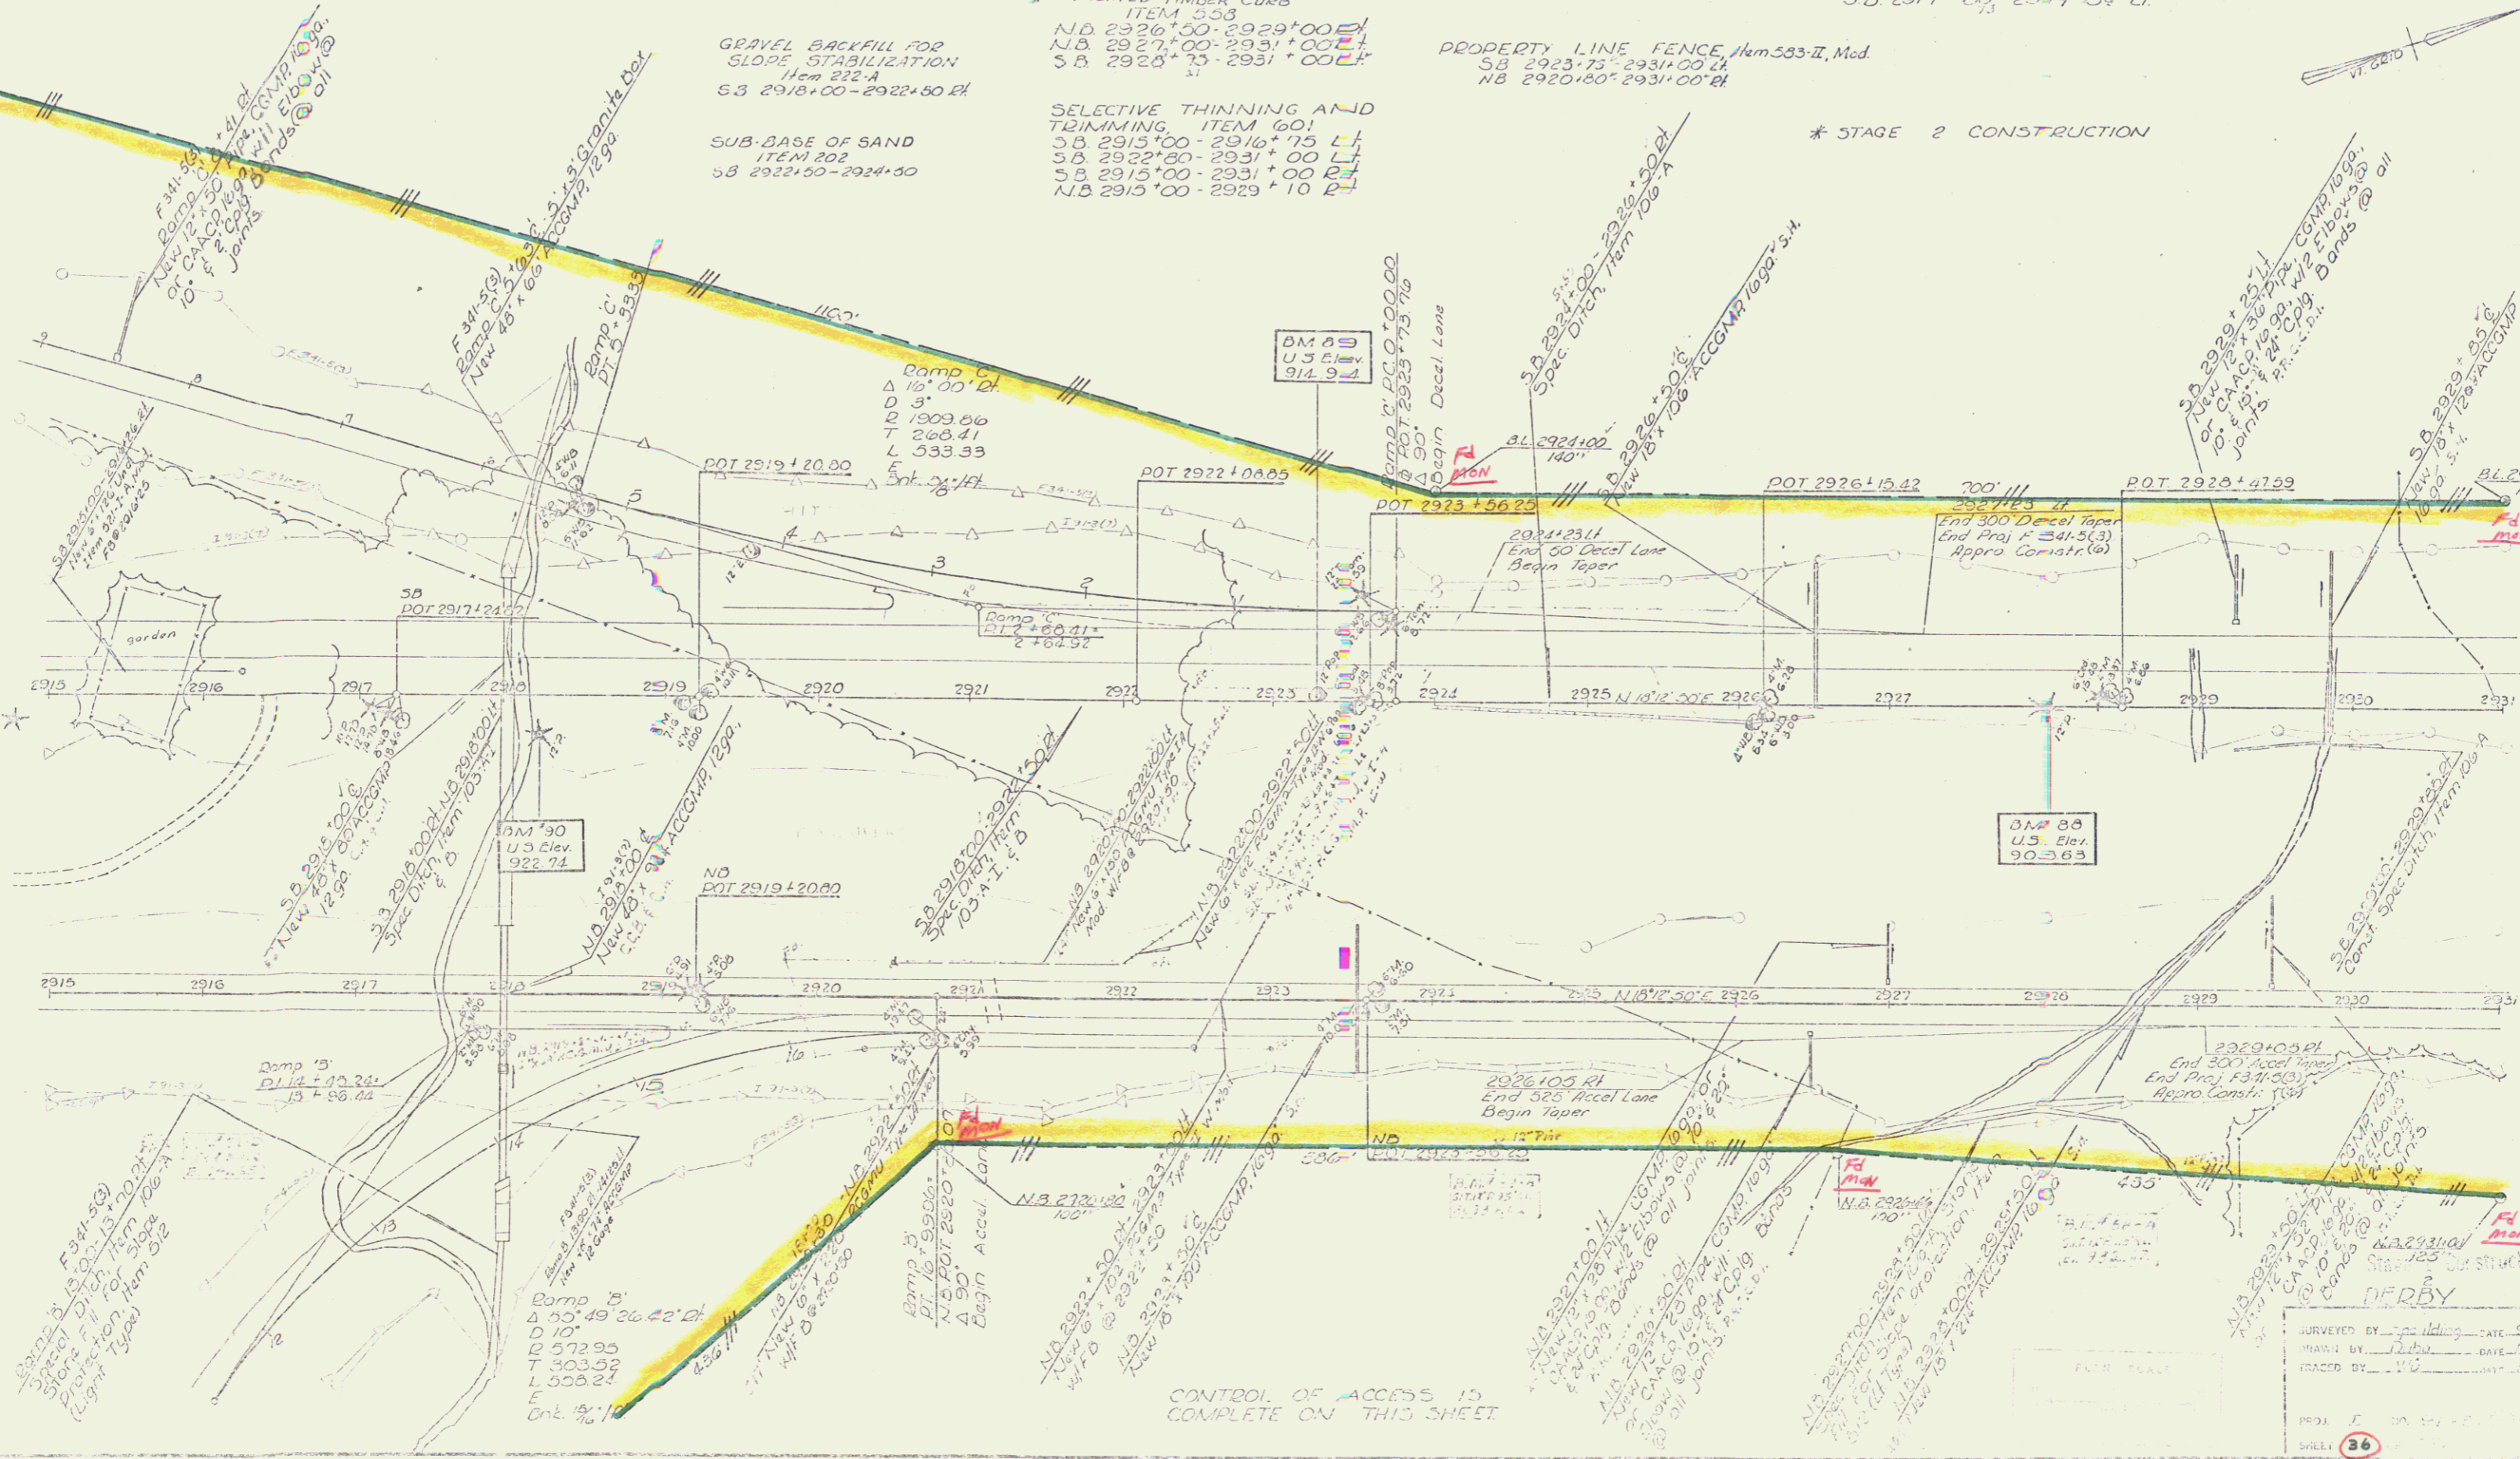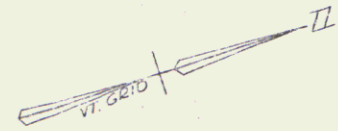

CONTROL OF ACCESS IS COMPLETE ON THIS SHEET.

SURVEYED BY: [Signature] DATE: 6/10/74
 DRAWN BY: [Signature] DATE: 6/10/74
 TRACED BY: [Signature] DATE: 6/10/74
 PROJ: [Blank]
 SHEET: 36
 30



JUL 11 1974 2

Seeding, Fertilizer, Mulk
3043+00 - 3059+00 11/4 RT

THREE CABLE GUARD RAIL
with STEEL POSTS
3043+00 - 3046+22.11 3046+11.11 L
3043+00 - 3043+16 RT
F35

PROPERTY LINE FENCE w/ STEEL POSTS Mod
3043+00 - 3055+00 IA 3043+00 L
3043+00 - 3056+00 RA 3043+00 R

EARL E & GLADYS M HACKETT

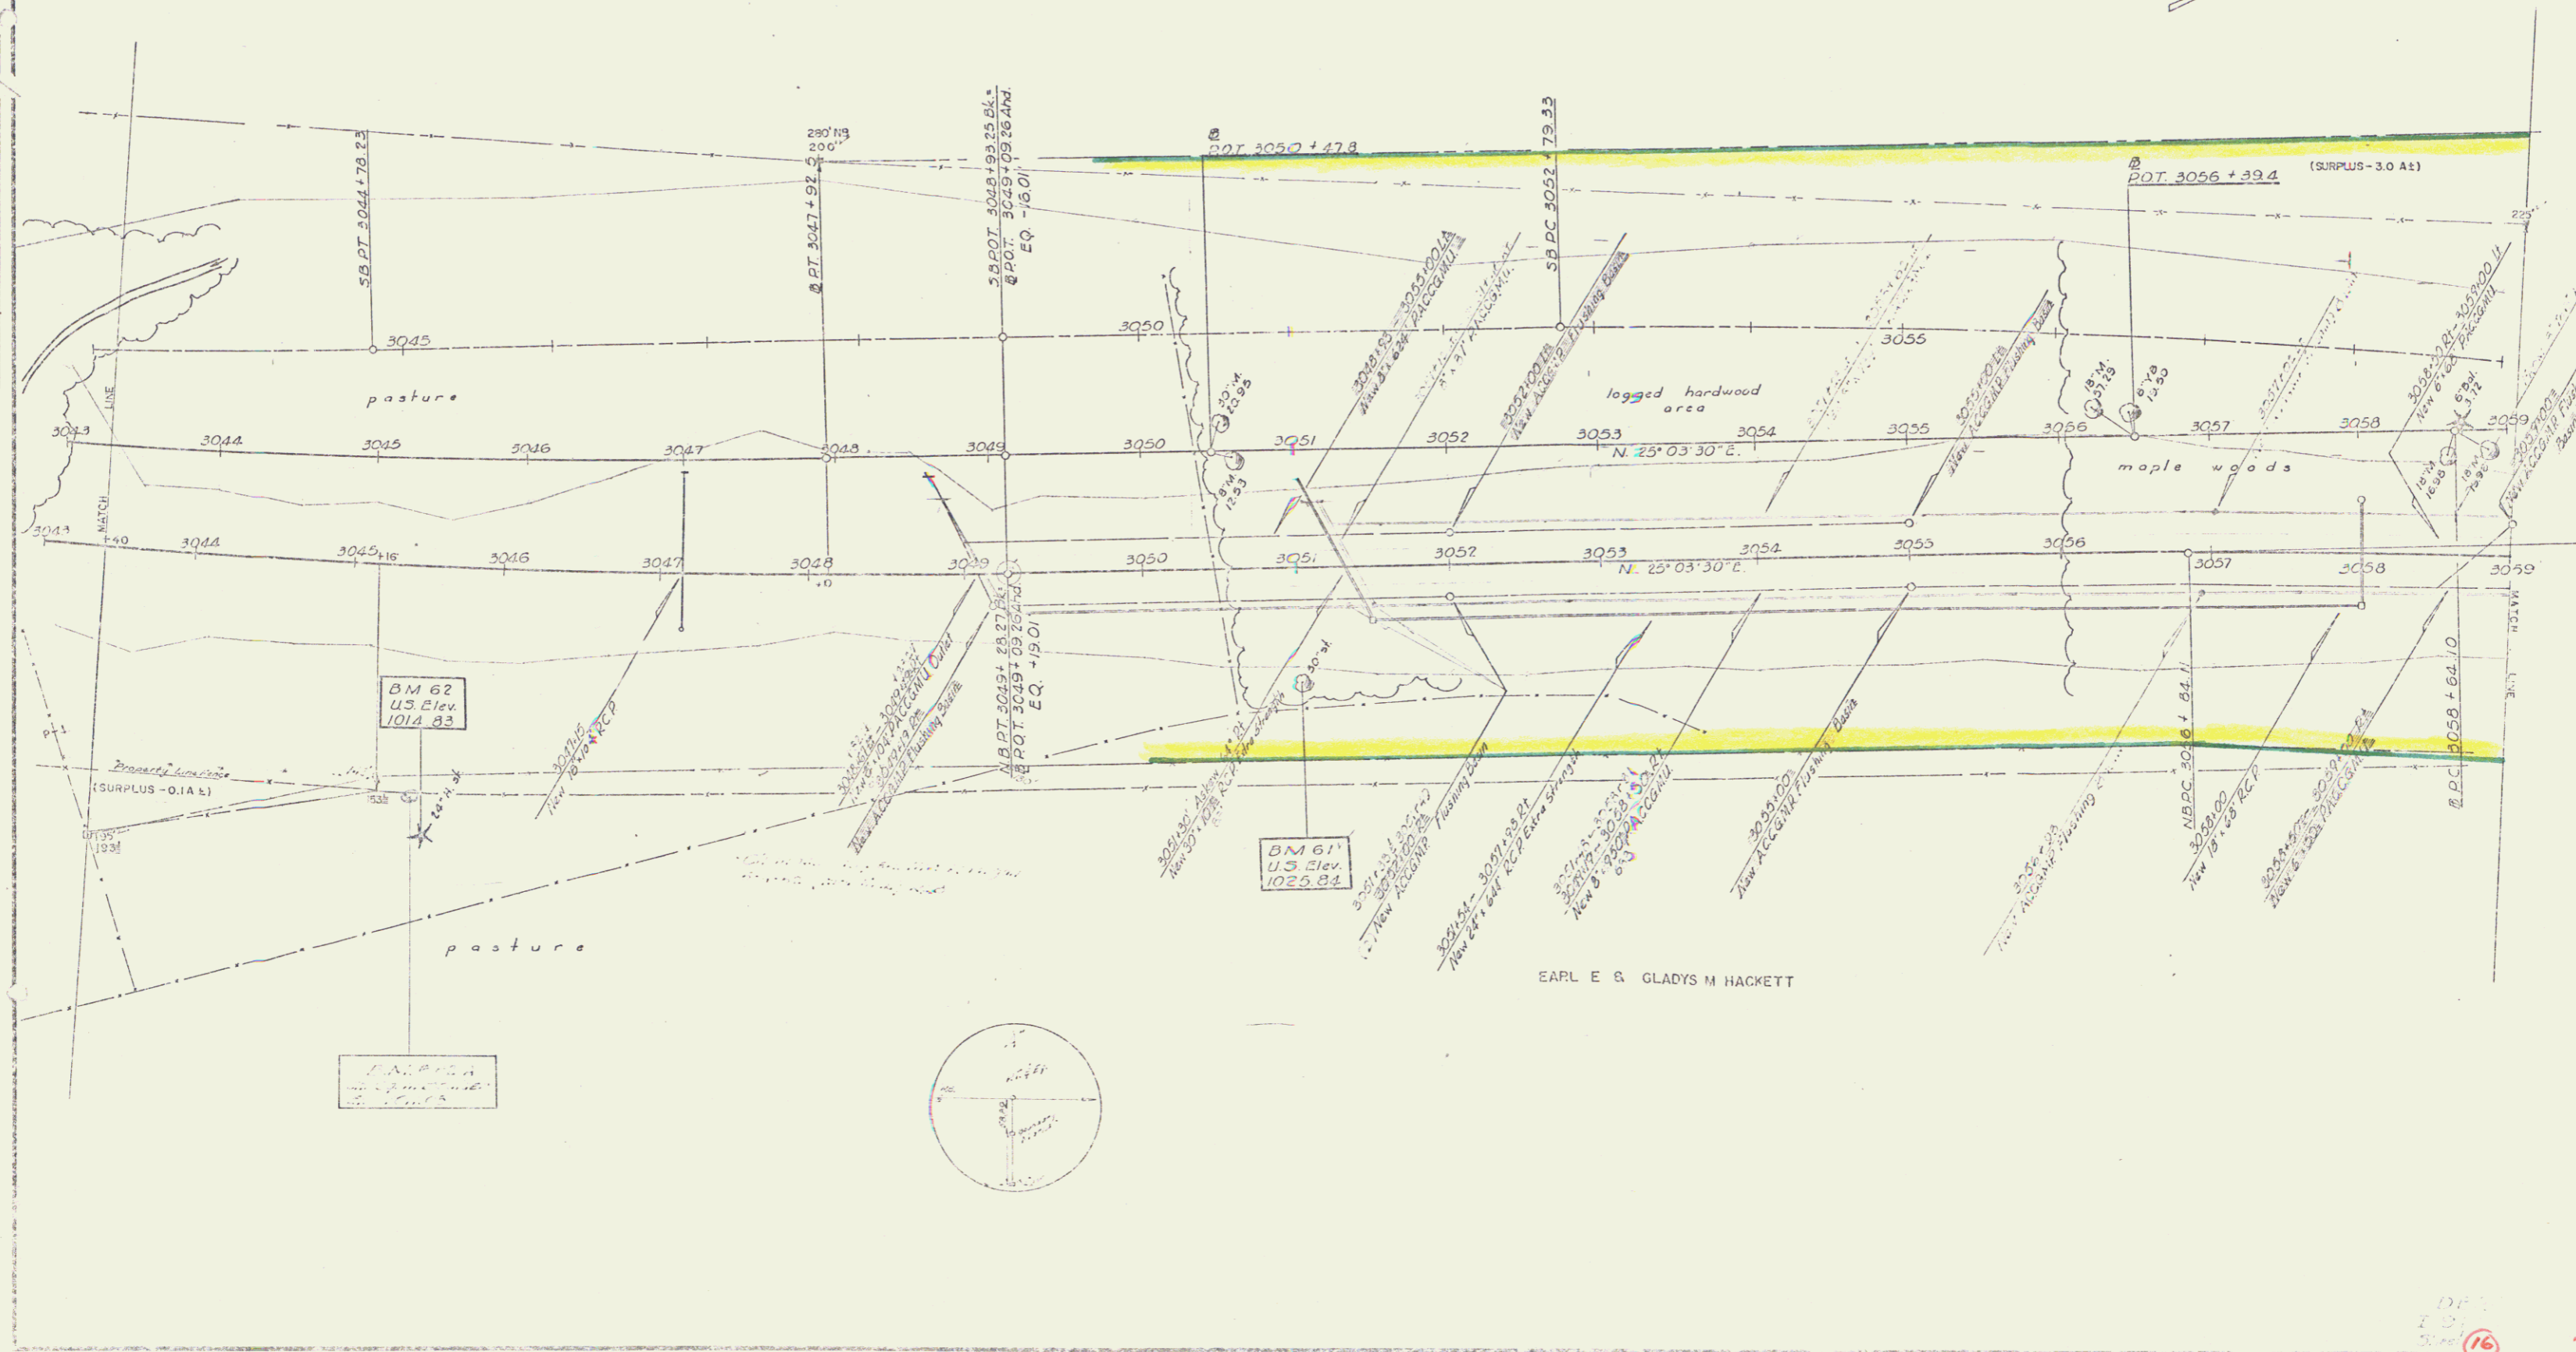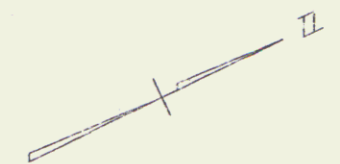

EARL E & GLADYS M HACKETT

16
JUL 11 1974

Seeding Fertilizer Muck
3059+00 - 3075+00 E 14.41

THREE CABLE GUARD RAIL
with STEEL POSTS
3064+28.14 - 3073+72.14
105' - 31.7' ± 88' LF


DRILLING & BLASTING of SOLID
ROCK, SUBGRADE, ITEM III MOD.
3071+66 - 3081+42
89' 9" - 10' ± 49'

PROPERTY LINE FENCE w/ STEEL
POSTS - MOD
3071+70 - 3075+80.14
39' 10" - 40' ± 10.14 LF

EARL E & GLADYS M HACKETT

GRANTOR
STATIONS
TAKING
TITLE TAKEN
RECORDED

1810 BURNING
3071+70 - 3073+80±
QUARRYING AND MINERAL RIGHTS

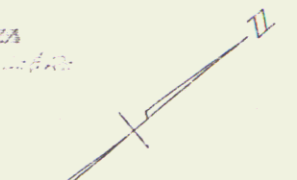

P.L. 3073+61.1±
3072+20.4

N.B. P.L. 3075+30.55±
3073+43.23

FLOYD L & JUNE M SHERLAW


TREES
ACROSS

B.M. 560A
U.S. Elev.
1042.02

B.M. 59A
U.S. Elev.
1239.00

B.M. 58A
U.S. Elev.
1039.05

B.M. 58A
U.S. Elev.
1070.13

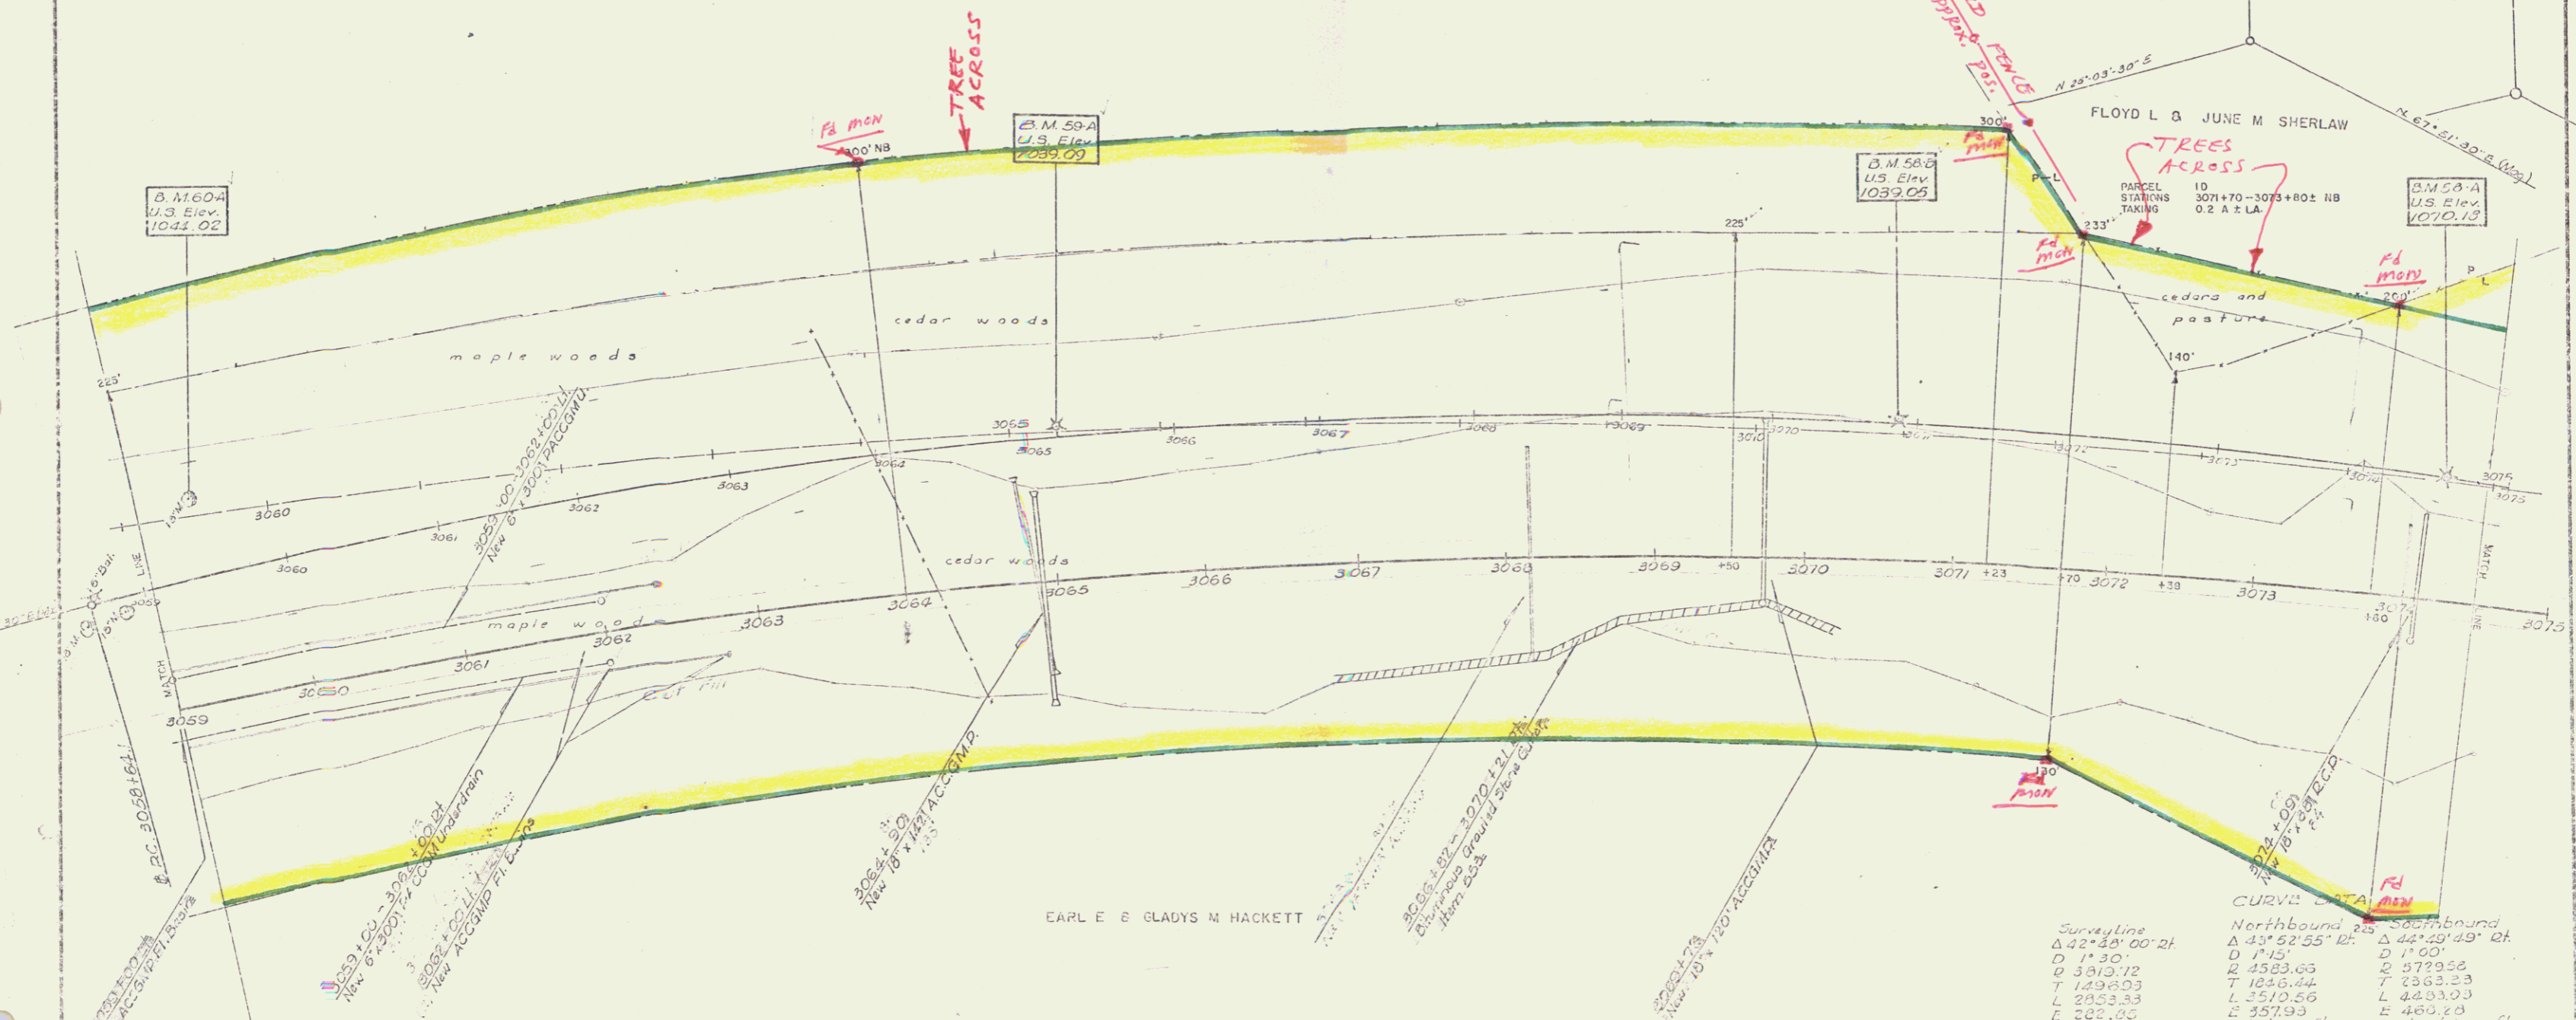


EARL E & GLADYS M HACKETT

Surveyline	Northbound	Southbound
Δ 42° 30' 00" ±	Δ 35° 52' 55" ±	Δ 44° 49' 49" ±
D 1' 30"	D 1' 45"	D 1' 00"
E 3510.72	E 4583.05	E 3779.56
T 129.003	T 104.044	T 2363.23
L 2193.93	L 3510.56	L 4483.00
E 282.85	E 357.93	E 460.20
	Bank 1/2 per ft.	Bank 1/2 per ft.

DERBY
Project E 91-3 (5)
Surveyed by Spaulding
Checked by Turner, Traced by [unclear]
Sheet 18 of 153

JUL 11 1974

4

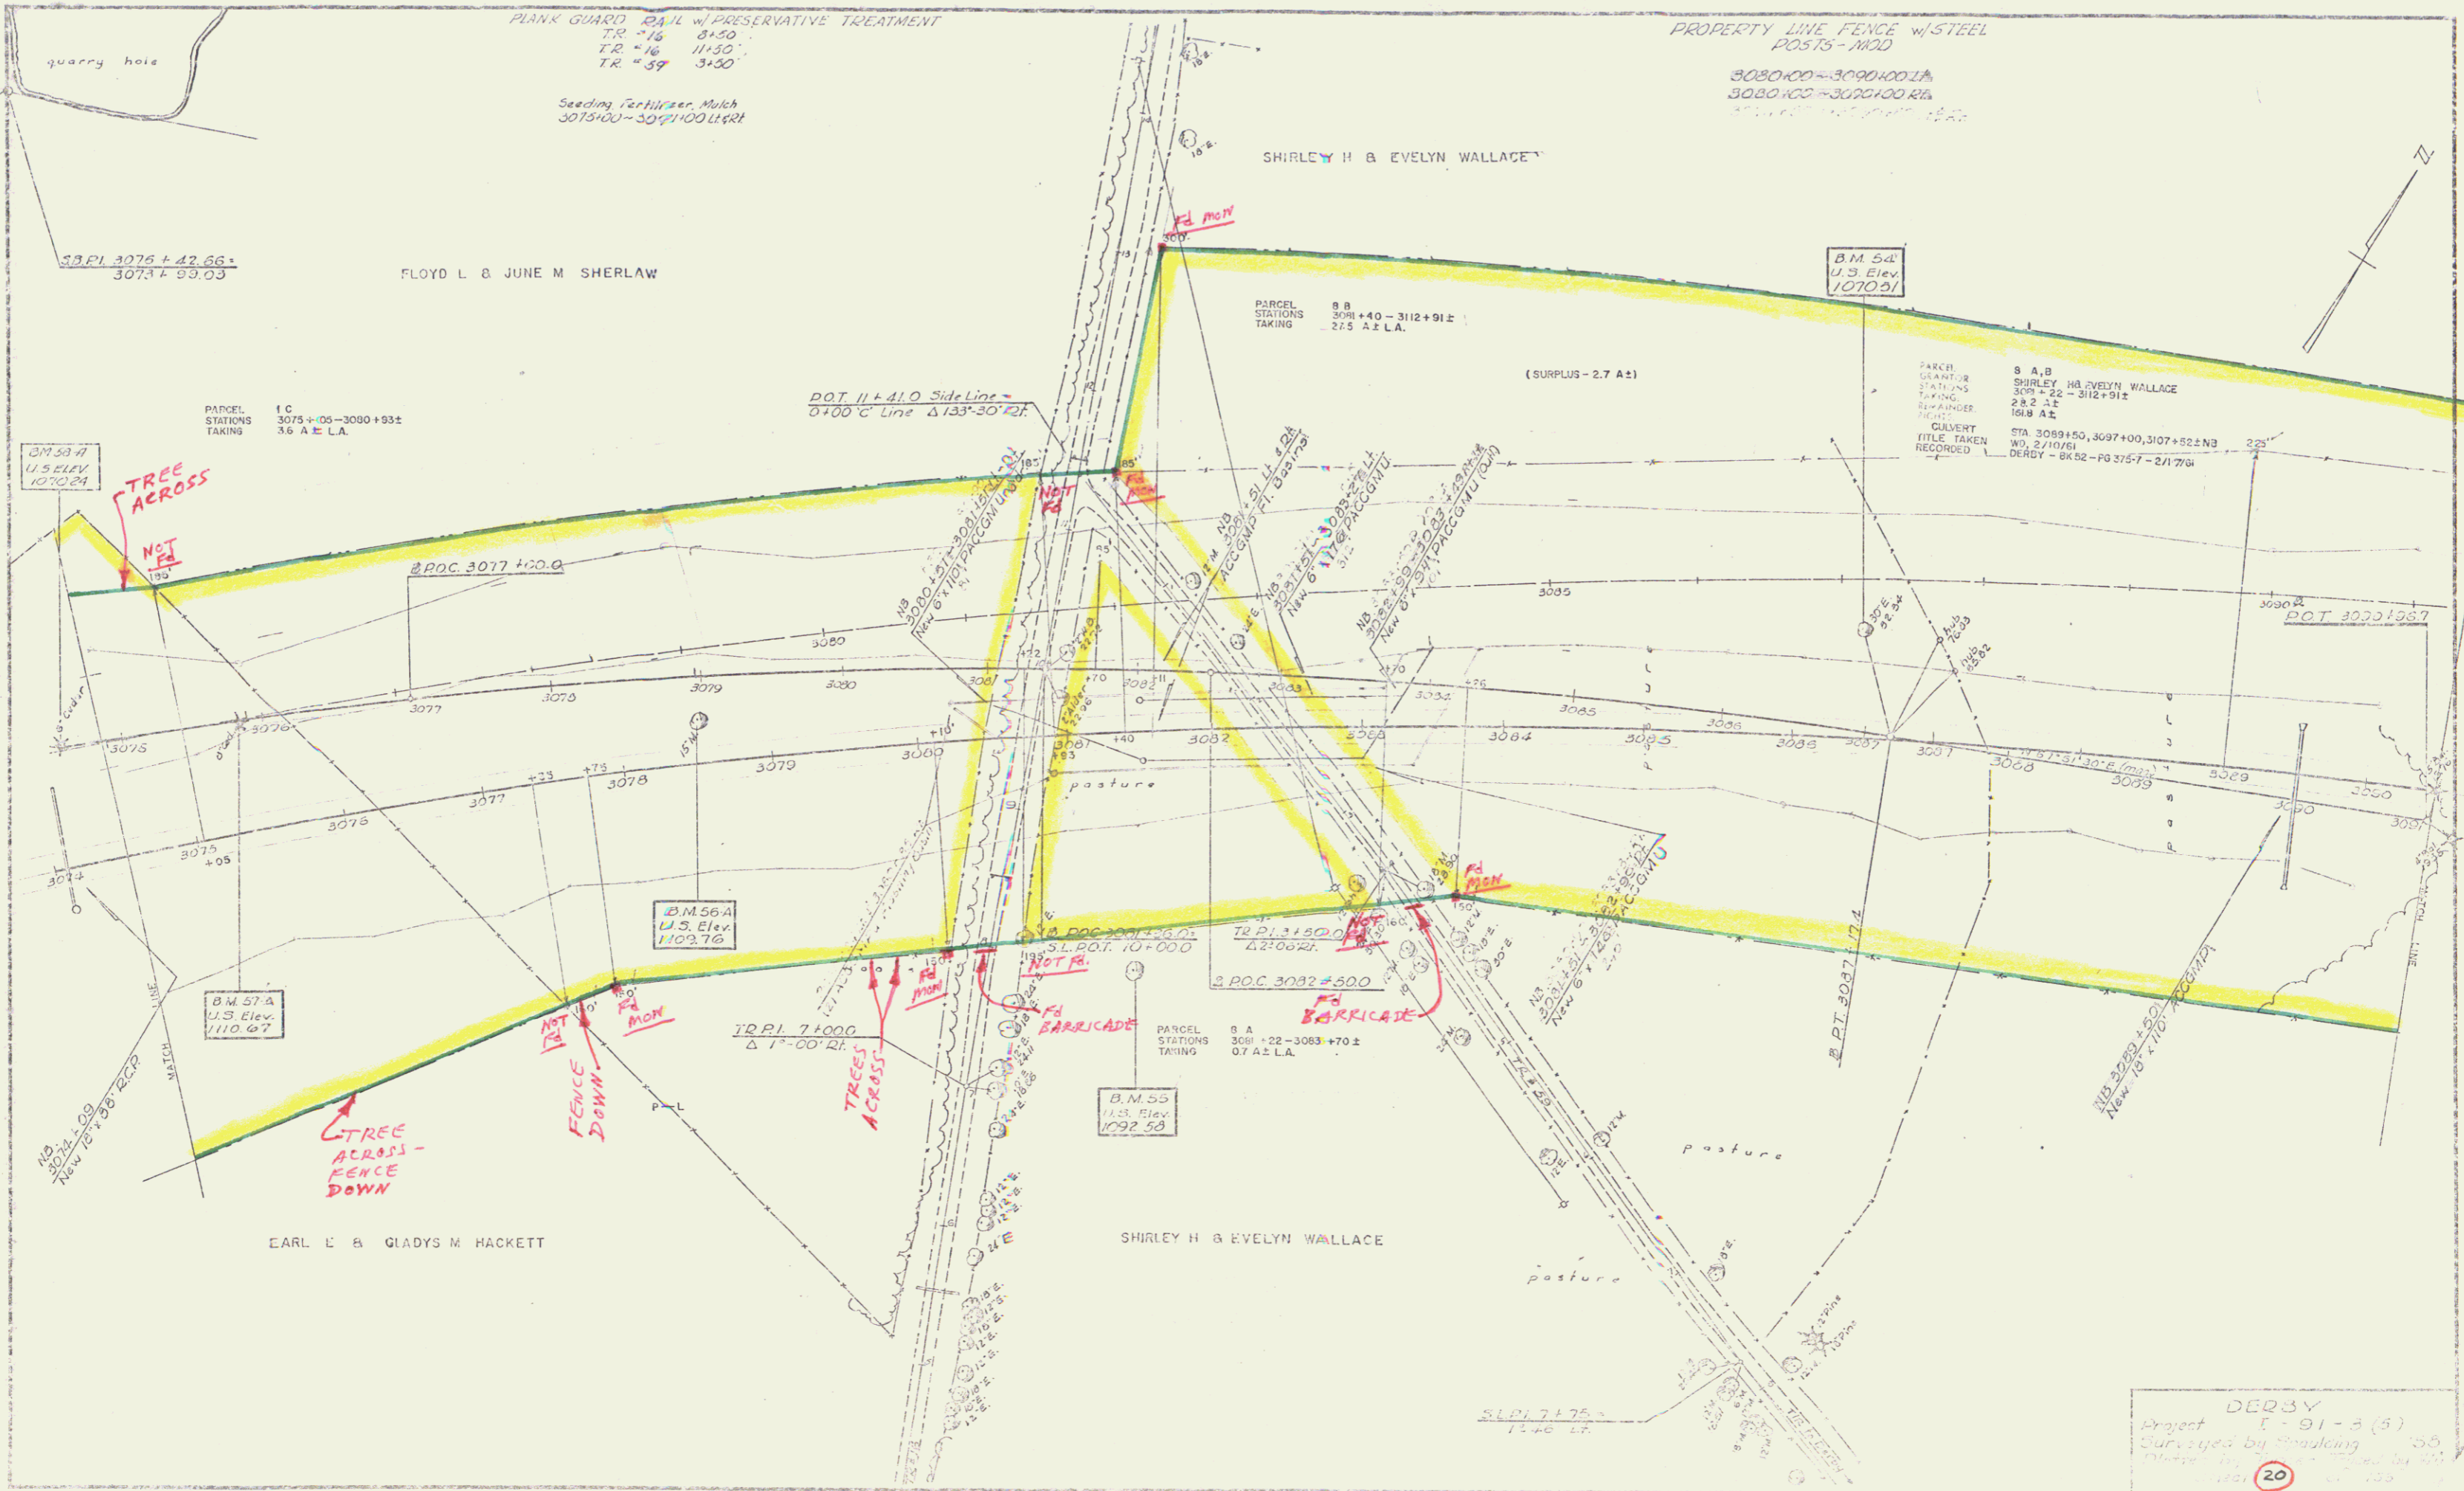

PLANK GUARD RAIL w/ PRESERVATIVE TREATMENT

TR #16 8:50
TR #16 11:50
TR #39 3:50

Seeding Fertilizer Mulch
307500-307700 U&R1

PROPERTY LINE FENCE w/ STEEL POSTS - 1800

3080+00-3090+00 L&A
3080+00-3090+00 R&A

FLOYD L & JUNE M SHERLAW

SHIRLEY H & EVELYN WALLACE

B.M. 54
U.S. Elev.
1070.21

PARCEL STATIONS TAKING
1 C
3075+05-3080+93±
3.6 A± L.A.

D.P.C. 11+41.0 Side Line
0+100 C Line Δ 133°30' RT.

PARCEL STATIONS TAKING
8 A
308+40-312+91±
2.5 A± L.A.

B.M. 54
U.S. Elev.
1070.21

PARCEL STATIONS TAKING
8 A, B
SHIRLEY H & EVELYN WALLACE
309+22-312+91±
2.8 A±
168 A±
CULVERT
TITLE TAKEN
RECORDED
STA. 3089+50, 3097+00, 3107+52± NB
WD. 2/10/61
DERBY - BK 52 - PG 375-F - 2/1/76

B.M. 54
U.S. Elev.
1070.21

TREE ACROSS

D.P.C. 3017 +00.0

NOT FR.

TREE ACROSS

NOT FR.

NOT FR.

EARL E & GLADYS M HACKETT

SHIRLEY H & EVELYN WALLACE

B.M. 55
U.S. Elev.
1092.58

PARCEL STATIONS TAKING
8 A
308+22-3083+70±
0.7 A± L.A.

TR P.I. 7+000
Δ 1°-00' RT.

D.P.C. 3082 +50.0

TR P.I. 1+500
Δ 2°-00' RT.

BARRICADE

BARRICADE

DERBY
Project F-91-3(5)
Surveyed by [unclear]
Checked by [unclear]
Date [unclear]

JUL 11 1974 5


Seeding, Fertilizer, Muck
3091+00 - 3107+00 L&R

SPECIAL DITCH - ITEM 103-A
NB 3096+50 Rt - 3104+51 Rt

PROPERTY LINE FENCE w/ STEEL POSTS - MOD

3094+50 - 3106+00 RA

SHIRLEY H & EVELYN WALLACE

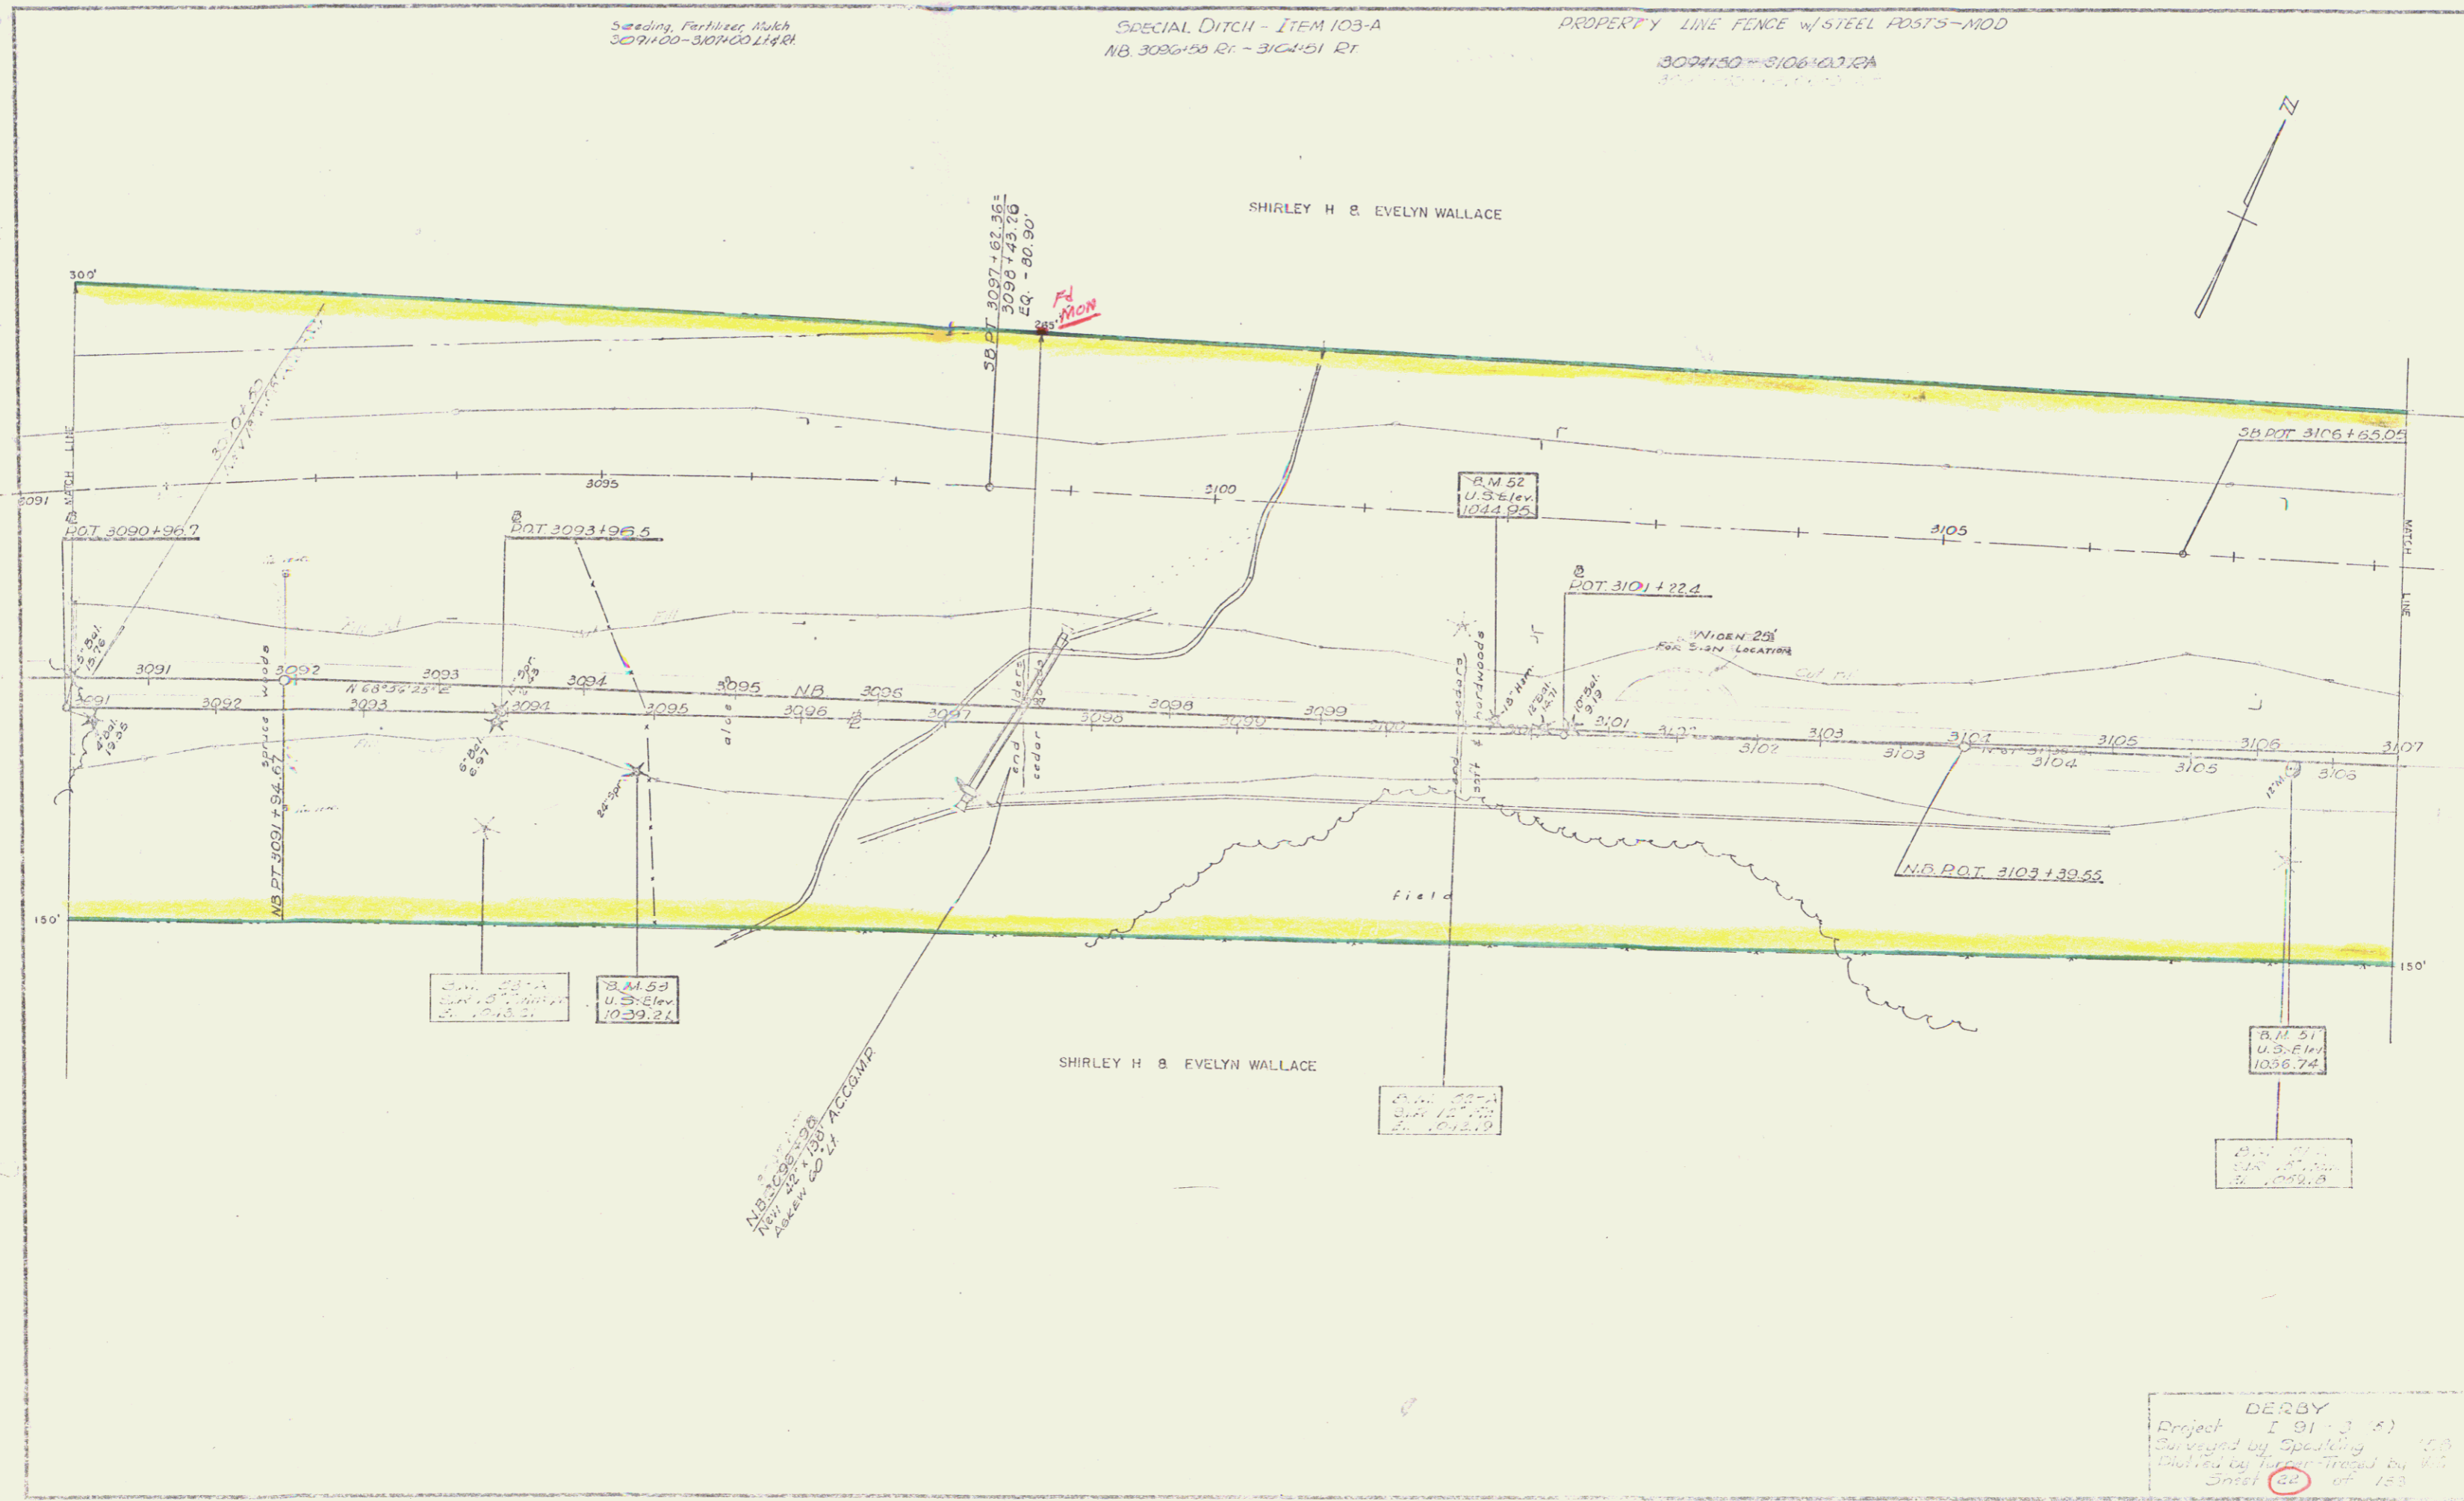

DERBY
 Project I 91-3-5
 Surveyed by Spedding 100
 Divided by Paper Traced by 90
 Sheet 60 of 153

JUL 11 1974

6

PARCEL 88
GRANTOR SHIRLEY M. & EVELYN WALLACE


Seeding, Fertilizer, Mch
3/07/60 - 3/23/60 L.A. #1

PROPERTY LINE FENCE W/ STEEL
POSTS - Mod
3104+00 - 3108+00 EA
3118+00 - 3123+00 EA
3124+00 - 3128+00 EA
3107+00 - 3107+00 EA

DRILLING & BLASTING of SOLID
ROCK SUB-GRADE, ITEM 114 MCO.
3114+03 - 3121+50

PARCEL 10 A, B, C
GRANTOR DONALD G. & DOROTHY P. MC CUTCHEON
STATIONS 314+57 - 4+65 S. 3A #3
TAKING 19.9 A.L.
REMAINDER 106.1 A.L.
RIGHTS
CULVERT STA. 3123+24, 3123+53, 3127+54
3124+01, 3128+04
UNDERDRAIN STA. 3123+02
TITLE TAKEN COND. 11/29/60
RECORDED DERBY - DK 32 - PG 89-133 - 12/1/60

PARCEL 10 A
STATIONS 314+57 - 3140+60
TAKING 18.1 A.L.

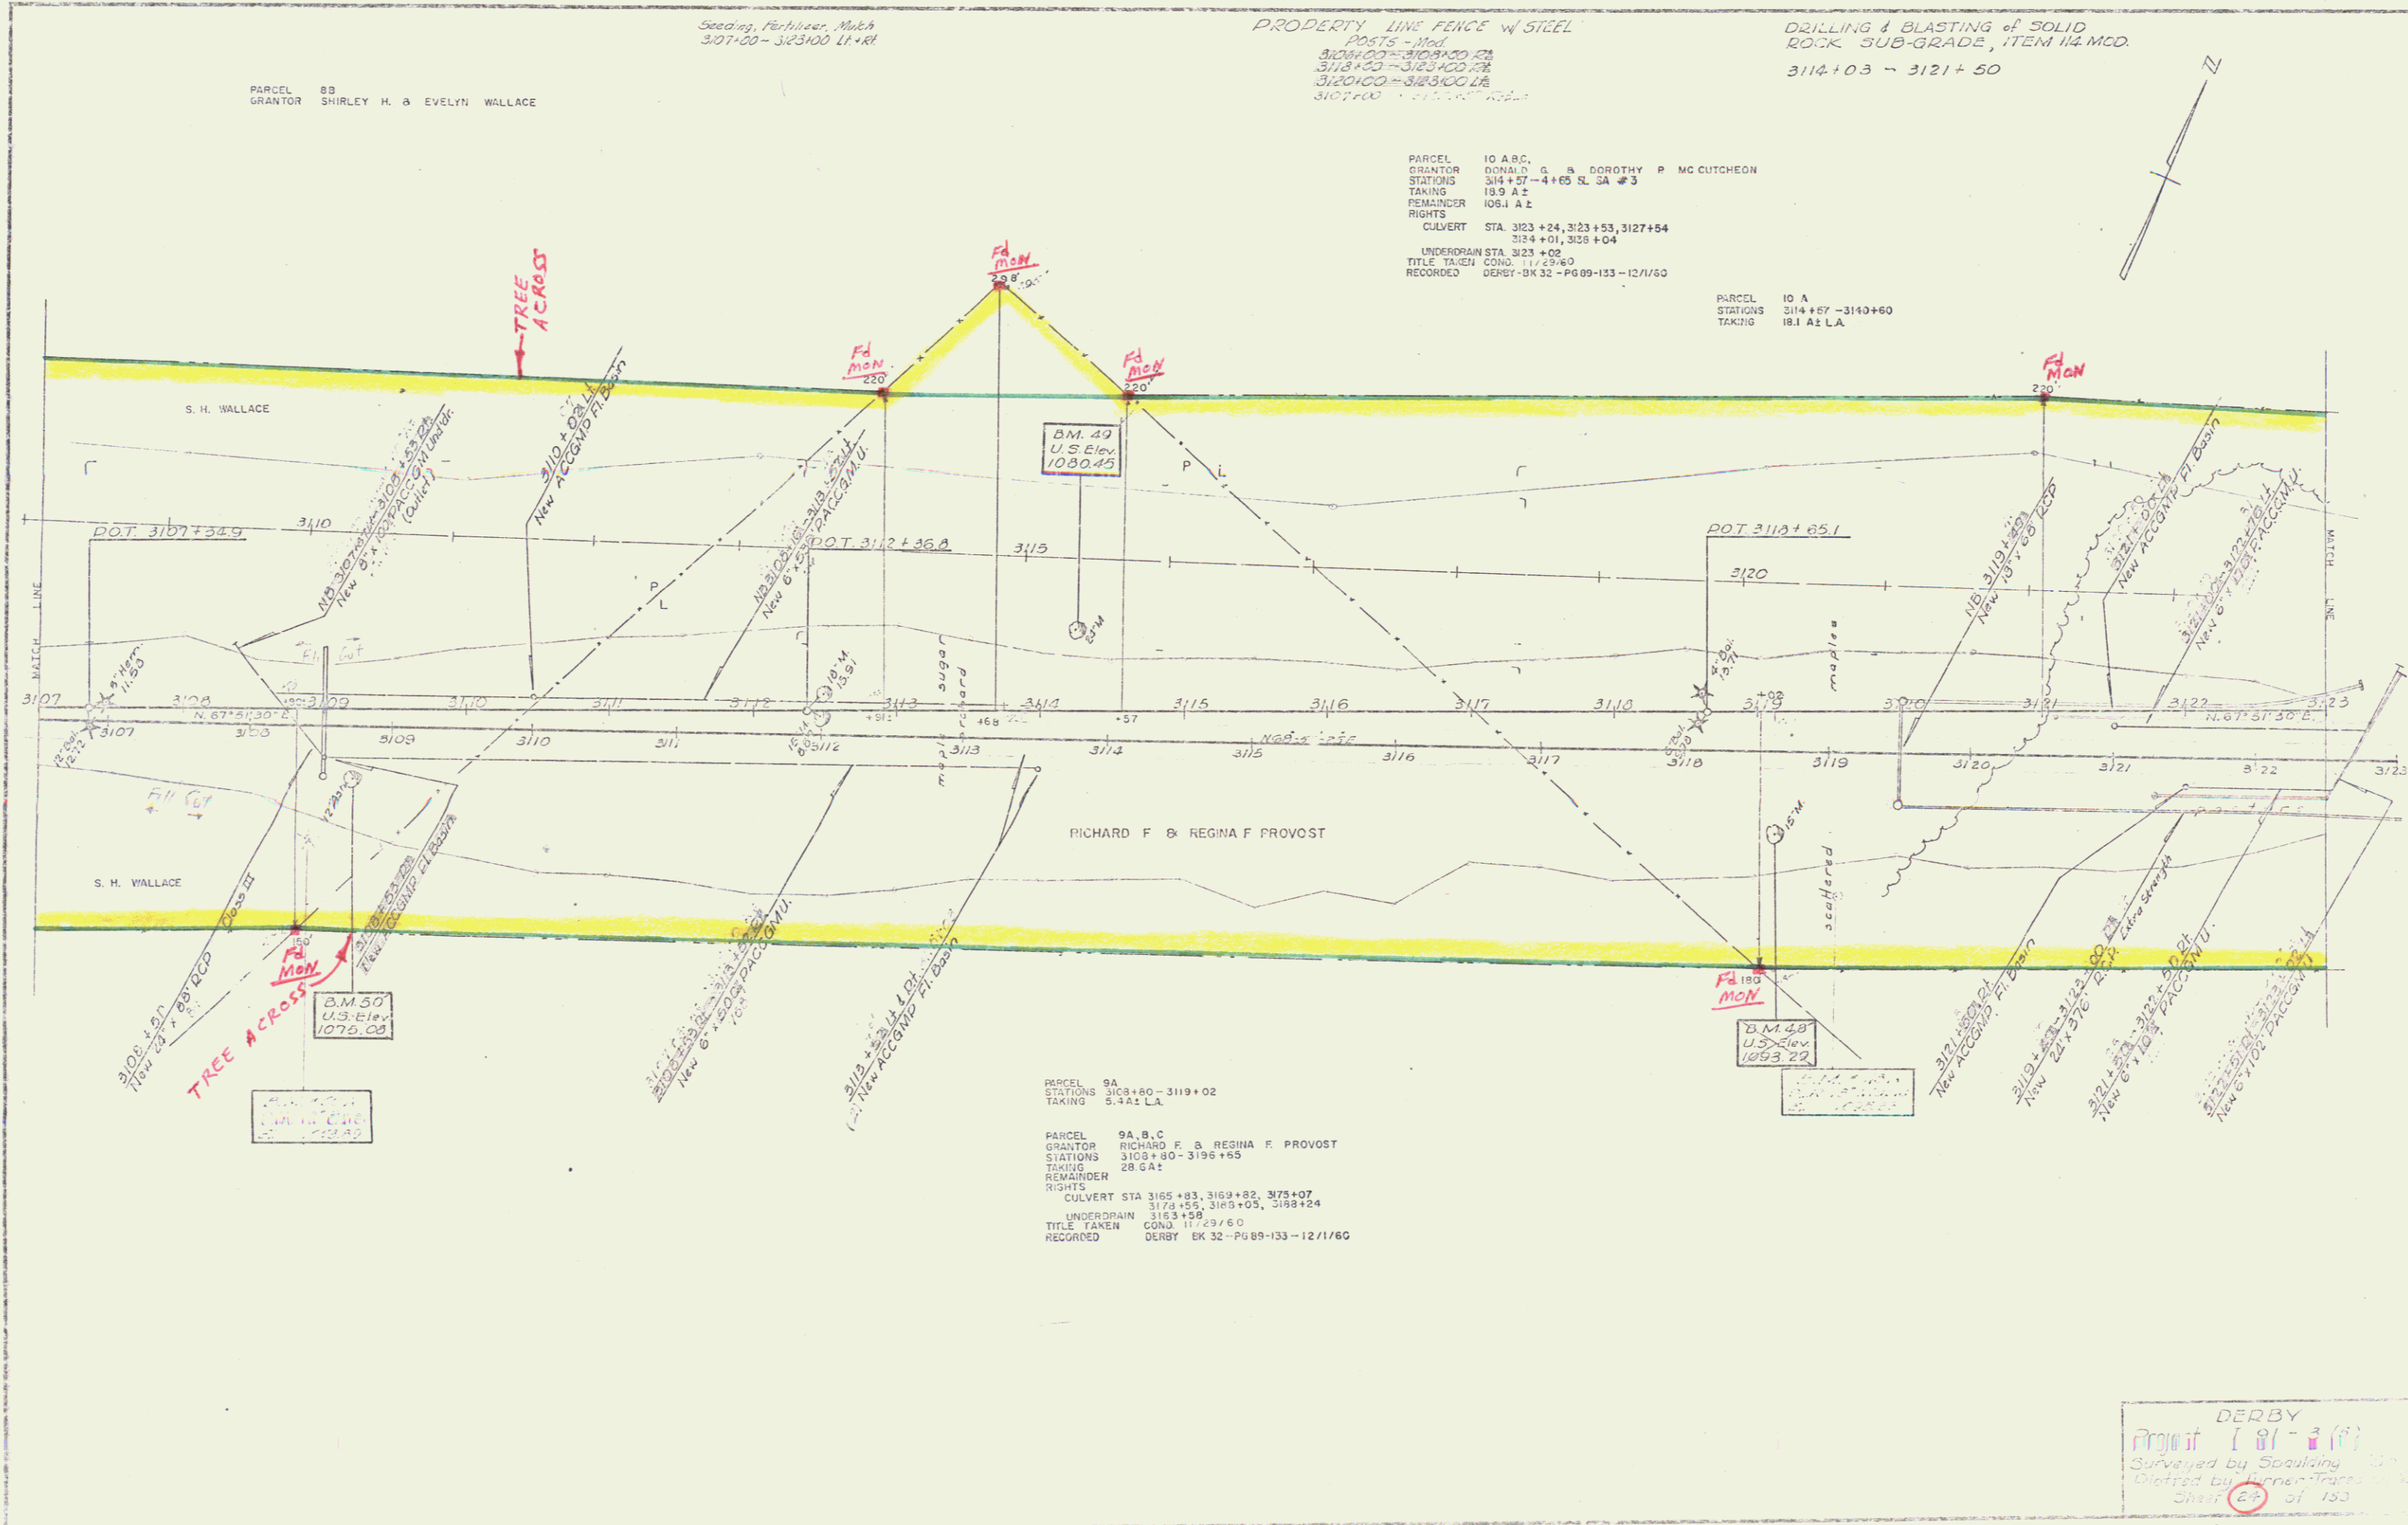

PARCEL 9A
STATIONS 3108+60 - 3119+02
TAKING 5.4 A.L.

PARCEL 9A, B, C
GRANTOR RICHARD F. & REGINA F. PROVOST
STATIONS 3108+80 - 3196+85
TAKING 28 GA.
REMAINDER
RIGHTS
CULVERT STA. 3165+83, 3169+82, 3175+07
3174+56, 3165+05, 3198+24
UNDERDRAIN STA. 3163+58
TITLE TAKEN COND. 11/29/60
RECORDED DERBY DK 32 - PG 89-133 - 12/1/60

DERBY
Project 81-100
Surveyed by Scouting
Designed by Turner Trans
Sheet 2 of 133

JUL 11 1974

PROPERTY LINE FENCE w/ STEEL POSTS - Mod
 313+00 - 314+00 RT
 3138+00 - 315+00 LT
 3145+00 - 315+00 RT
 3147+00 - 315+00 LT

PARCEL 11 A, B, C, D
 GRANITOR CARMY J & LENA BENOIT
 STATIONS 3139+73 - 3162+33
 TAKING 19.74 L
 REMINDER 183.3
 RIGHTS

CULVERTS STA 3143+00, 3150+00, 3166+03, 3153+54
 STA 5+05, 1+78, 5 A #3
 GRADE CHANGE - STA 15+50 - 17+00 S.L.
 TITLE TAKEN 0010, 11/29/60
 RECORDED DEBY - BK 32 - PG 99 - 133 - 12/11/70

THREE CABLE GUARD RAIL with STEEL POSTS
 3143+20 - 3145+30 RA

PARCEL 11 A
 STA 3136+73 - 3147+33
 TAKING 5.241 L.A.

Seeding Fertilizer, Mulch
 3139+00 - 3145+75 LT
 3139+00 - 3141+30 RT
 3145+75 - 315+00 LT
 3145+10 - 315+00 RT

DEMOLITION & REMOVAL OF BUILDING ITEM 530
 3144+00 LT. DUMD HOUSE
 3144+13 LT. SPRING HOUSE

PARCEL 11 C
 STATIONS 3145+50 M.L. - 16+00 S.L.
 TAKING 0.841


BASE LINE	NORTHBOUND	SOUTHBOUND
Δ 3' 41" Lt	Δ 2' 14" 26" Lt	Δ 7' 52" 49" Lt
D 0' 15"	D 0' 30"	D 0' 45"
R 22918.32	R 11459.16	R 7839.44
T 758.92	T 422.25	T 526.10
L 1473.33	L 848.10	L 1050.70
E 11.84	E 7.84	E 13.09'
	Brk. 2. C	Brk. 1/4" per ft.



DEBY
 Project I 91-3 (5)
 Surveyed by Spaulding
 Plotted by [unclear]
 Shred [unclear]

28

JUL 11 1974

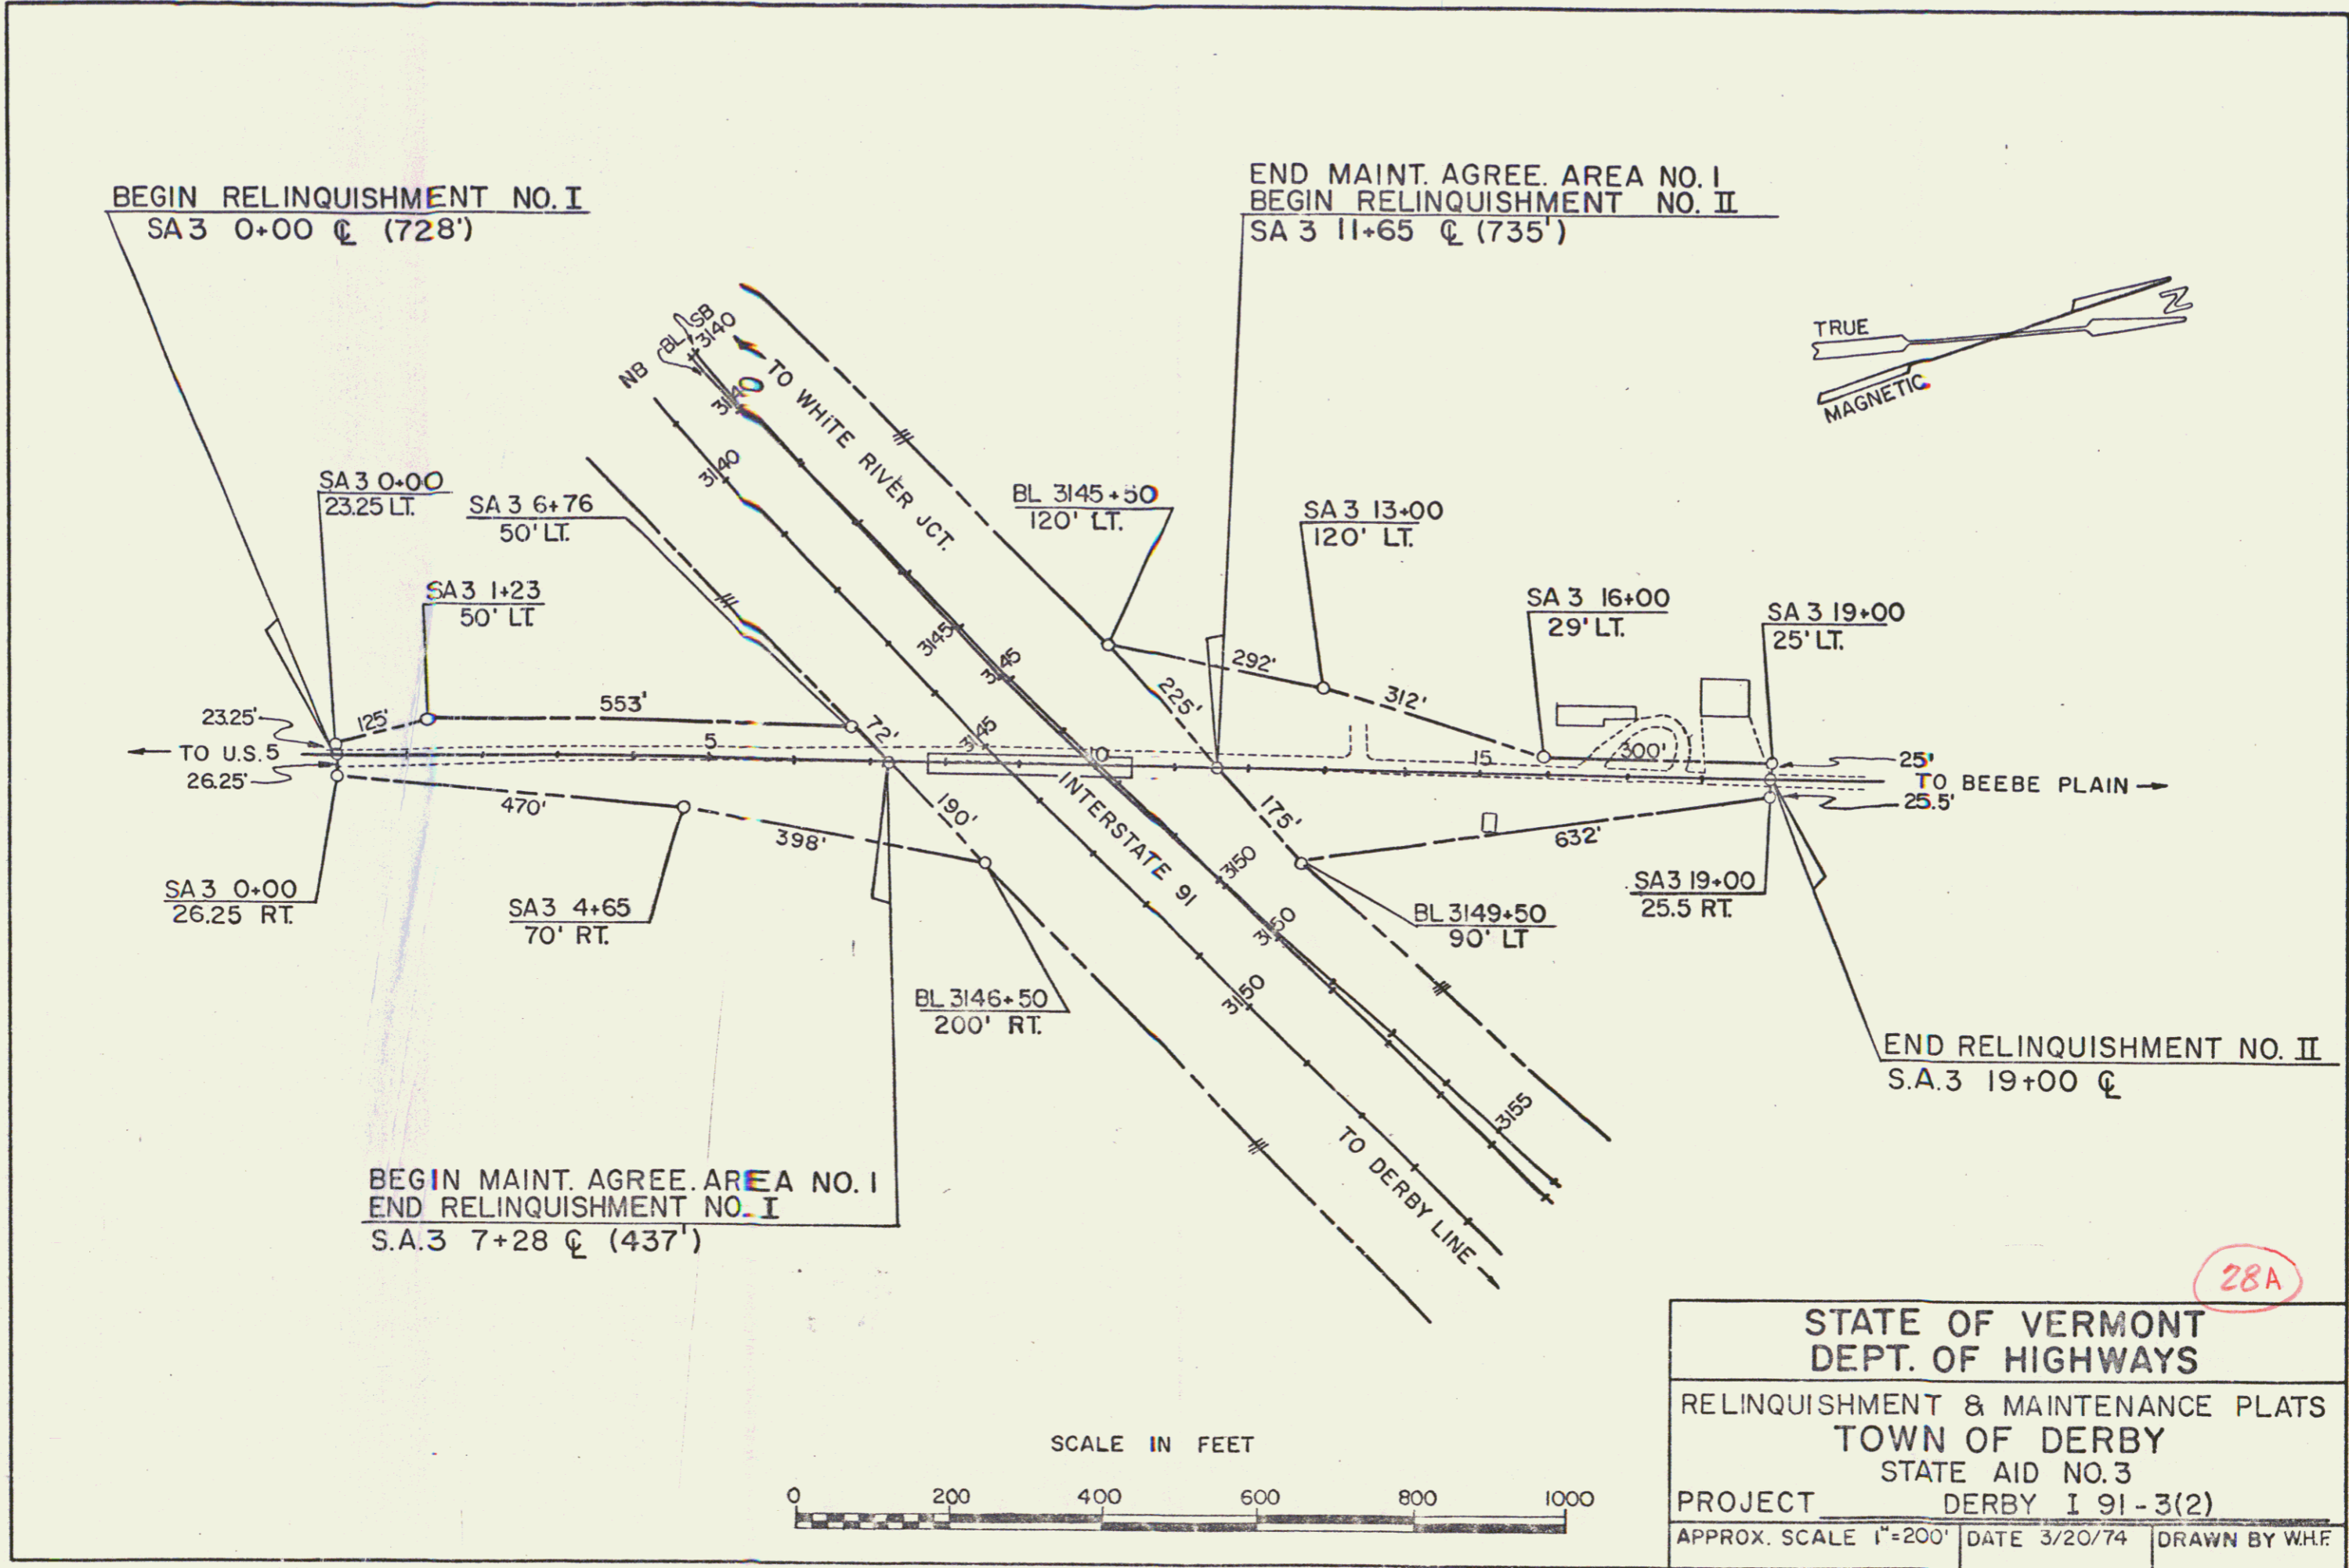

SEEDING, SPECIAL, ITEM 611

STA 710 - 8130' Lt f = Rt
 STA 9130 - 1110' Lt f = Rt

TWO CABLE GUARD RAIL

Lt. 410' - 710' 21.078 - 710' 920
 Rt. 10130' - 10130' 10468' - 10468' 13 - 10473

PARCEL 10 B
 GRANITOR DONALD G & DOROTHY R MCCUTCHEON
 STATIONS 0+00 - 4+63 ±
 TAKING 0.5 A2

Seeding, Fertilizer, Mulch
 1100 - 1100 Lt + Rt


PARCEL 10 C
 GRANITOR DONALD G & DOROTHY R MCCUTCHEON
 STATIONS 0+00 - 4+63 ±
 TAKING 0.5 A2

Survey Base Line
 Δ 3° 31' 11"
 D 0' 15"
 E 22018.32
 T 763.92
 L 1473.3
 E 11.84

Northbound
 Δ 4° 16' 26" Lt
 D 0' 30"
 E 11559.16
 T 424.25
 L 840.10
 E 7.84
 Pk B.C.

31. DOT 10+000+
 311.0051, 31461500

Rev. Curve Data
 Δ 2° 40' 22" Rt
 D 0° 40' 00"
 R 8594.37'
 T 200.50
 L 400.90
 E 2.34
 Do not bank

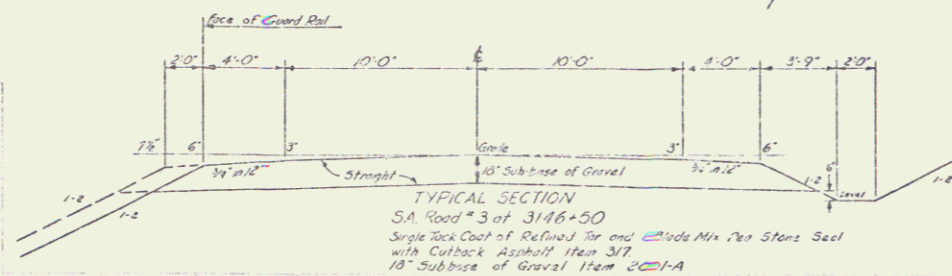

PVI
 8 + 00
 1042.00
 650' VC
 5+10 = 317

PVI
 2 + 75
 1002.20
 400' VC


SA #3
 Side Line @ ML 3146+50
 Deery
 Project I-91-3(A)
 Surveyed by Spaulding
 Plotted (Drawn) by G...
 sheet 20 of 110
 JUL 11 1974

Seeding, Fertilizer, Mites
1103 - 1100 L+R


CARMI J. & LENA BENGIT

PARCEL II C
STATIONS 3145 + 50 M.L. - 16+00 S.L.
TAKING 0.8 A ±

PARCEL II D
STATIONS 3147 + 97 M.L. - 19+00 S.L.
TAKING 0.8 A ±

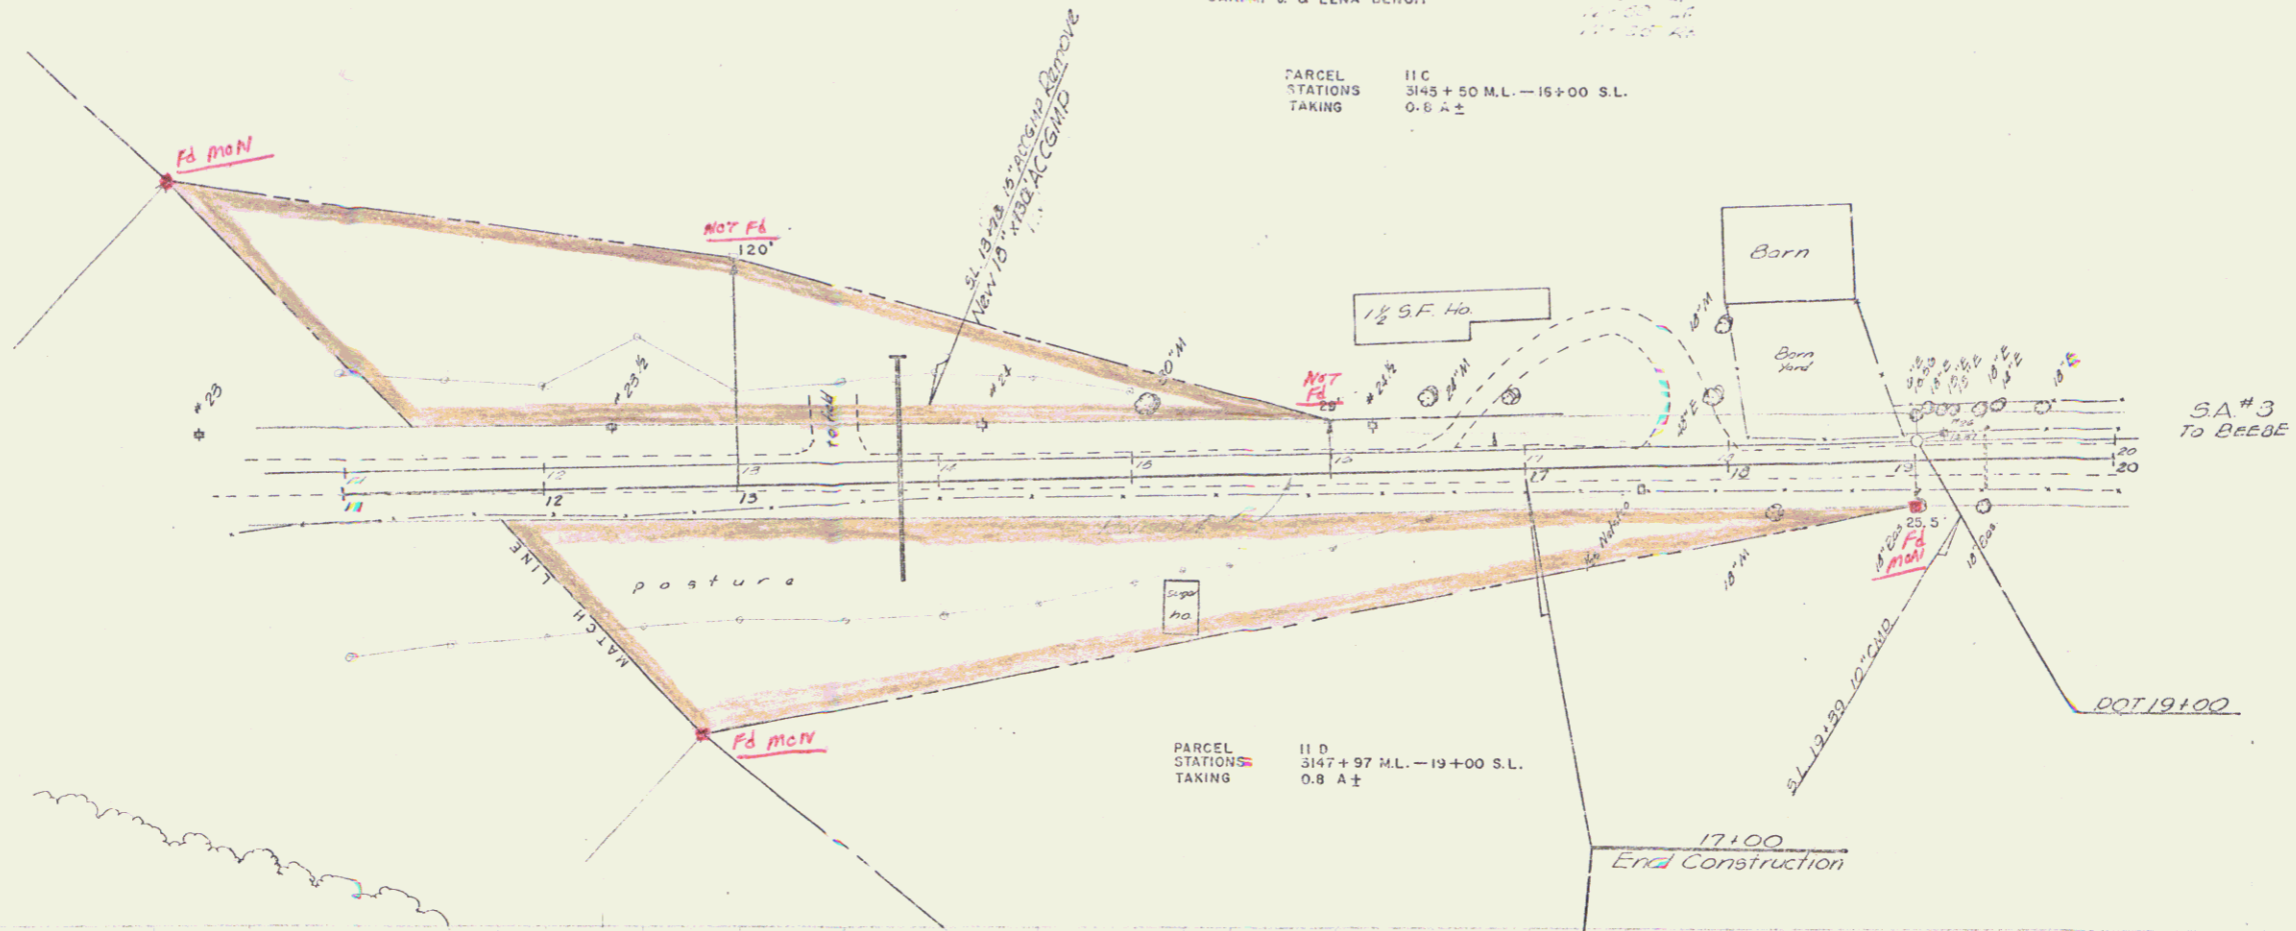

1030
1020
1010

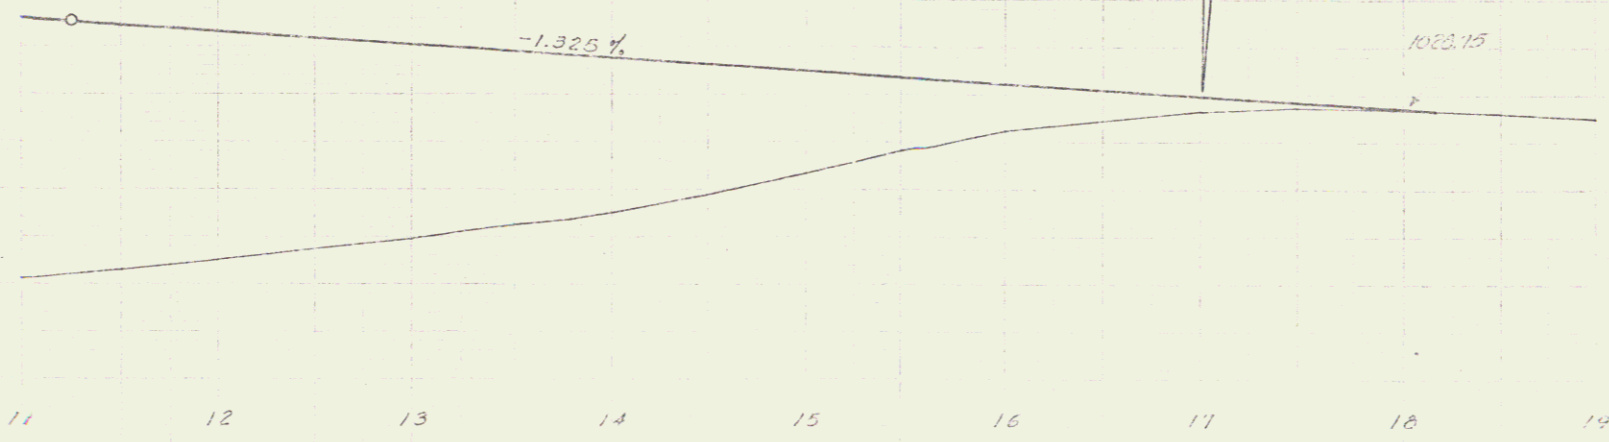

1030
1020
1010

SA # 3
Side Line @ M.L. 3146+50
DERRY
Project I-91-3(9)
Surveyed by Spruelling
1/10/74, checked by C...
Sheet 31 of 33 of 183
12
JUL 11 1974

CARRI J. & LENA L. BENOIT


PROPERTY LINE FENCE
W/STEEL POSTS AND IRON SPOUTS
3154+00 - 3171+00 RT
3154+00 - 3171+00 LT

THREE CABLE GUARD RAIL
with STEEL POSTS
50
3164+40 LT - 3171+00 LT
3164+55 RT - 3171+00 RT
3164+58

Southbound
Δ 4°43'30" Rt.
D 0'30"
T 11,459.16
L 482.00
E 965.0
L 10.17
Bnk. R.C.

PARCEL 12
GRANTOR WILLIAM & MARY JOHNSTON
STATIONS 3160+00 - 3164+25.1
TAKING 0.5 A2
REMAINDER 64.4 A2
RIGHTS NONE
TITLE TAKEN NO. 10728/50
RECORDED DERBY - PG 52 - PG 342-3 - 11/9/60

PARCEL 9
STATIONS 3158+00 - 3180+60
TAKING 15.1 A1

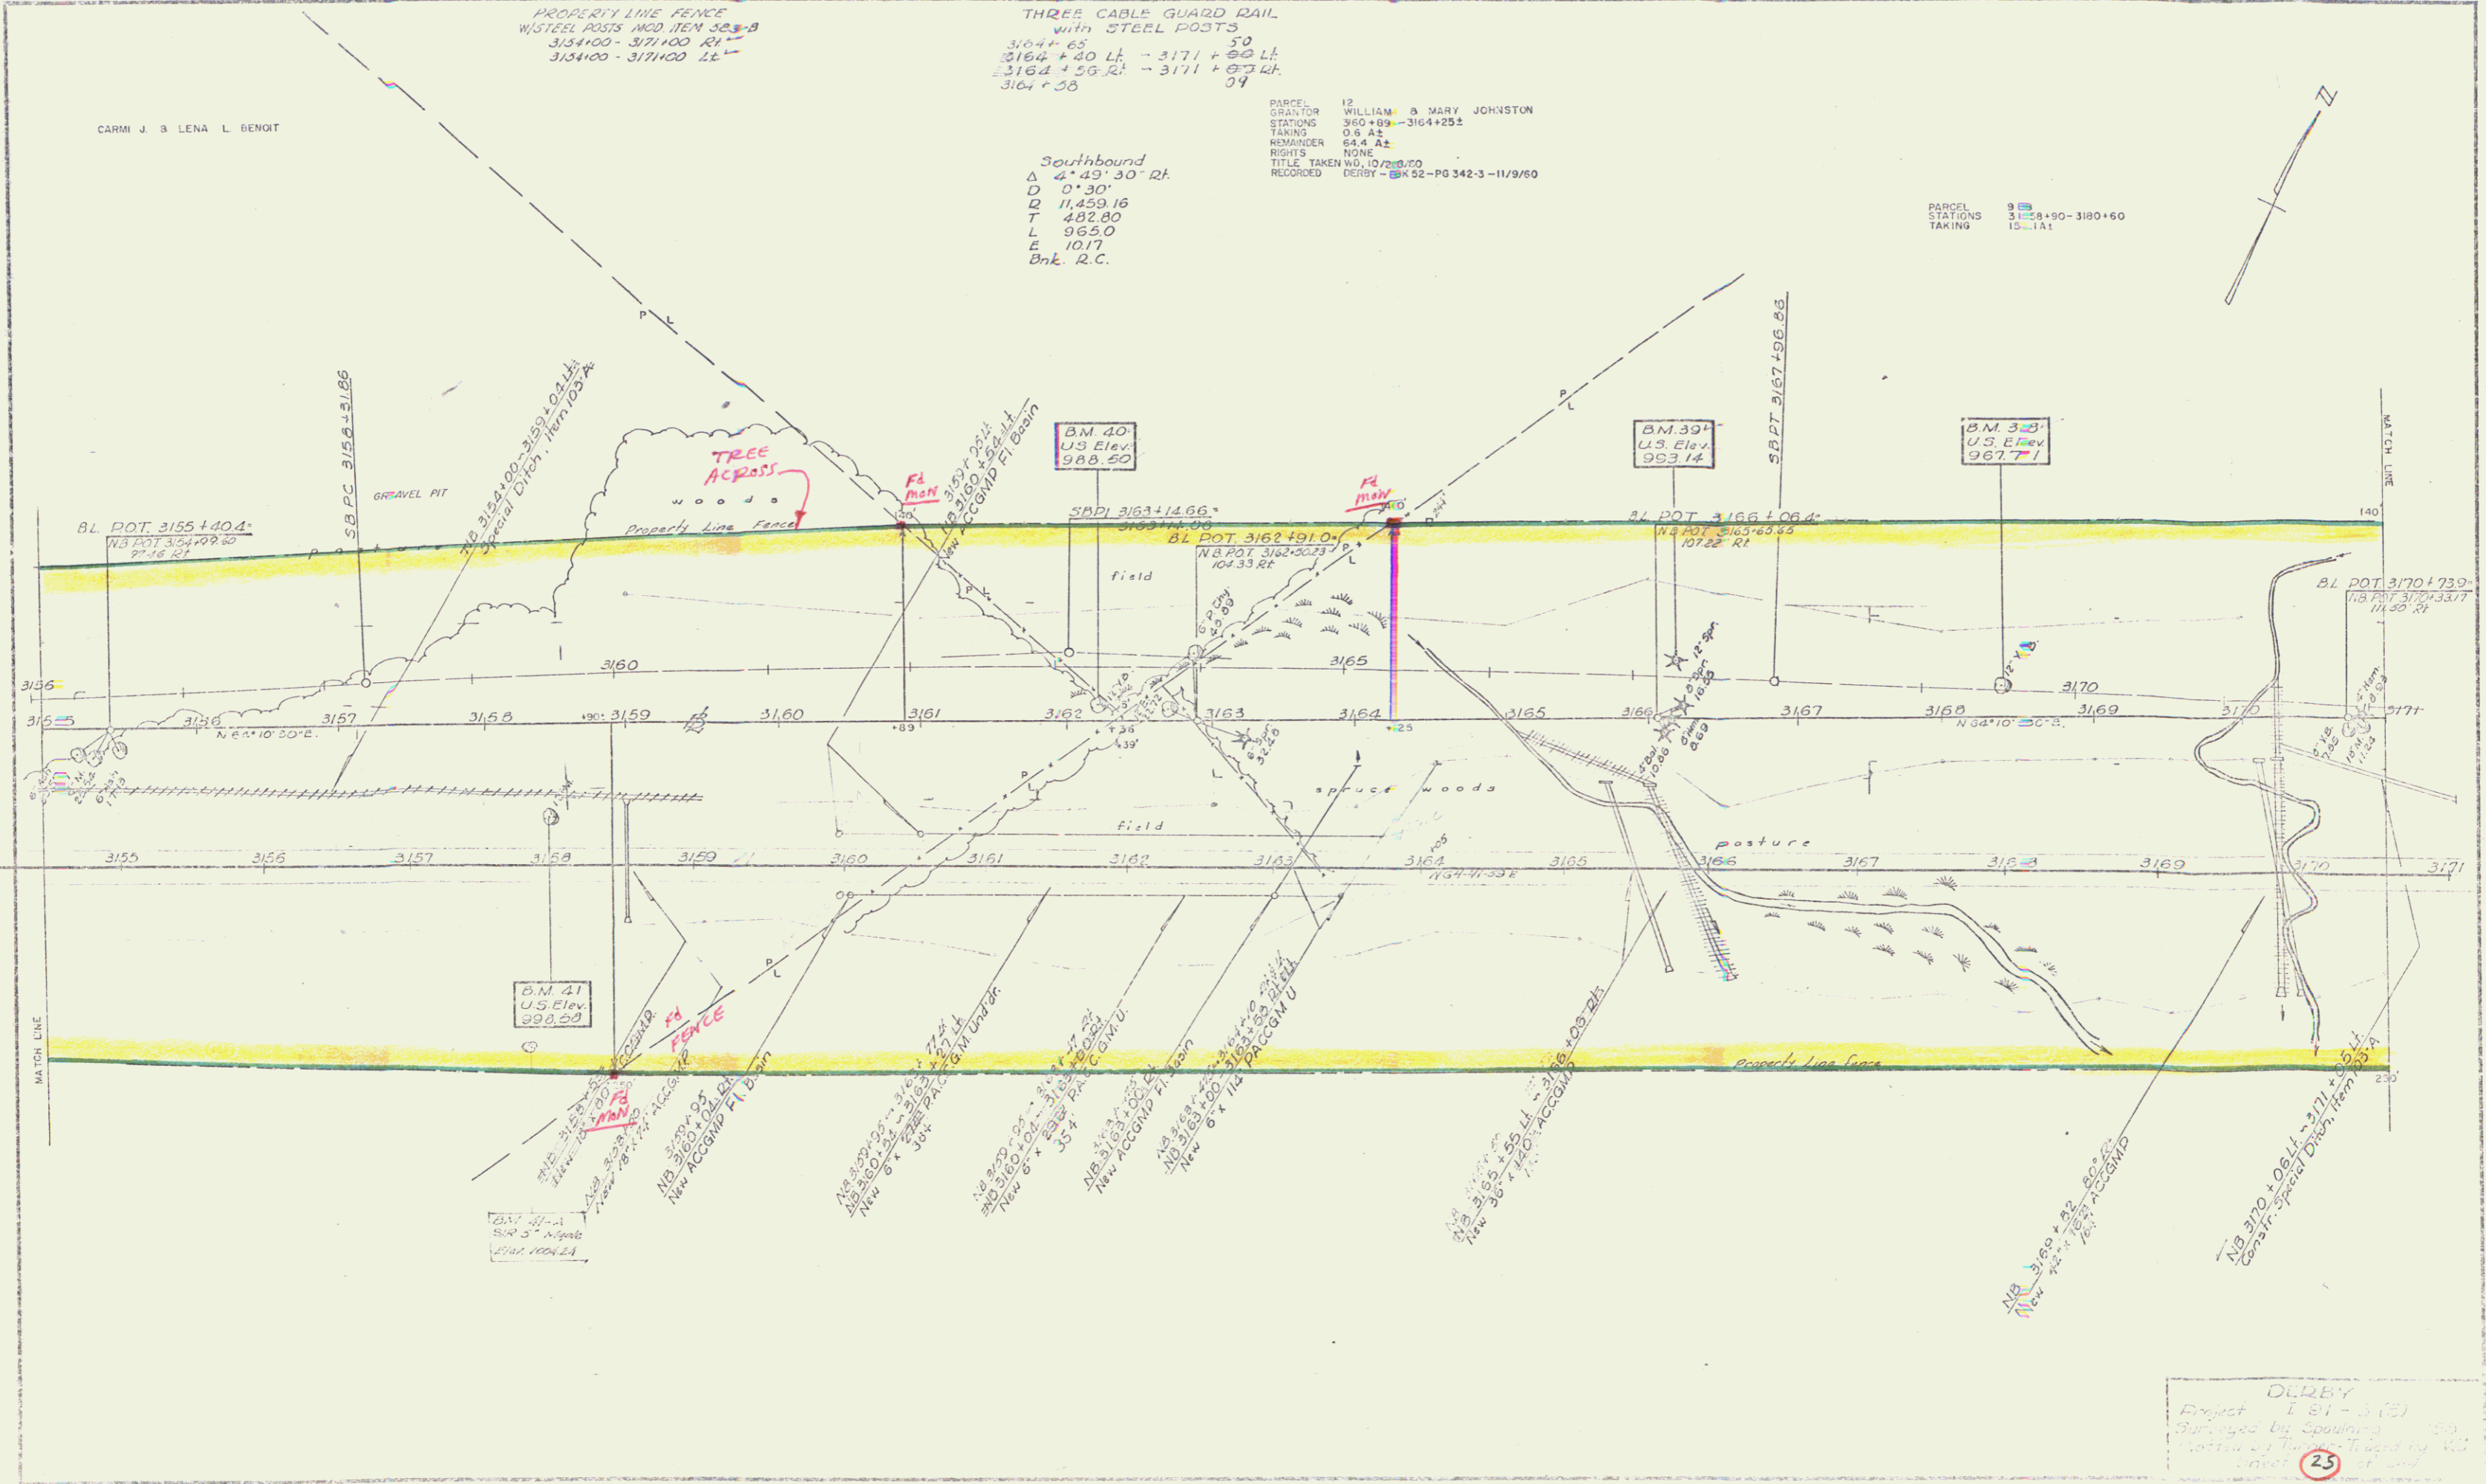

DERBY
Project I 81-3 (2)
Surveyed by Spawing
Checked by T. J. [unclear]
Level 25

JUL 11 1974 13

PROPERTY LINE FENCE
W/STEEL POSTS ITEM 503-B
3187+00 - 3196+86 R/L V


THREE CABLE GUARD RAIL
with STEEL POSTS
3186+00 LL - 3188+44 LL
3193+24 LL - 3203+00 LL
3195+01 RL - 3203+00 RL
3187+00 LL - 3187+00 LL
3193+24 LL - 3203+00 LL
3195+01 RL - 3203+00 RL

DRILLING & BLASTING of SOLID
ROCK SUBGRADE, ITEM 114 MOD.
3189+06 - 3191+57

PARCEL 15A, B, C, D, E
GRANTOR CLARENCE B. KELLEY
STATIONS 3191+73 - 3204+40
TAKING 63.1 A ±
REMAINDER 439.9 A ±
RIGHTS
COURTESY STA. 3221+39, 3236+99, 3240+00, 3245+00,
3249+86, 7+00, 21+00, 22+86 ± S.L.
CONV. 2-17-61
TITLE TAKEN
RECORDED DERBY - BK 32 - PG 135-143 - 2/20/61

PARCEL 15A
STATIONS 3191+73 - 3213+85
TAKING 19.1 A ±

EDWARD H. & DOROTHY C. LEE

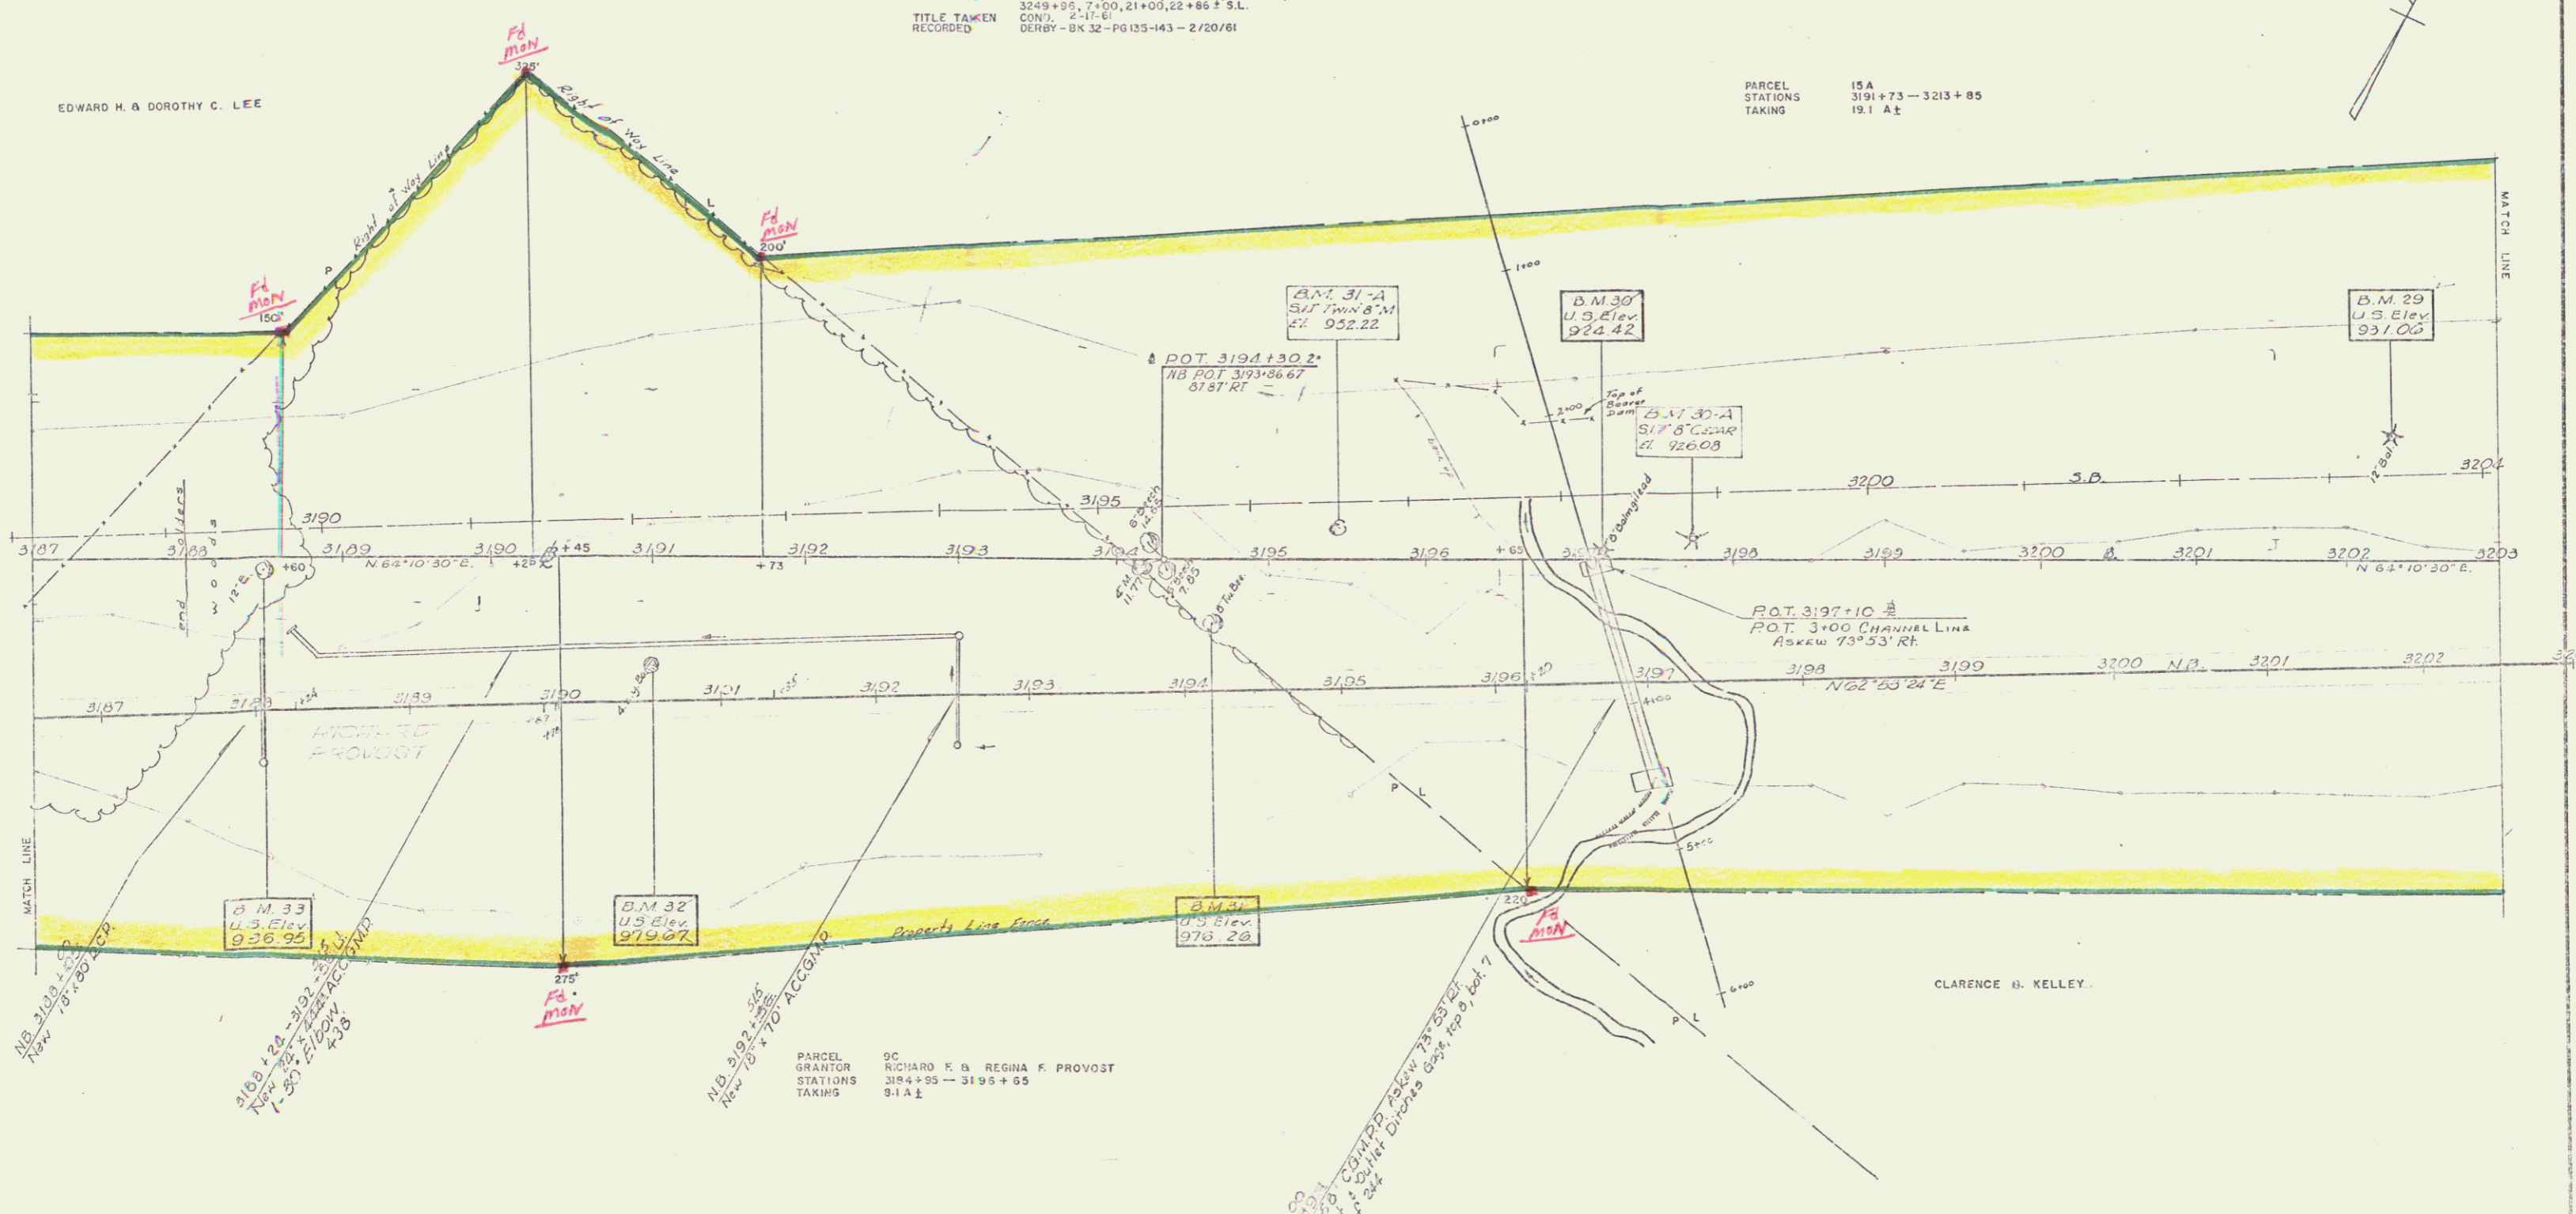

PARCEL 9C
GRANTOR RICHARD F. B. REGINA F. PROVOST
STATIONS 3194+99 - 3195+65
TAKING 9.1 A ±

CLARENCE B. KELLEY

DERBY
Project I 91-3 (A)
Surveyed by Spaulding 87 30
Plotted by [unclear] by [unclear]
Sheet 29 of 29

JUL 11 1974 15

3 CABLE GUARD RAIL ITEM 543
 LT 3203+00-3209+00. RT 3203+00-3209+00
 3211+82-3212+23 3211+38-3212+35

CONSTRUCT DRIVE
 U.S. 5 13+50-15+19 LT
 U.S. 5 7+15 LT


STONE FILL FOR SLOPE PROTECTION
 U.S. 5 14+80 LT - 15+10 LT

SEEDING ITEM 61 (S.W.M.)
 STA 3209+00-3210+00 LT
 STA 3211+00-3212+00 LT
 PARCEL STATIONS TAKING 15 D 3215+50 ML - 3+00 U.S. 5 39.4 A ±

PROPERTY LINE FENCE
 W/ STEEL POSTS MOD ITEM 533.B
 3204+00 - 3207+25 RT
 3208+35 - 3209+15 LT
 3209+25 - 3209+65 RT
 3210+13 - 3210+05 LT
 3210+05 - 3210+78 LT
 3210+78 - 3210+00 LT
 3210+40 - 3210+45 RT
 3210+45 - 3210+00 RT
 NB 3211+00 - 3210+00 LT
 NB 3211+30 - 3210+00 LT
 NB 3211+80 - 3210+00 LT
 NB 3211+30 - 3210+00 LT

CLARENCE B. KELLEY

POOR ORIGINAL COPY

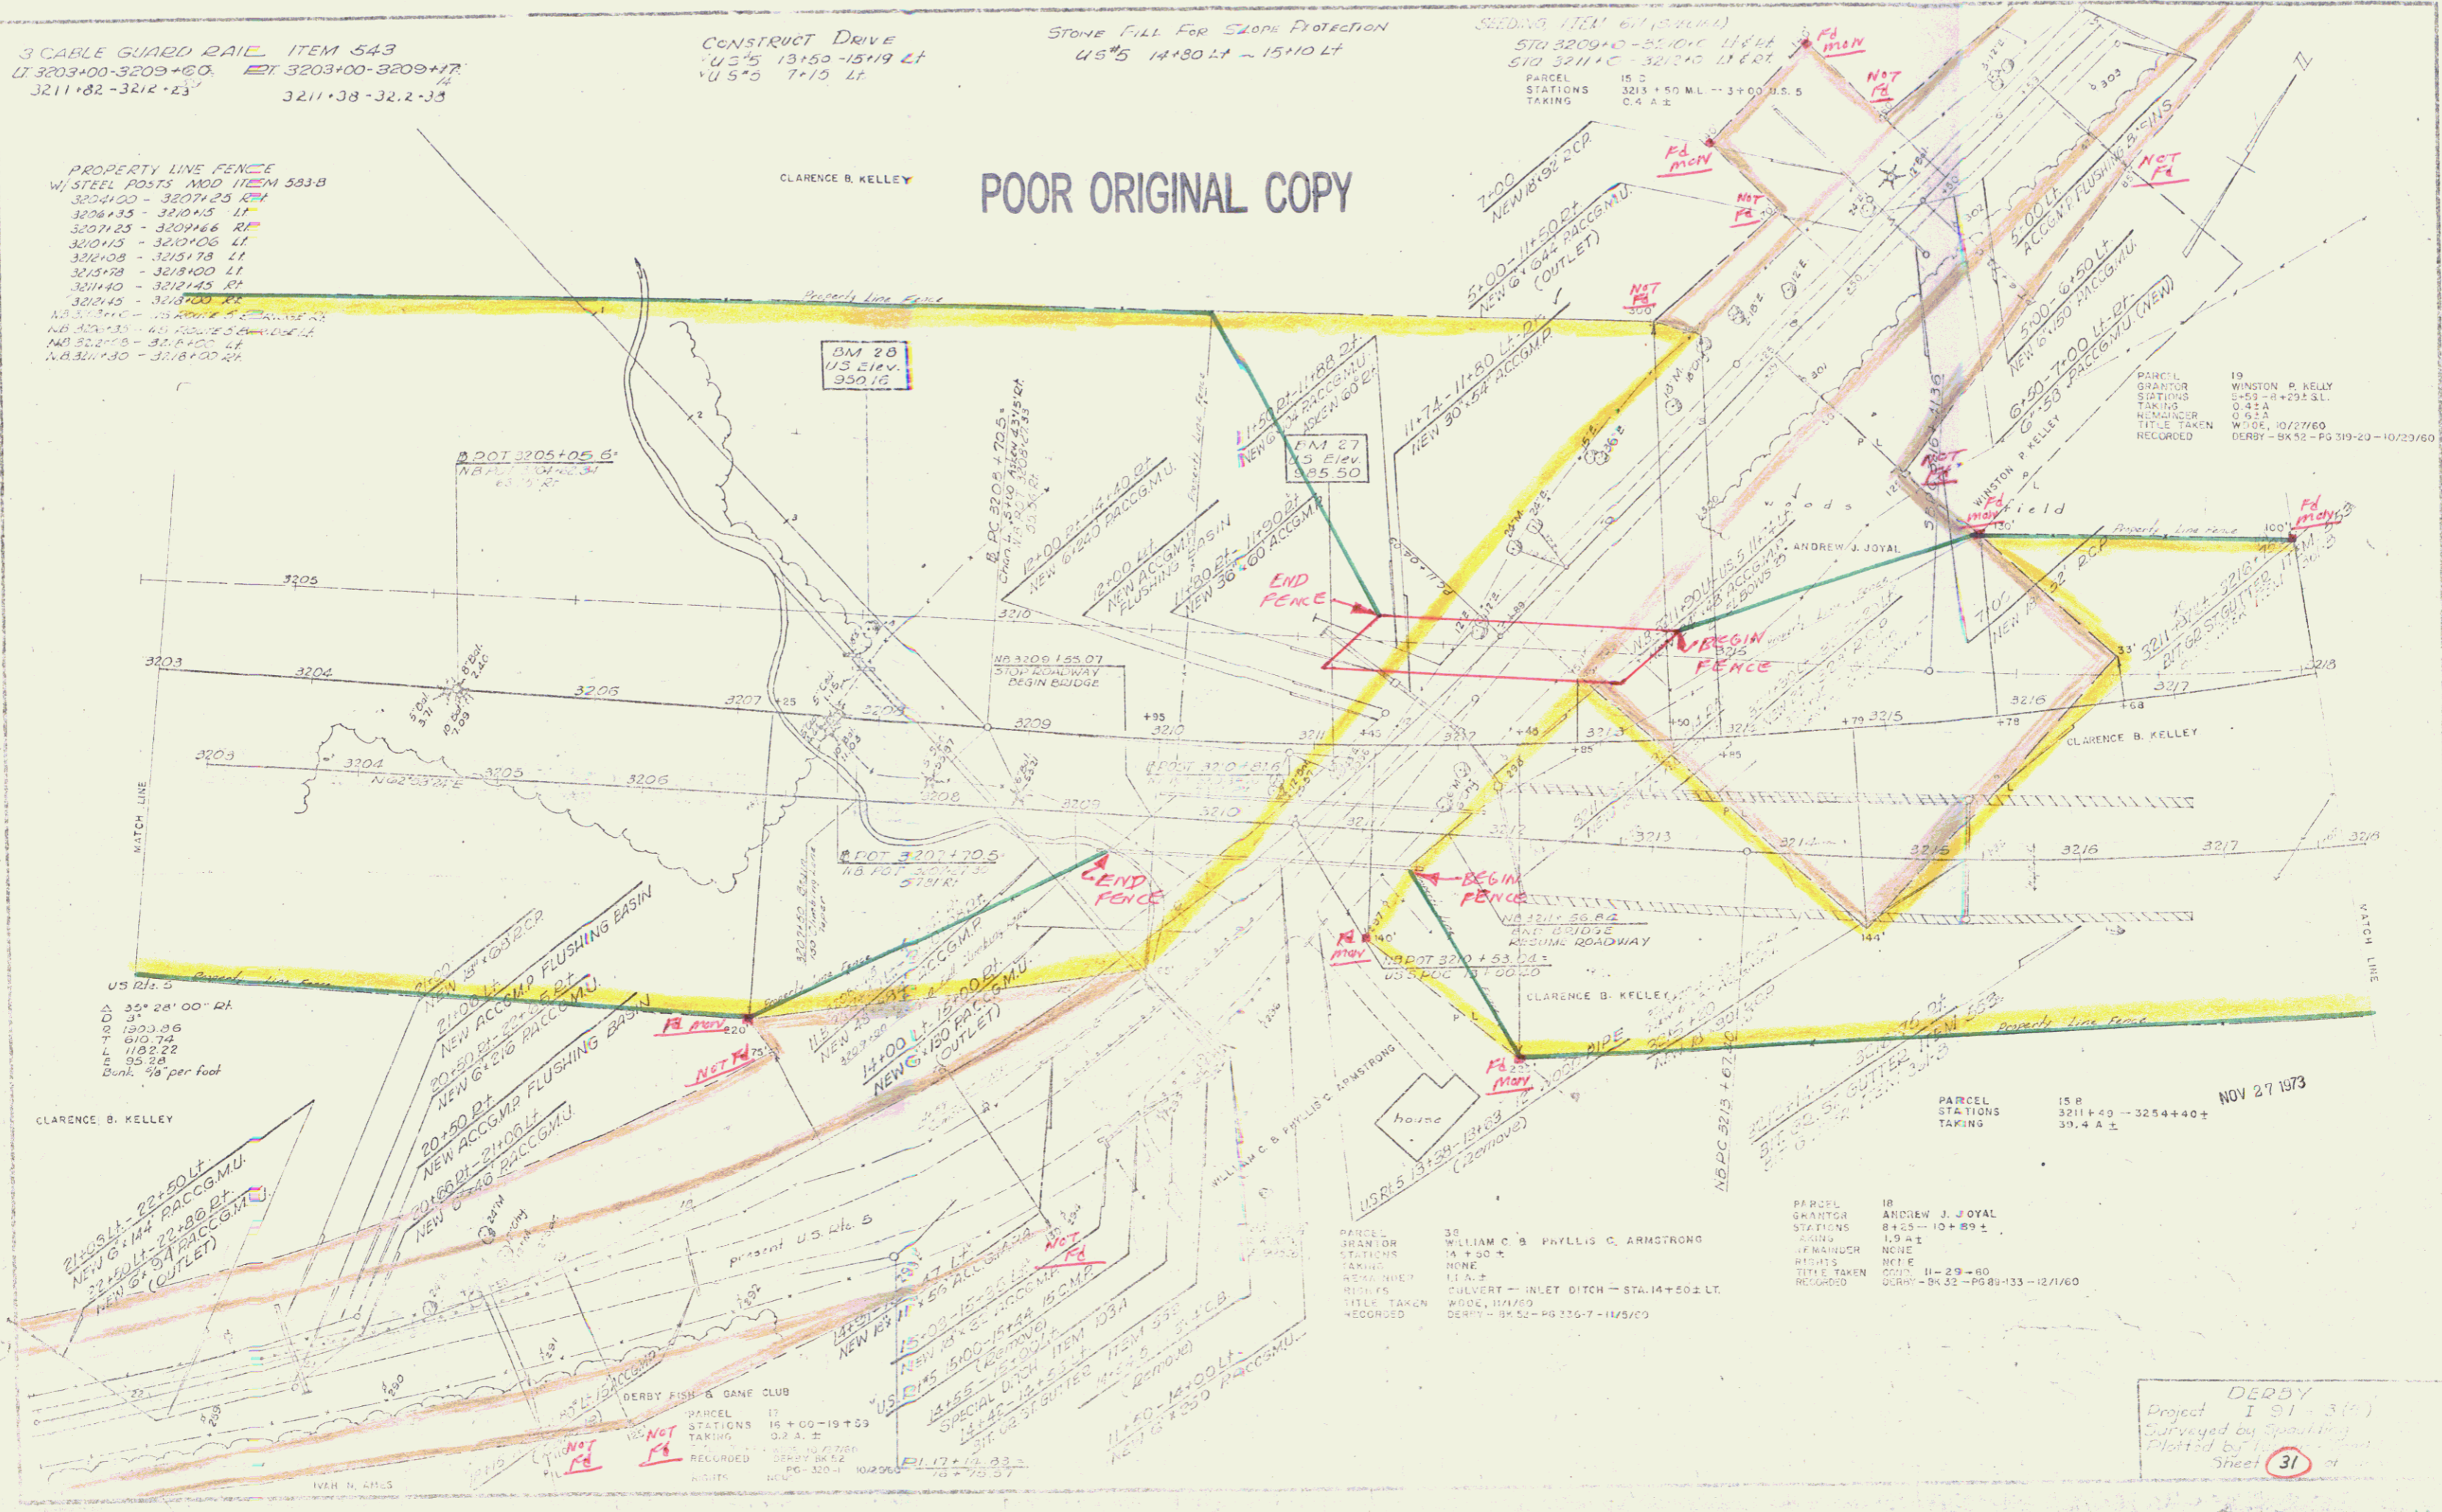

PARCEL GRANTEE STATIONS TAKING RECORDED
 19 WINSTON B. KELLY
 8+53 - 11+29.5 L
 0.6 A ±
 W/06, 10/27/60
 DERBY - BK 32 - PG 319-20 - 10/23/60

PARCEL STATIONS TAKING 15 B 3211+40 - 3254+40 ± 39.4 A ± NOV 27 1973

PARCEL GRANTEE STATIONS TAKING RECORDED
 18 ANDREW J. JOYAL
 8+03 - 10+89 ±
 1.0 A ±
 NONE
 NONE
 11-29-60
 DERBY - BK 32 - PG 89-133 - 12/1/60

PARCEL GRANTEE STATIONS TAKING RECORDED
 33 WILLIAM C. B. PHYLLIS C. ARMSTRONG
 14+50 ±
 NONE
 NONE
 11 A ±
 CULVERT - INLET DITCH - STA. 14+50 ±
 W/06, 11/1/60
 DERBY - BK 32 - PG 326-7 - 11/5/60

DERBY
 Project I 91-3(1)
 Surveyed by Spaulding
 Plotted by
 Sheet 31

CABLE GUARD RAIL ITEM 5+3
2+82 - 4+10 L.T. 3+49 - 4+12 R.T.

NOTE: EXACT ROUTING & SCHEDULING OF UTILITIES -
AS DIRECTED BY THE ENGINEER

CONSTRUCT DRIVE
THIS LT

DRILLING & BLASTING OF SOLID ROCK SUBGRADE
29+50-10+00 ITEM 14 MOD.

Δ 6° 08' LT
D 1° 30' LT
R 3019.0
T 204.6
L 400.9
E 5.47
Bnk 5 1/16"

CLARENCE B. KELLEY

PARCEL STATIONS TAKING
15 C 3+00 - 5+39
0.1 A±

PARCEL STATIONS TAKING
15 D 3213 + 50 M.L. - 3+00 U.S. 5
0.4 A±

FOR SALE
JOHN CAMPBELL REALTY
BOX 185, NEWPORT, VT.

U.S. ROUTE #5 STA. 5+00
BEGIN CONSTRUCTION




DERBY - U.S. 5
1 21-3(2)
33 of 47
BY U.S. 5 L. 6 M.L. 3213 + 75 C

JUL 11 1974

17



20' 5"
4' 11" 20"

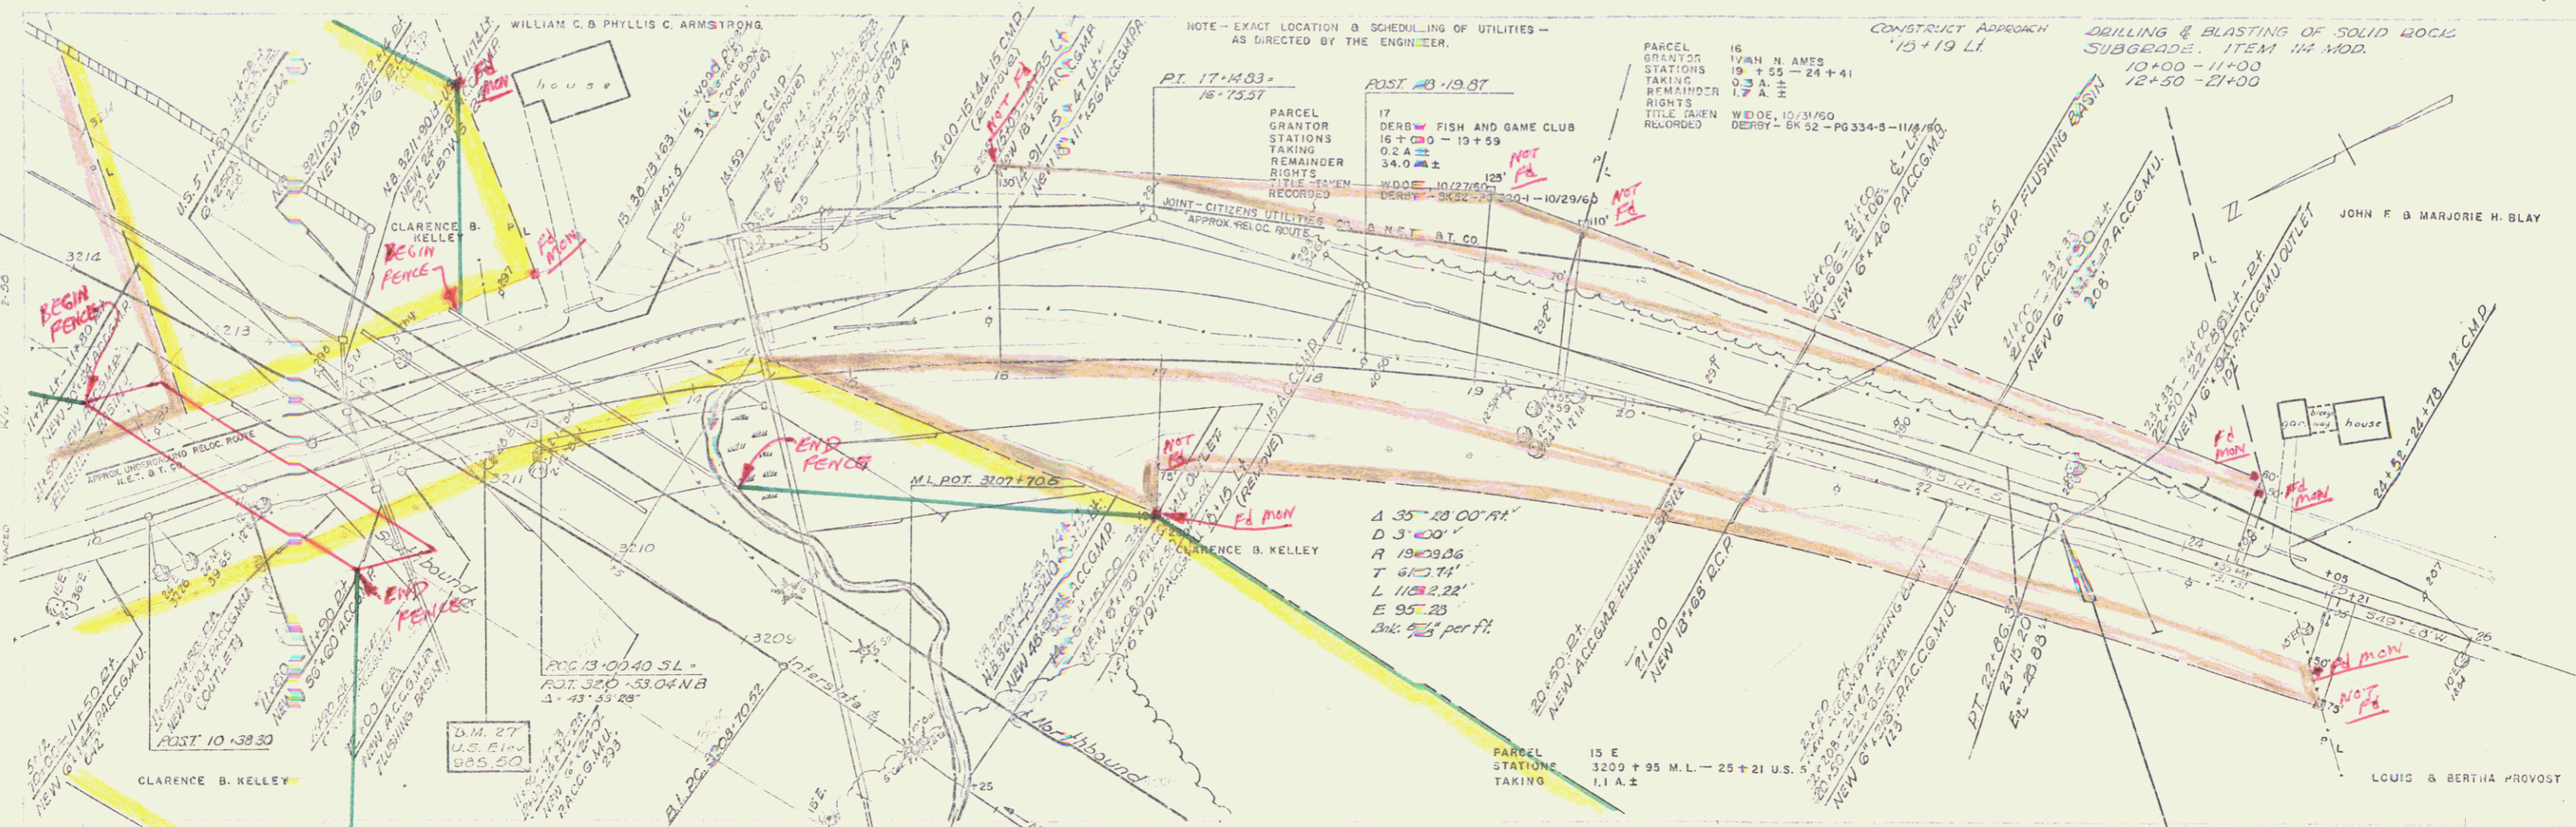

NOTE - EXACT LOCATION & SCHEDULING OF UTILITIES - AS DIRECTED BY THE ENGINEER.

CONSTRUCT APPROACH
15+19 LI
DRILLING & BLASTING OF SOLID ROCK
SUBGRADE - ITEM 114 MOD.
10+00 - 11+00
12+50 - 21+00


PARCEL 16
GRANTOR: WYNN N AMES
STATIONS: 19+55 - 24+41
TAKING: U.S.A.
REMAINDER: U.S.A.
RIGHTS: U.S.A.
TITLE TAKEN: U.S.A.
RECORDED: WYNN N AMES - BK 52 - PG 334-5 - 11/18/60

PARCEL 17
GRANTOR: DERBY FISH AND GAME CLUB
STATIONS: 15+00 - 19+59
TAKING: 0.24 ±
REMAINDER: 34.0 ±
RIGHTS: 15' ±
TITLE TAKEN: 10/27/60
RECORDED: DERBY - BK 52 - PG 334-5 - 10/29/60

A 35° 28' 00" R
D 3' 00"
R 1900.26
T 61° 27'
L 1138.22'
E 95' 23"
Bk: 7/15 per ft.

U.S. ROUTE # 5 STA 22+86.32 =
23+15.20
END CONSTRUCTION

EQUATION
-23.88'

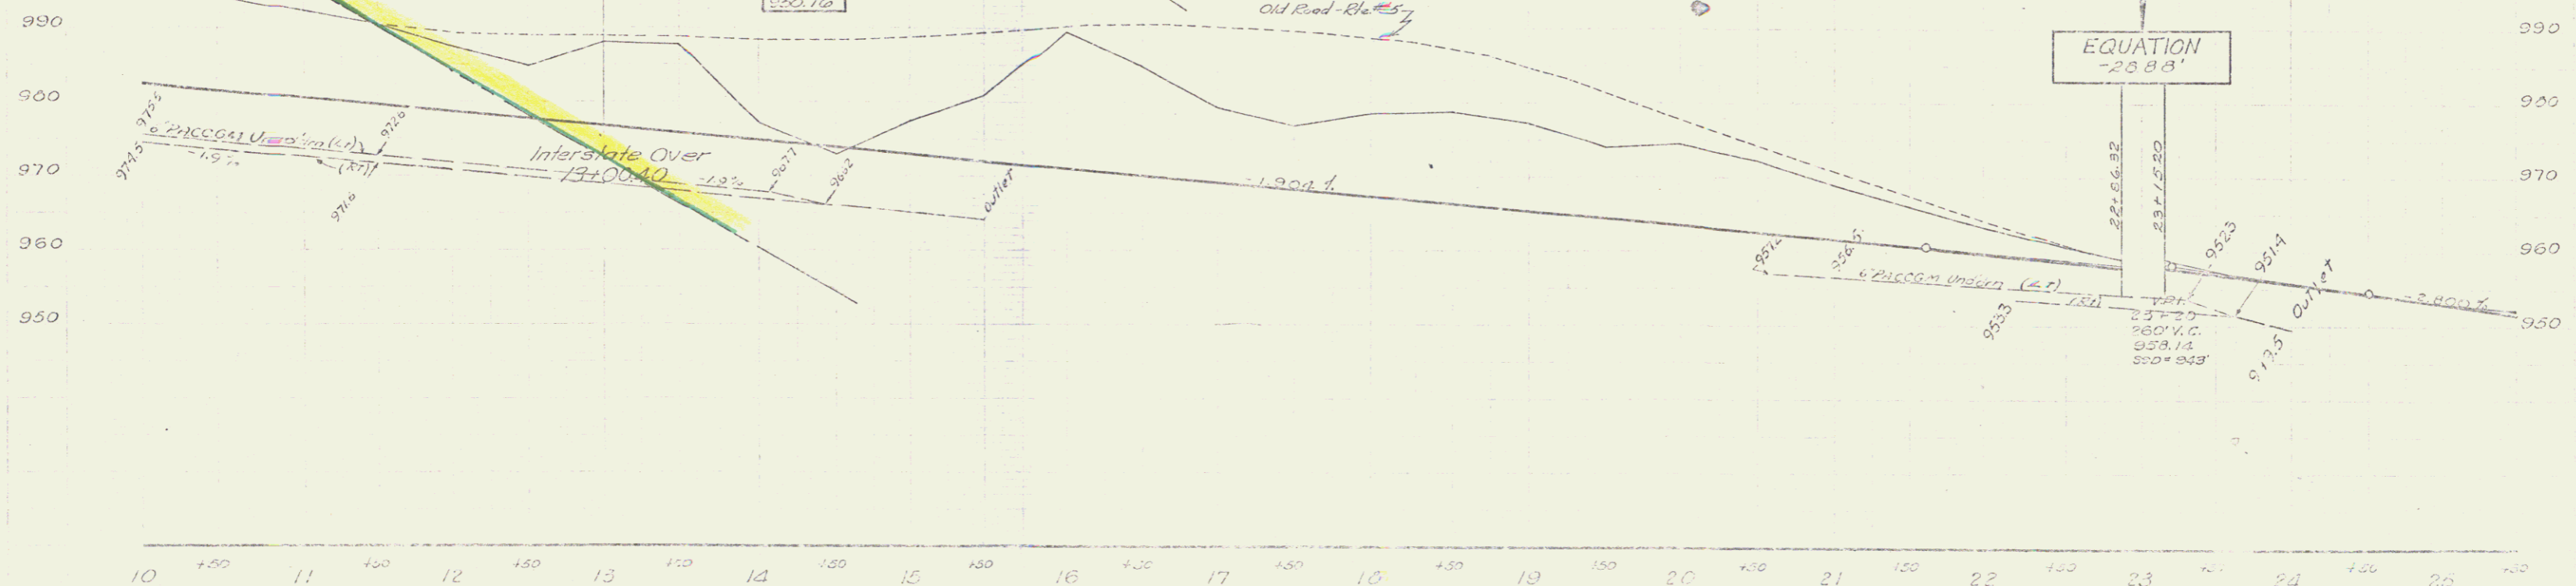

DERBY - U.S. 5
3 (S)
34
JUL 11 1974


PROPERTY LINE FENCE
W/STEEL POSTS ITEM 323-B
3218+00 - 3233+00 LT
3229+45 - 3233+00 RT

DRILLING & BLASTING of SOLID
ROCK SUBGRADE ITEM 114, MOD
3217+25 - 3221+39
3221+80 - 3227+70
3231+85 - 3234+00

THREE CABLE GUARD RAIL
with STEEL POSTS
3227+56 LH - 3231+00 LH
3227+56 RH - 3231+04 RH
3228+50 LH - 3230+27 RH
3228+70 LH - 3229+70 LH


DEMOLITION & REMOVAL OF BUILDING ITEM 586
3226+70 LH (2)

BASE LINE	NORTHBOUND	SOUTHBOUND
Δ 49° 41' LT	Δ 41° 23' 58" LH	Δ 41° 03' 40" LH
D 15.30'	D 2° 00'	D 2° 30'
T 5819.72	T 2864.79'	T 2231.83
L 1492.45	L 1082.47/1082.09	L 850.32
E 2045.55	E 2089.92/2071.04	E 1642.53
R 201.21	R 197.69	R 155.45
	Bank 7/6 per ft.	Bank 7/6 per ft.

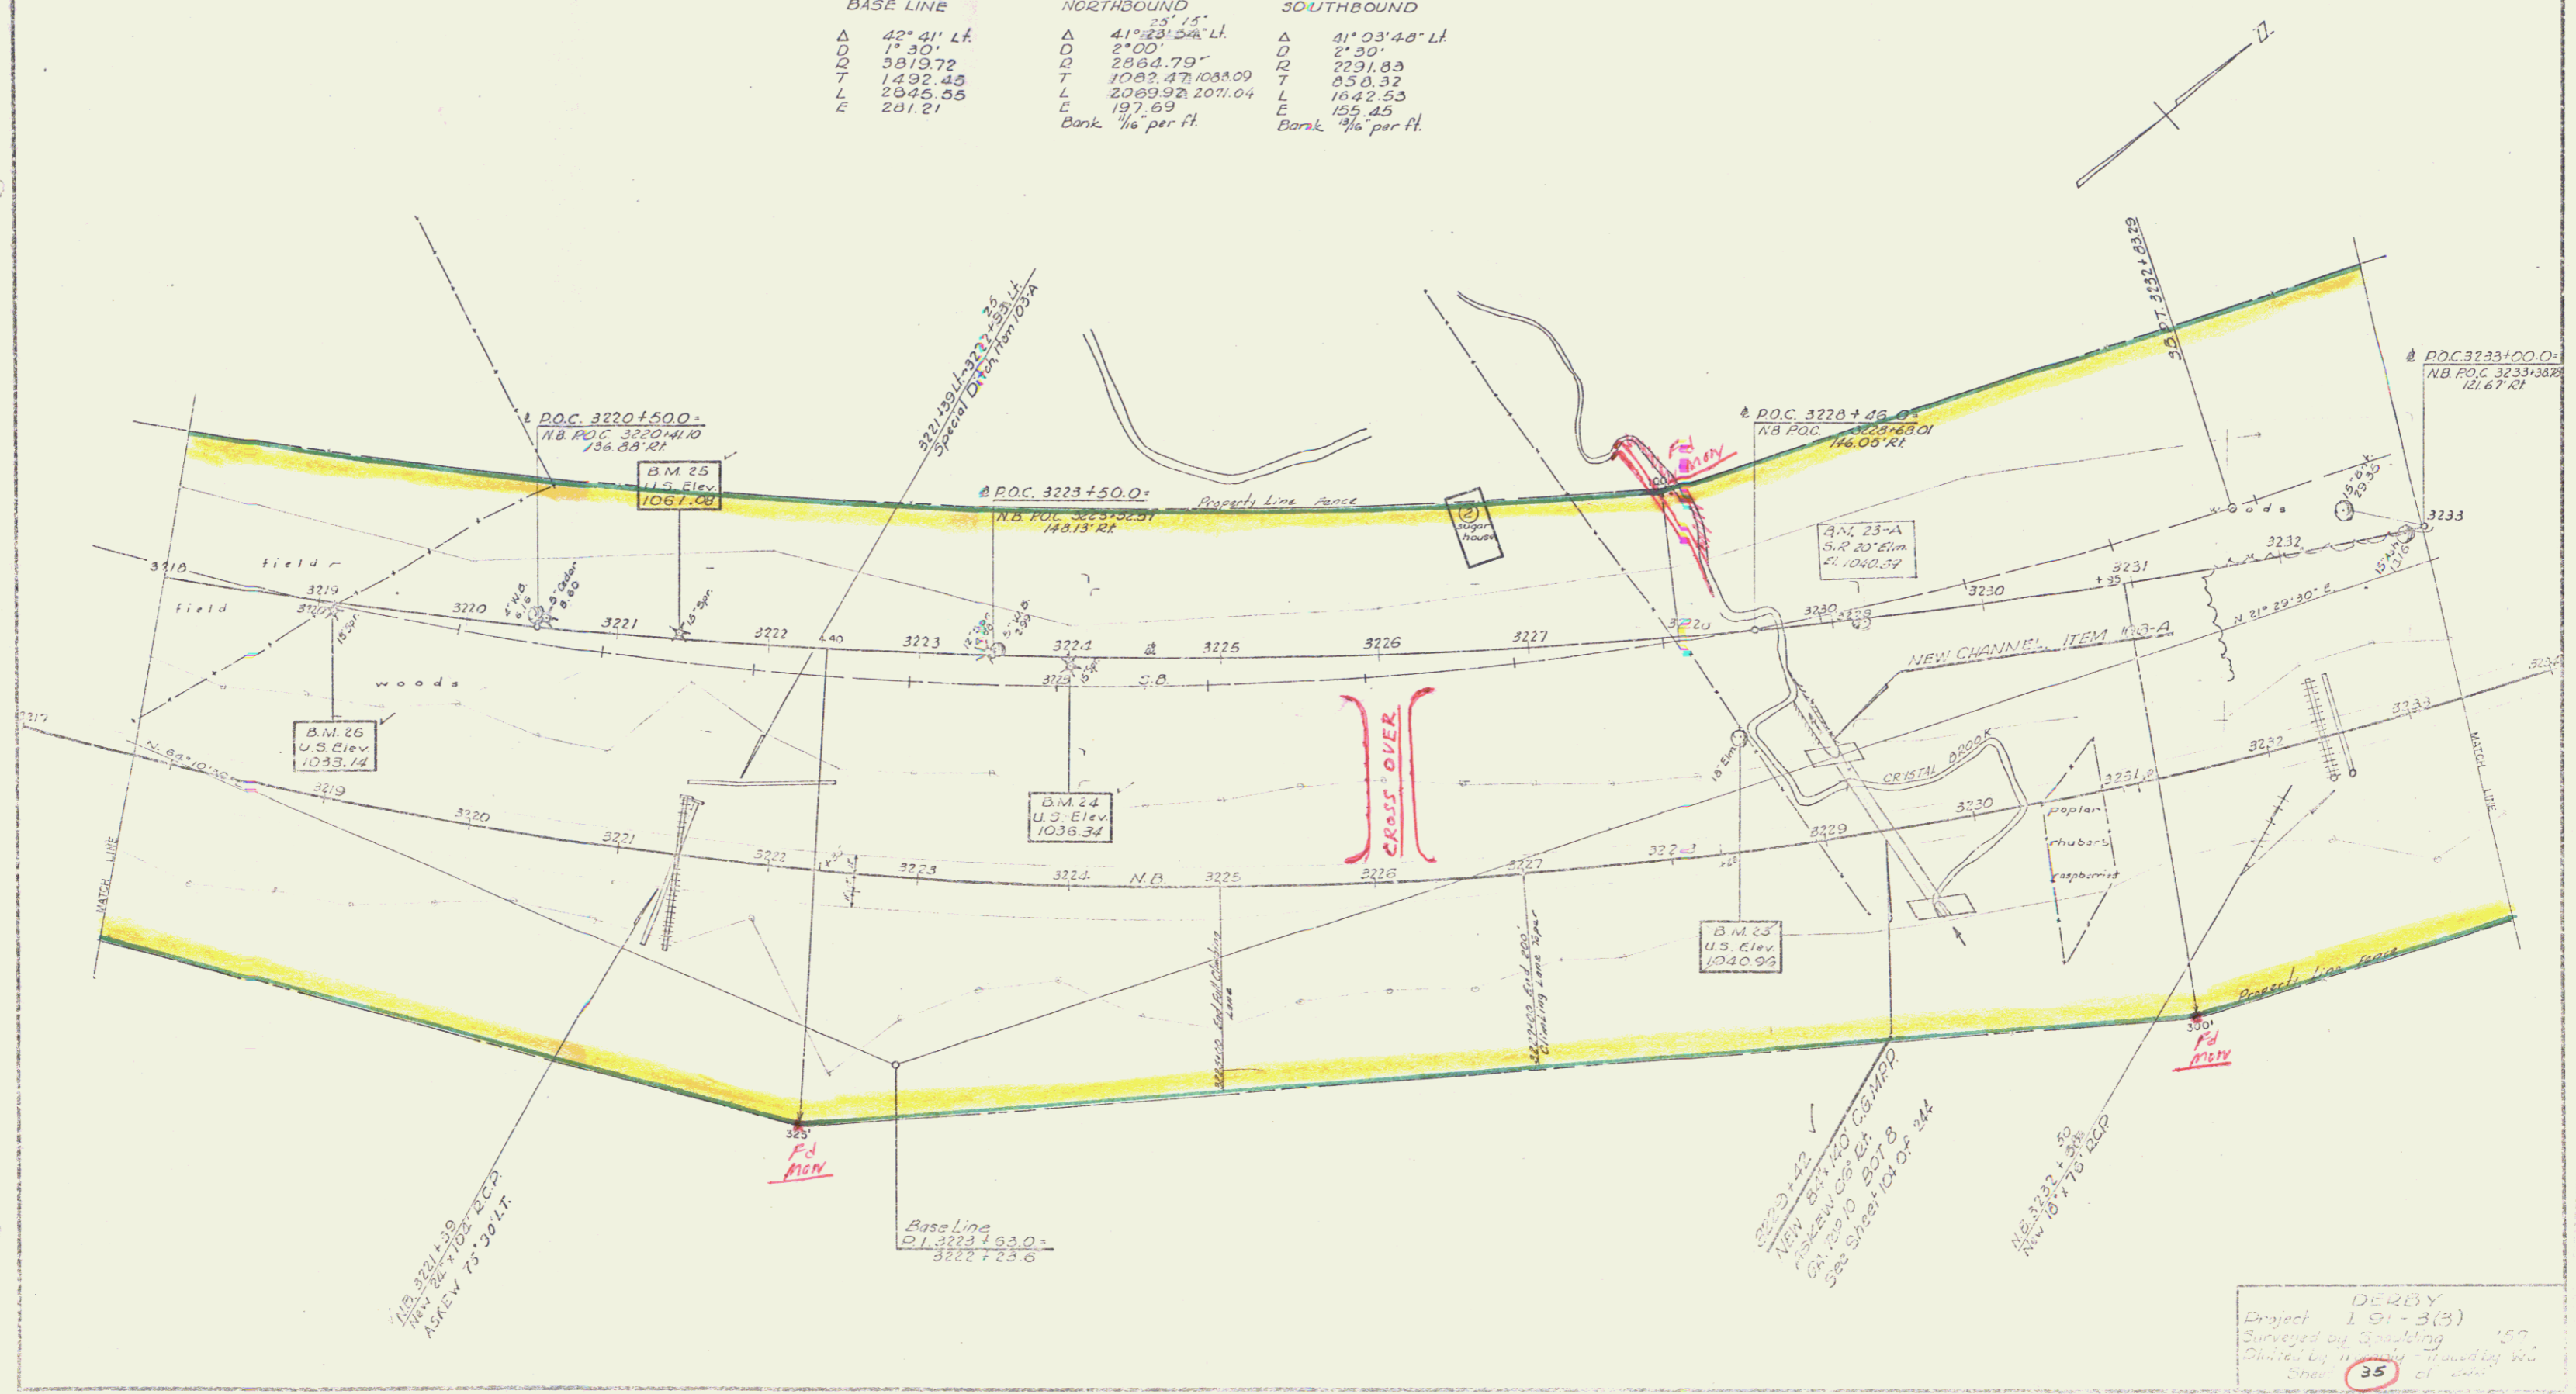

DERBY
Project 191-3(B)
Surveyed by [unclear]
Checked by [unclear] Drawn by [unclear]
Sheet 35 of [unclear]

35 JUL 11 1974

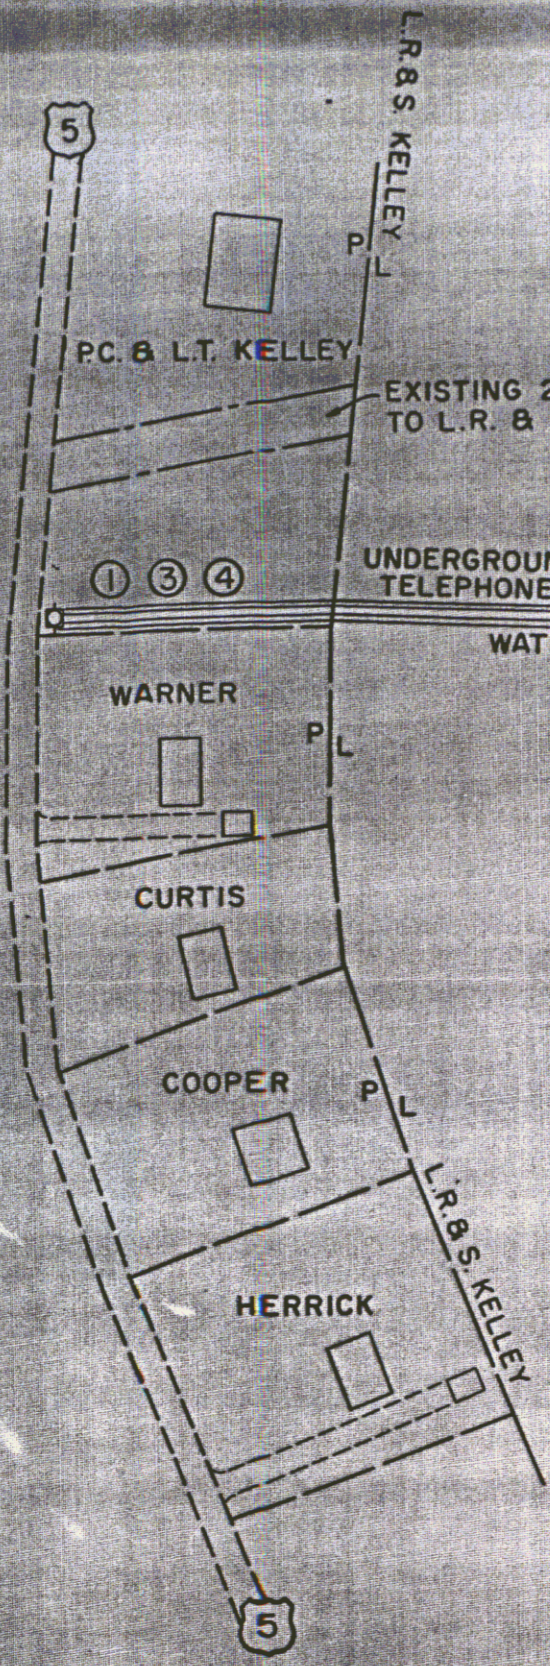

- ① WARRANTY DEED OF EASEMENT
PC & L.T. KELLEY TO ST. OF VT.
BOOK 62, PAGES 94,95
AUGUST 29, 1968
- ② WARRANTY DEED
L.R. & S. KELLEY TO ST. OF VT.
BOOK 62, PAGES 99-101
SEPT. 27, 1968
- ③ AGREEMENT
ST. OF VT. & INTERNATIONAL WATER CO.
BOOK 62, PAGES 130,131
NOV. 8, 1968
- ④ AGREEMENT
ST. OF VT. & VILL. OF DERBY LINE
BOOK 62, PAGES 132,133
NOV. 8, 1968

NB 3244+65
387' LT.

NB 3244+65
447' LT.

NB 3242+16
447' LT.

NB 3241+66
447' LT.


EXISTING 25' R.O.W.
TO L.R. & S. KELLEY

UNDERGROUND TELEPHONE

UNDERGROUND ELECTRICAL POWER


WATER LINE

SEWAGE LINE

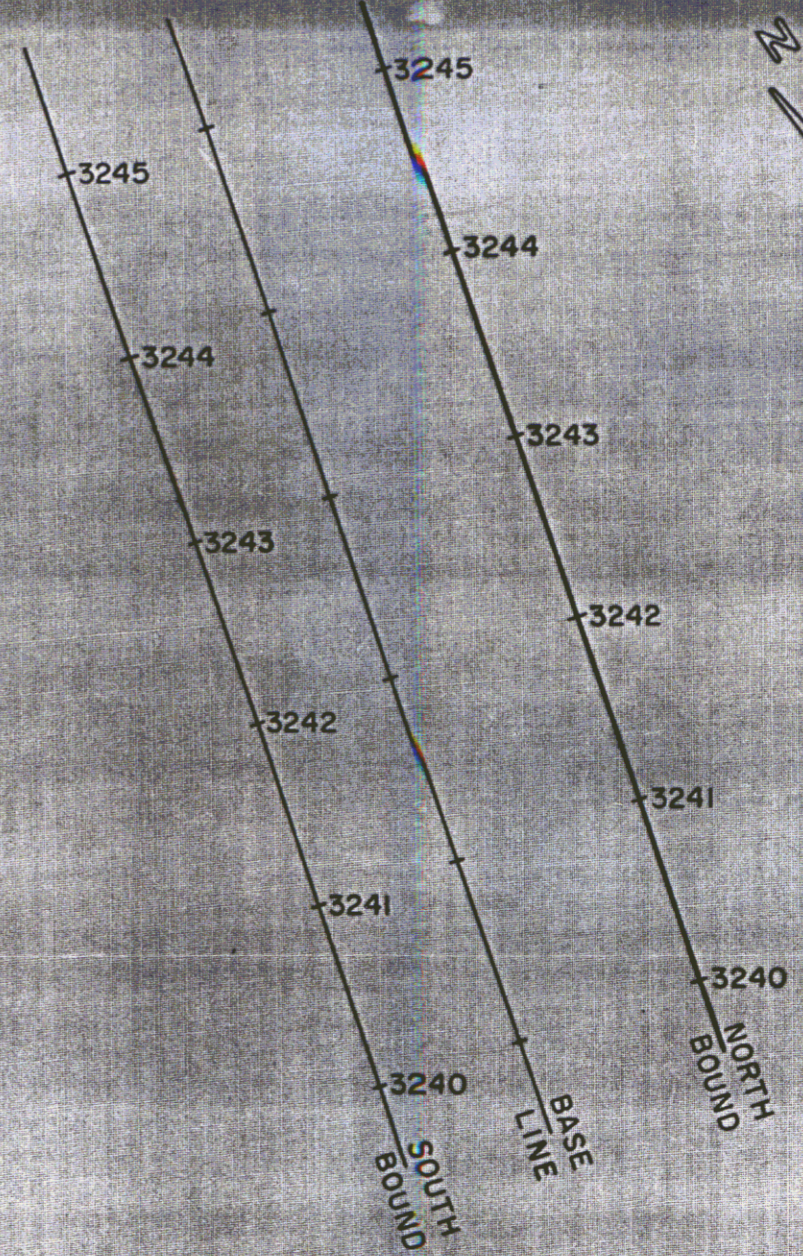

*QCD to Village of Derby Line: all rti
to sewer pipeline & r-o-w. BK 69 Pg 450,1*

*QCD to International Water Co.: all rti
to water pipeline & r-o-w. BK 64 Pg 452,3*

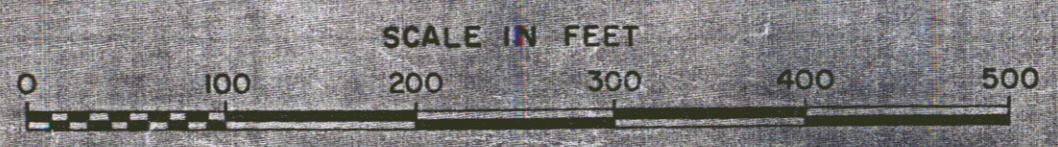

STATE OF VERMONT
DEPT. OF HIGHWAYS

PLAT OF REST AREA UTILITIES
TOWN OF DERBY
INTERSTATE ROUTE NO. 91 (39A)

PROJECT I 91-3 (21)

APPROX. SCALE 1"=100' DATE 12/27/73 DRAWN BY J.D.P.


PROPERTY LINE FENCE
W/ STEEL POSTS AND ITEM 503-A
3249+00 - 3263+00 L.R.
3248+00 - 3263+00 R.L.

DRILLING & BLASTING of SOLID
ROCK SUBGRADE ITEM 114, MOD
3248+00 - 3259+26

THREE CABLE GUARD RAIL
with STEEL POSTS
3248+00 L.R. - 3263+00 L.R.
3248+43 R.L. - 3263+00 R.L.

PARCEL GRANTOR STATIONS TAKING REMAINDER RIGHTS TITLE TAKEN RECORDED
20 LOUIS P & ANNA FORTIN
3253+15 - 3264+35 L
3253 ±
3263 ±
CULVERT - STA 3254+62, 3259+26
COND. 11/29/60
DERBY - BK 32 - PG 89-133 - 12/1/60

PARCEL GRANTOR STATIONS TAKING REMAINDER RIGHTS TITLE TAKEN RECORDED
21 AUSTIN T. & MARJORIE FOSTER
3260+40 - 3277+50 ±
13.3A ±
31.7
CULVERT - STA 3263+00, 3266+68, 3272+00
COND. 11/29/60
DERBY - BK 32 - PG 89-133 - 12/1/60

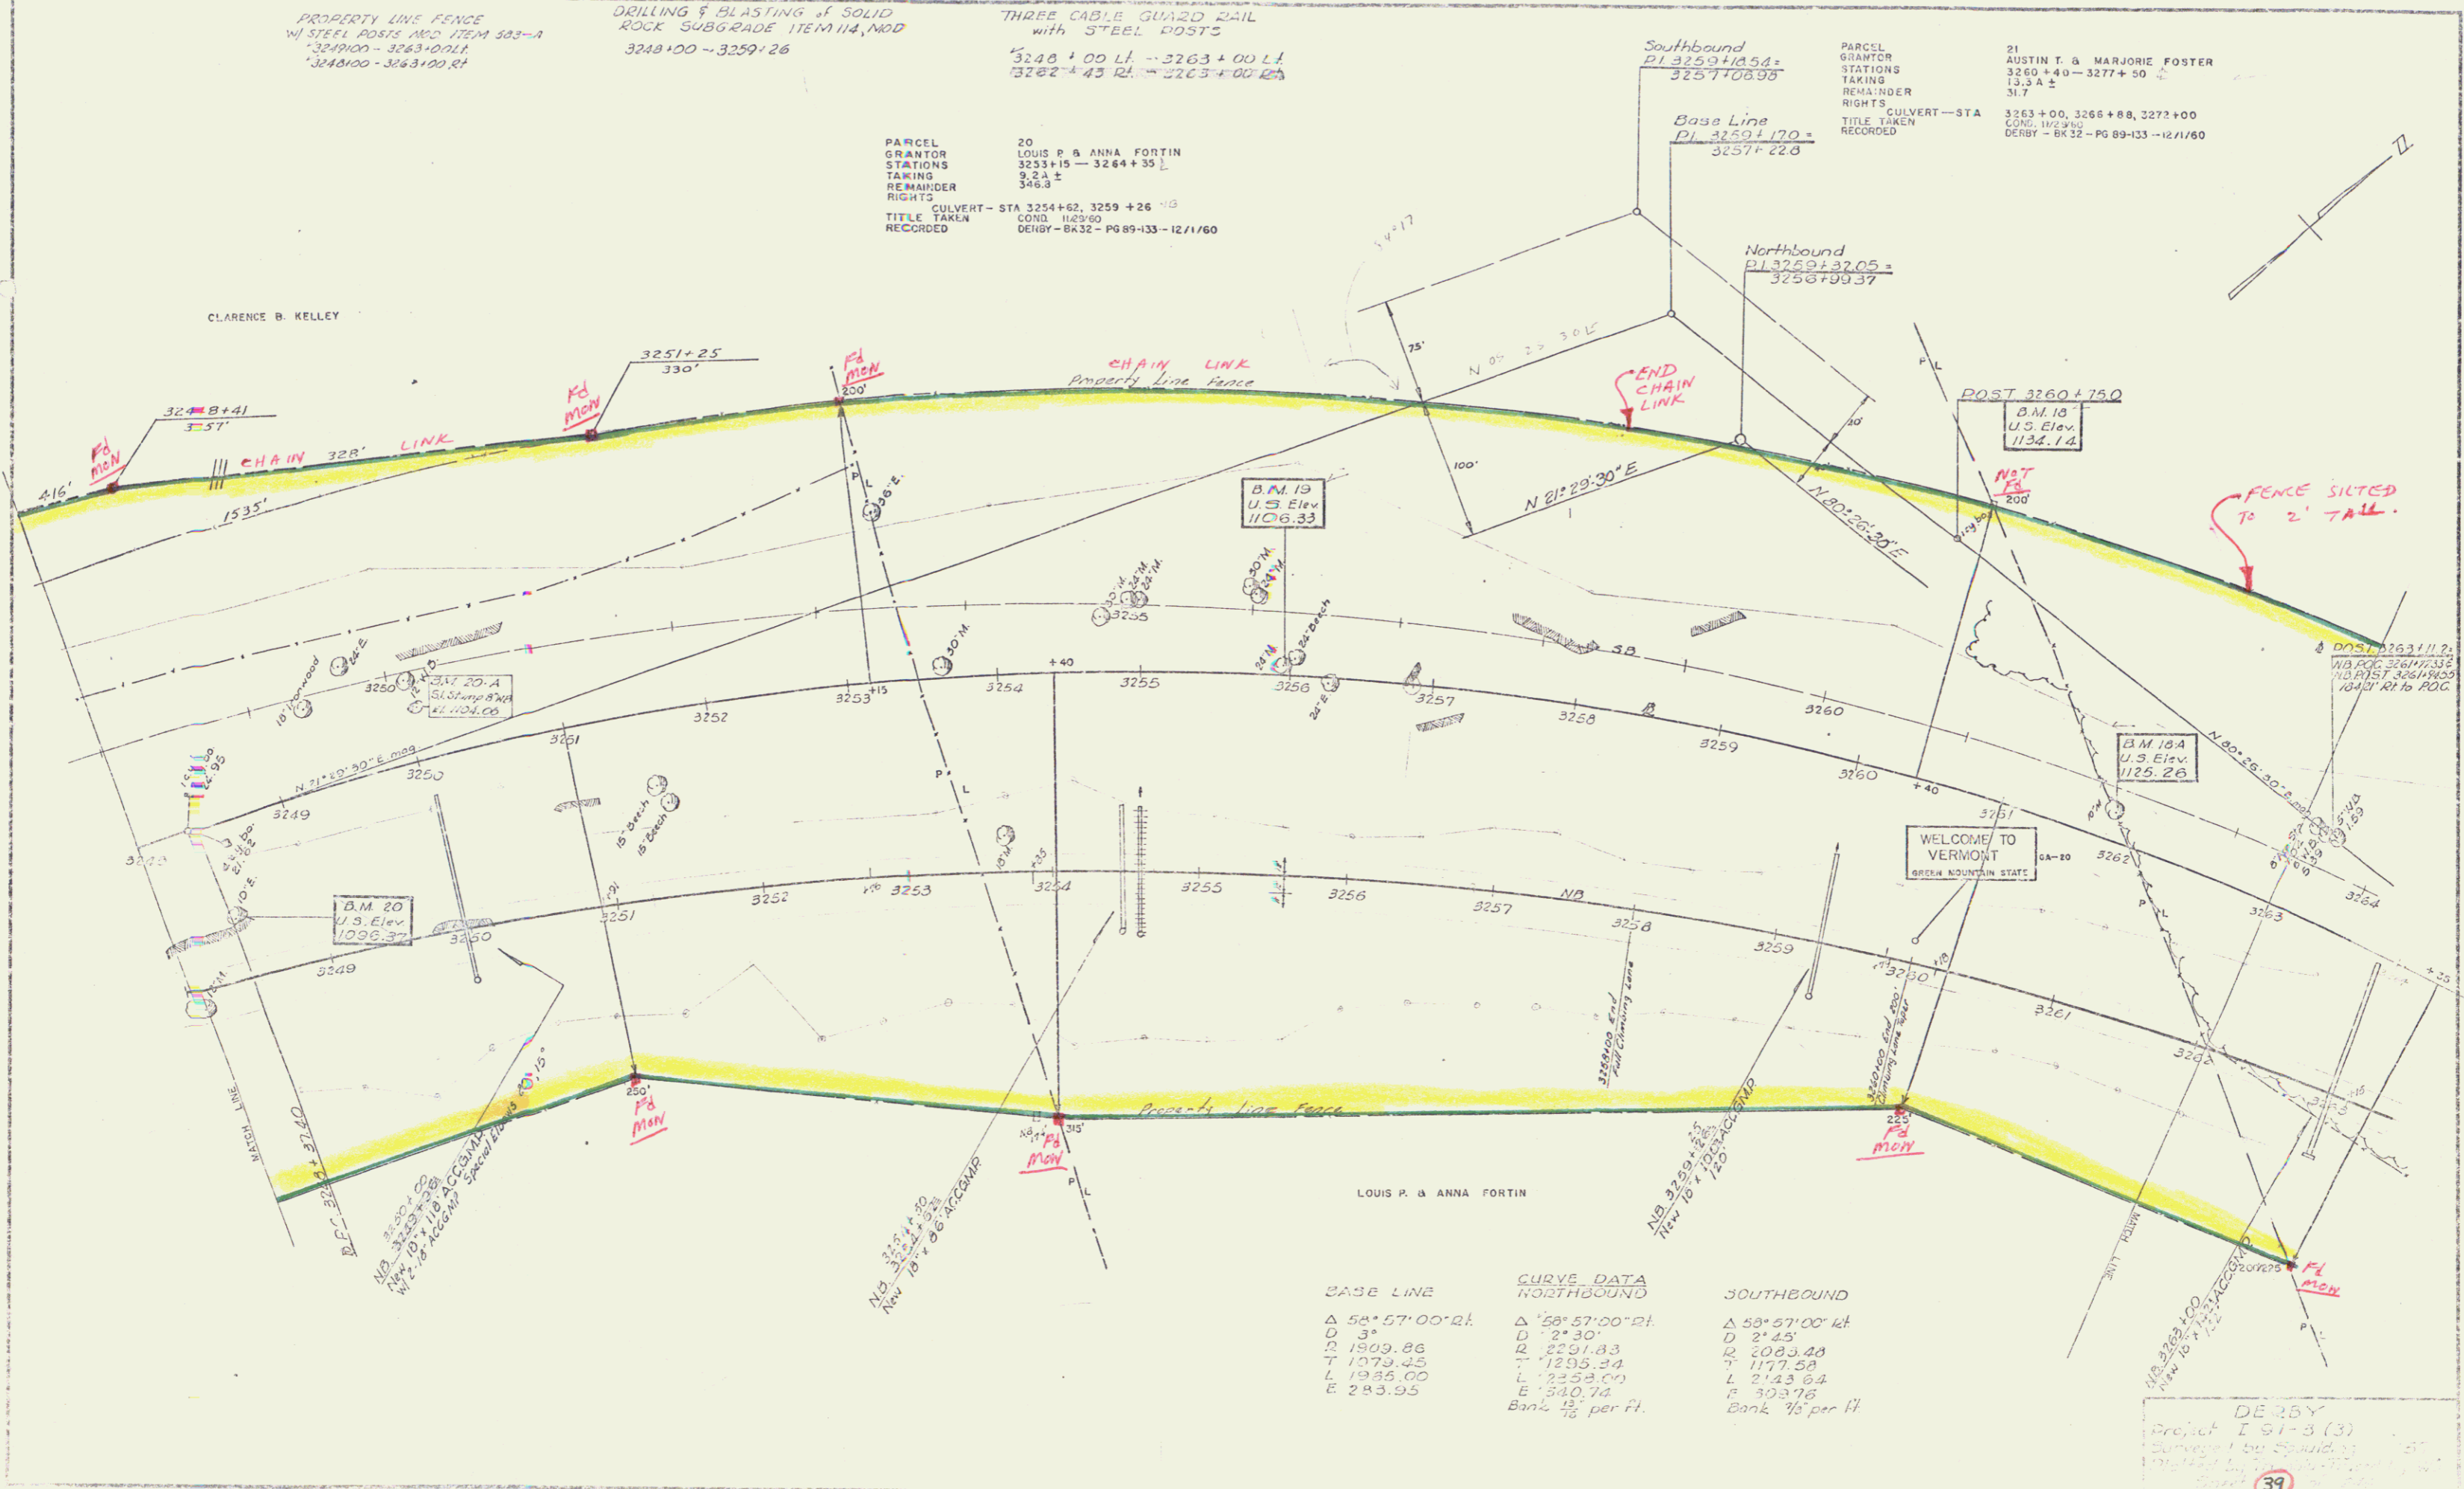

BASE LINE	CURVE DATA NORTHBOUND	SOUTHBOUND
Δ 58° 57' 00" R.L.	Δ 58° 57' 00" R.L.	Δ 58° 57' 00" L.L.
D 3'	D 2' 30"	D 2' 45"
R 1809.86	R 2291.83	R 2083.48
T 1079.45	T 1295.34	T 1177.58
L 1985.00	L 2353.00	L 2143.64
E 283.95	E 310.72	E 303.76
	Bank 15' per ft.	Bank 7 1/2' per ft.

DE 25Y
Project I 91-3 (3)
Surveyed by Squid
11/29/60
39

JUL 11 1974 22


THREE CABLE GUARD RAIL
 ITEM 543
 L.I. 3263+00 - 3269+72' - 3263+00 - 3267+67'

PROPERTY LINE FENCE
 W/STEEL POSTS MOD ITEM 363-B
 3263+00 - 3276+00 L.I.
 3263+00 - 3276+00 R.I.

DRILLING & BLASTING OF SOLID
 ROCK SUBGRADE ITEM 114 MOD.
 3269+37 - 3273+50

NOTE:
 1. ALL UTILITY RELOCATION ROUTES, APPROX. LOCATION ONLY
 2. EXACT LOCATION & SCHEDULING TO BE BY THE ENGINEER
 3. CONTRACTOR TO DO ALL NECESSARY EXCAVATION & BACKFILLING
 FOR THE RELOCATION OF WATER LINES, SEWER LINES, SLEEVES,
 MANHOLES, HYDRANTS & APPURTENANCES.
 4. ALL UTILITY MATERIALS, EXCEPT SLEEVES, TO BE FURNISHED &
 INSTALLED BY OTHERS.

GRANITE SLOPE EDGING ITEM 556-A
 N.B. 3275+50 L.I. - 3276+50 L.I. LENGTH 100'

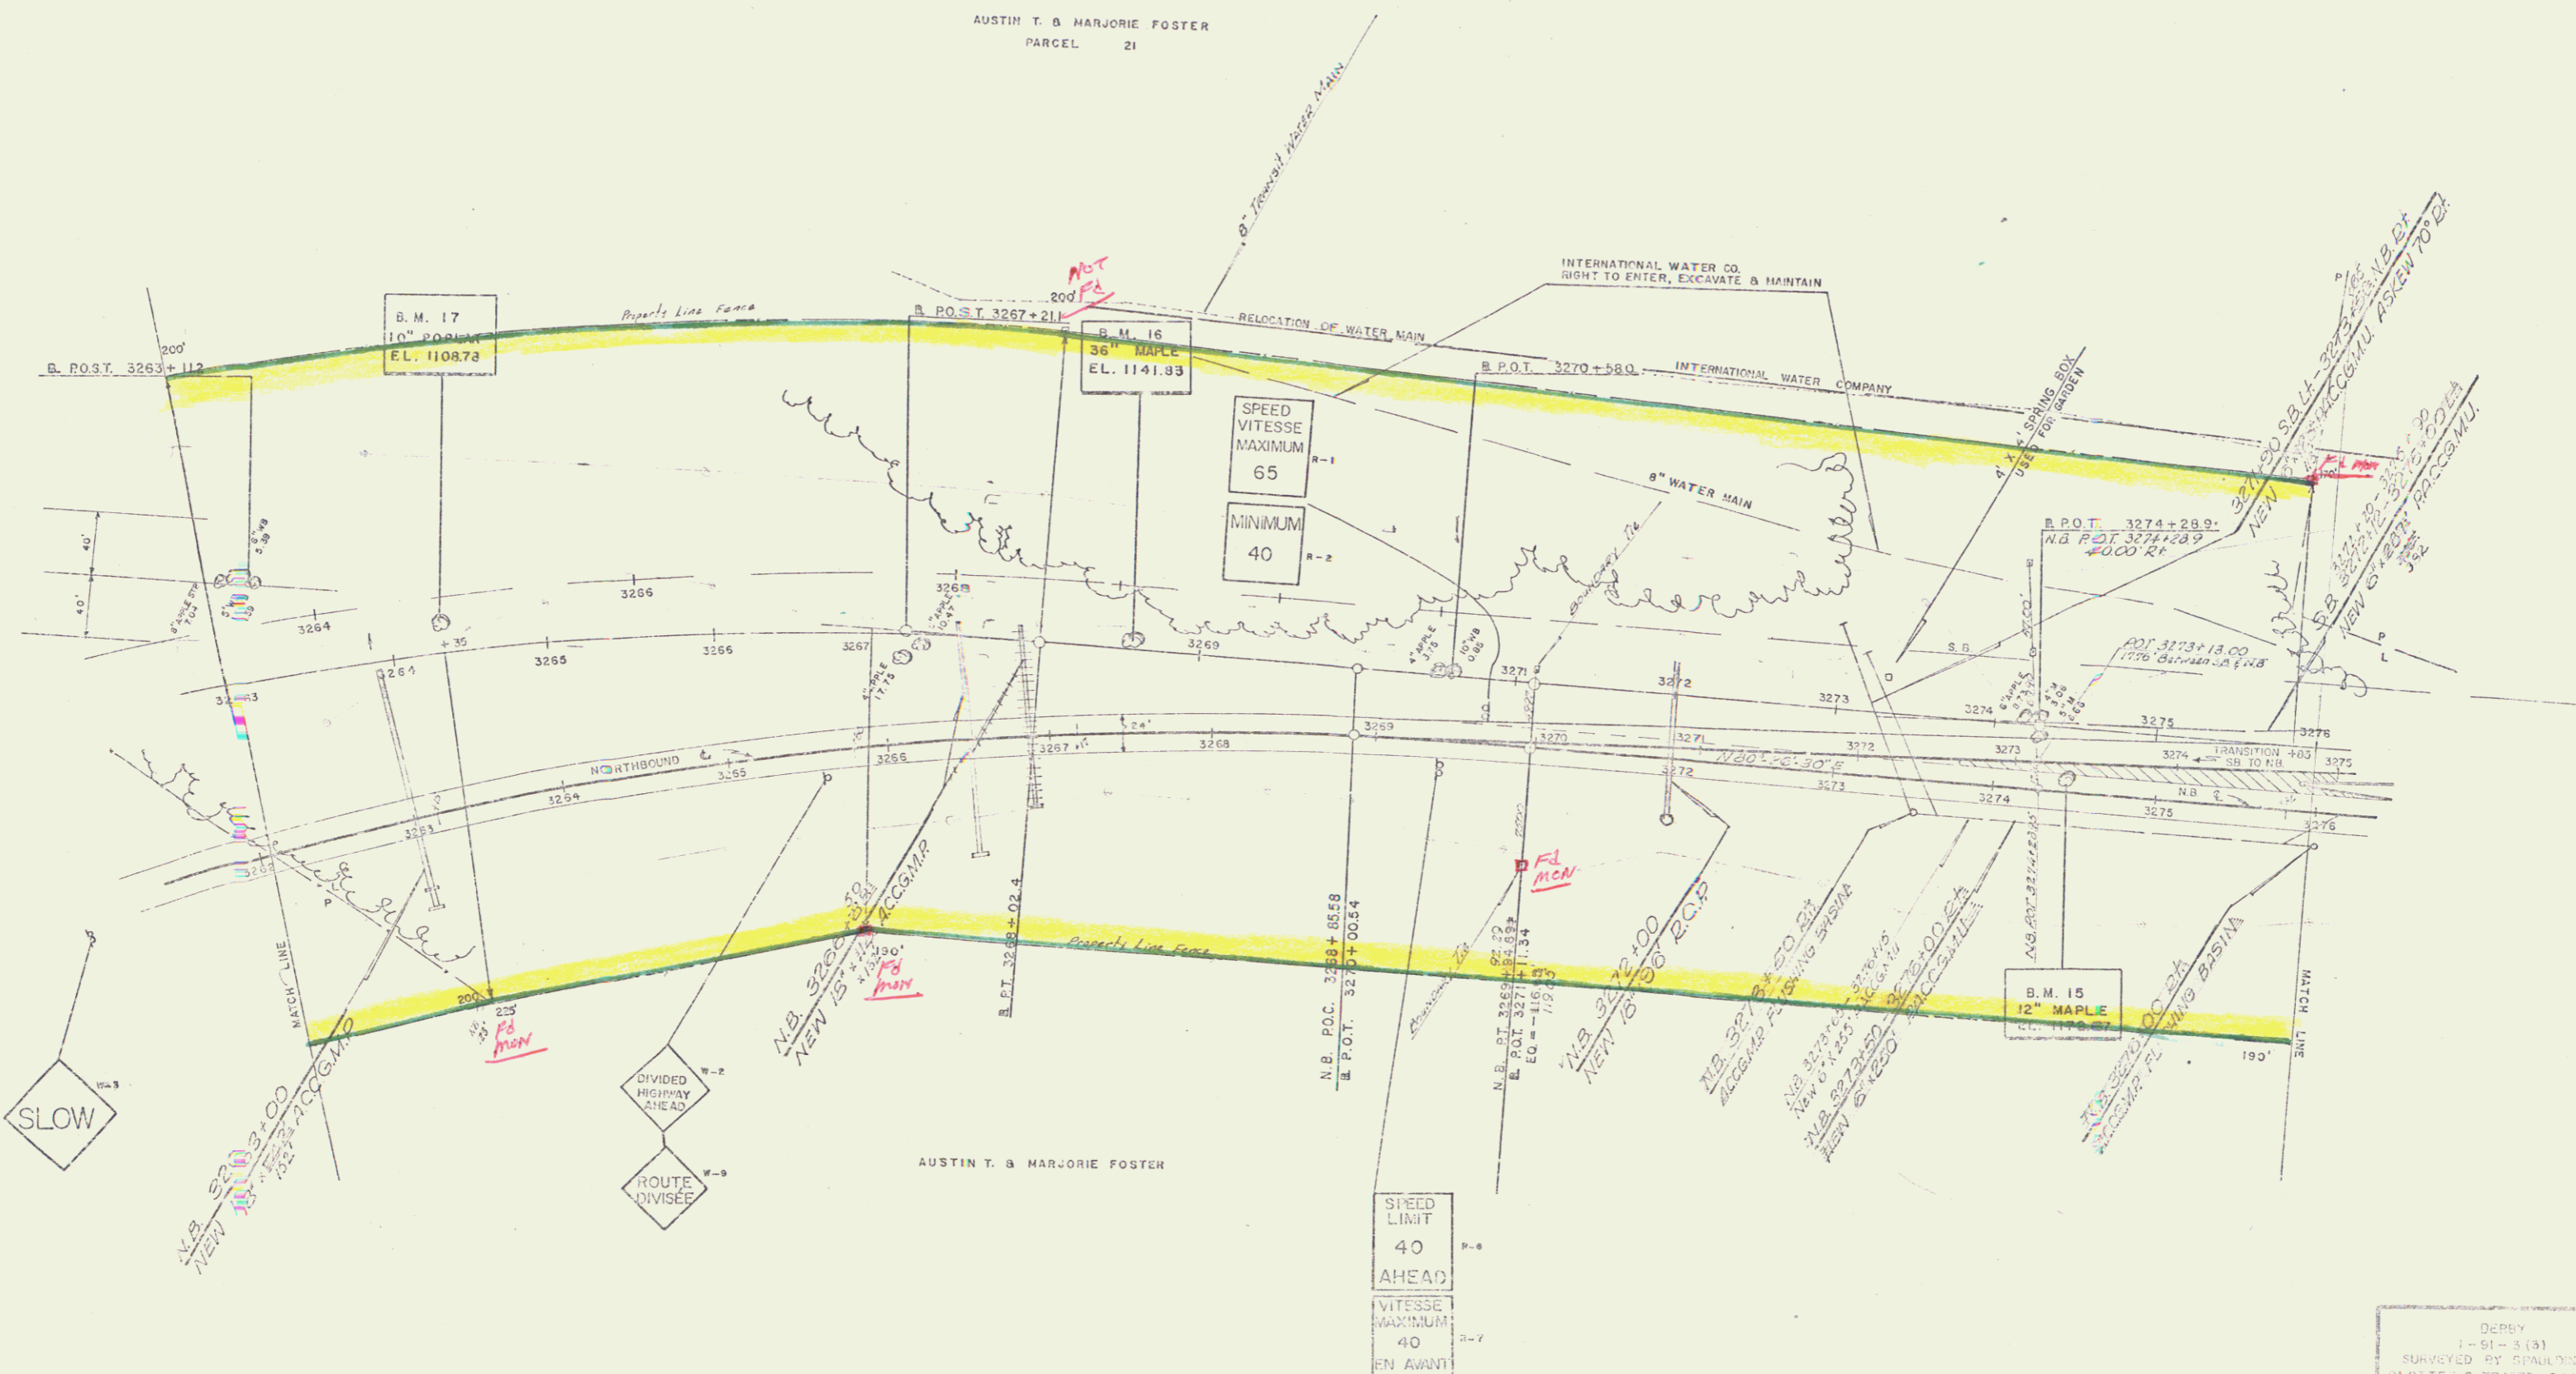

DeBry
 1-51-3(3)
 SURVEYED BY: [Signature]
 PLOTTED & RECORDED - CUMULATIVE
 SHEET 41 OF 147

JUL 11 1974

DRILLING & BLASTING OF SOLID ROCK
SUBGRADE ITEM 114 MOD.
3276+00 - 3281+50

EXCAVATION & REMOVAL OF ROAD
SURFACE ON ROADWAYS, ITEM 118-A
PELOW ST. 7+00 - 8+70

AUSTIN T. FOSTER

PROPERTY LINE FENCE
W/STEEL POSTS MOD ITEM 333-B

3276+00 - 3279+30 L&S B RAMP

3279+30 - 3281+50 RR TO CROWELL AVE

3281+50 - 3281+63 RA

3281+63 - 3281+60 RA

3281+60 - 3281+60 RA

3281+60 - 3281+60 RA

LELAND C. & HELEN H. WOOD

PELOW ST. P.O. 11+33.8

HIGHLAND AVE. P.O. 0+00.0

HECTOR J. & ROSE DOMINA

CARROLL G. & ALICE A. ALDRICH

CHARLES J. & MARY J. CORNEAU

WALTER M. MAIN

HERBERT G. & NANCY E. CURRAN

JOSEPH L. & MADELINE M. DOLLOFF

STATE OF VT to
Herbert G. &
Nancy E. Curran
and s/w/o
BK? Pg?

DEMOLITION & REMOVAL OF BUILDING

3279 + 40 LT

3279 + 25 LT

PLAIN GUARD RAIL ITEMS 3-A

PELOW ST. 8+75

SARA PERRAULT

ARTHUR S. & MILDRED G. PALIN

MAURICE J. & LAURETTE P. FORTIN

JOHN O. & BEVERLY J. BULLIS

LOUIS & FLORENCE M. ROYAL

ROY O. & SHIRLEY N. DAVIS

ALFRED L. & MITA C. BAKIS

BURNS E. & BESSIE L. WILSON

AMERICAN CANNERY CO.

STATE OF VT to
Herbert G. &
Nancy E. Curran
and s/w/o
BK? Pg?

DEMOLITION & REMOVAL OF BUILDING

3279 + 40 LT

3279 + 25 LT

Granite slope along

Item 336-A

Const. Drive

Frontage Rd. 0+37.4

PARCEL 29

GRANTOR LOUIS & FLORENCE M. ROYAL

STATIONS 3282+42 - 3284+38.1

TAKING REMAINDER 0.45 A ±

RIGHTS NONE

TITLE TAKEN NONE

RECORDED DEEDS - BK 52 - PG 323-3 - 10/25/60

PARCEL 28

GRANTOR ROY O. & SHIRLEY N. DAVIS

STATIONS 3287+00 - 3287+00

TAKING 13.5 A ±

RIGHTS NONE

TITLE TAKEN NONE

RECORDED DEEDS - BK 42 - PG 199-133 - 10/11/60

PARCEL 28 A

STATIONS 3279+85 - 3297+98

TAKING 13.5 A ±

RIGHTS NONE

TITLE TAKEN NONE

RECORDED DEEDS - BK 42 - PG 199-133 - 10/11/60

PARCEL 28 B, C, D

GRANTOR ROY O. & SHIRLEY N. DAVIS

STATIONS 3279+85 - 3297+98

TAKING 13.5 A ±

RIGHTS NONE

TITLE TAKEN NONE

RECORDED DEEDS - BK 42 - PG 199-133 - 10/11/60

PARCEL 28 A

STATIONS 3279+85 - 3297+98

TAKING 13.5 A ±

RIGHTS NONE

TITLE TAKEN NONE

RECORDED DEEDS - BK 42 - PG 199-133 - 10/11/60

TRAFFIC DIAGRAM

220 1915 D.M. EST.

PARCEL 21

GRANTOR MERLE V. GROW

STATIONS 3279+70 - 3292+48 ±

TAKING 13.5 A ±

RIGHTS NONE

TITLE TAKEN NONE

RECORDED DEEDS - BK 32 - PG 326-7 - 11/2/60

PARCEL 25

GRANTOR CHARLES J. & MARY J. CORNEAU

STATIONS 3279+70 - 3279+70

TAKING 13.5 A ±

RIGHTS NONE

TITLE TAKEN NONE

RECORDED DEEDS - BK 32 - PG 326-7 - 11/2/60

PARCEL 25

GRANTOR CHARLES J. & MARY J. CORNEAU

STATIONS 3279+70 - 3279+70

PARCEL 27

GRANTOR GRACE L. AUDLETTE

STATIONS 3283+70 - 3282+73

TAKING 0.7 A ±

RIGHTS NONE

TITLE TAKEN NONE

RECORDED DEEDS - BK 35 - PG 315-6 - 11/1/60

PARCEL 26B

GRANTOR INTERNATIONAL WATER COMPANY

STATIONS 3285+47.20 ±

TAKING 3.00 ±

RIGHTS NONE

TITLE TAKEN NONE

RECORDED DEEDS - BK 35 - PG 315-6 - 11/1/60


PARCEL 26B

GRANTOR INTERNATIONAL WATER COMPANY

STATIONS 3285+47.20 ±

POOR ORIGINAL COPY

43
JUL 11 1974 24

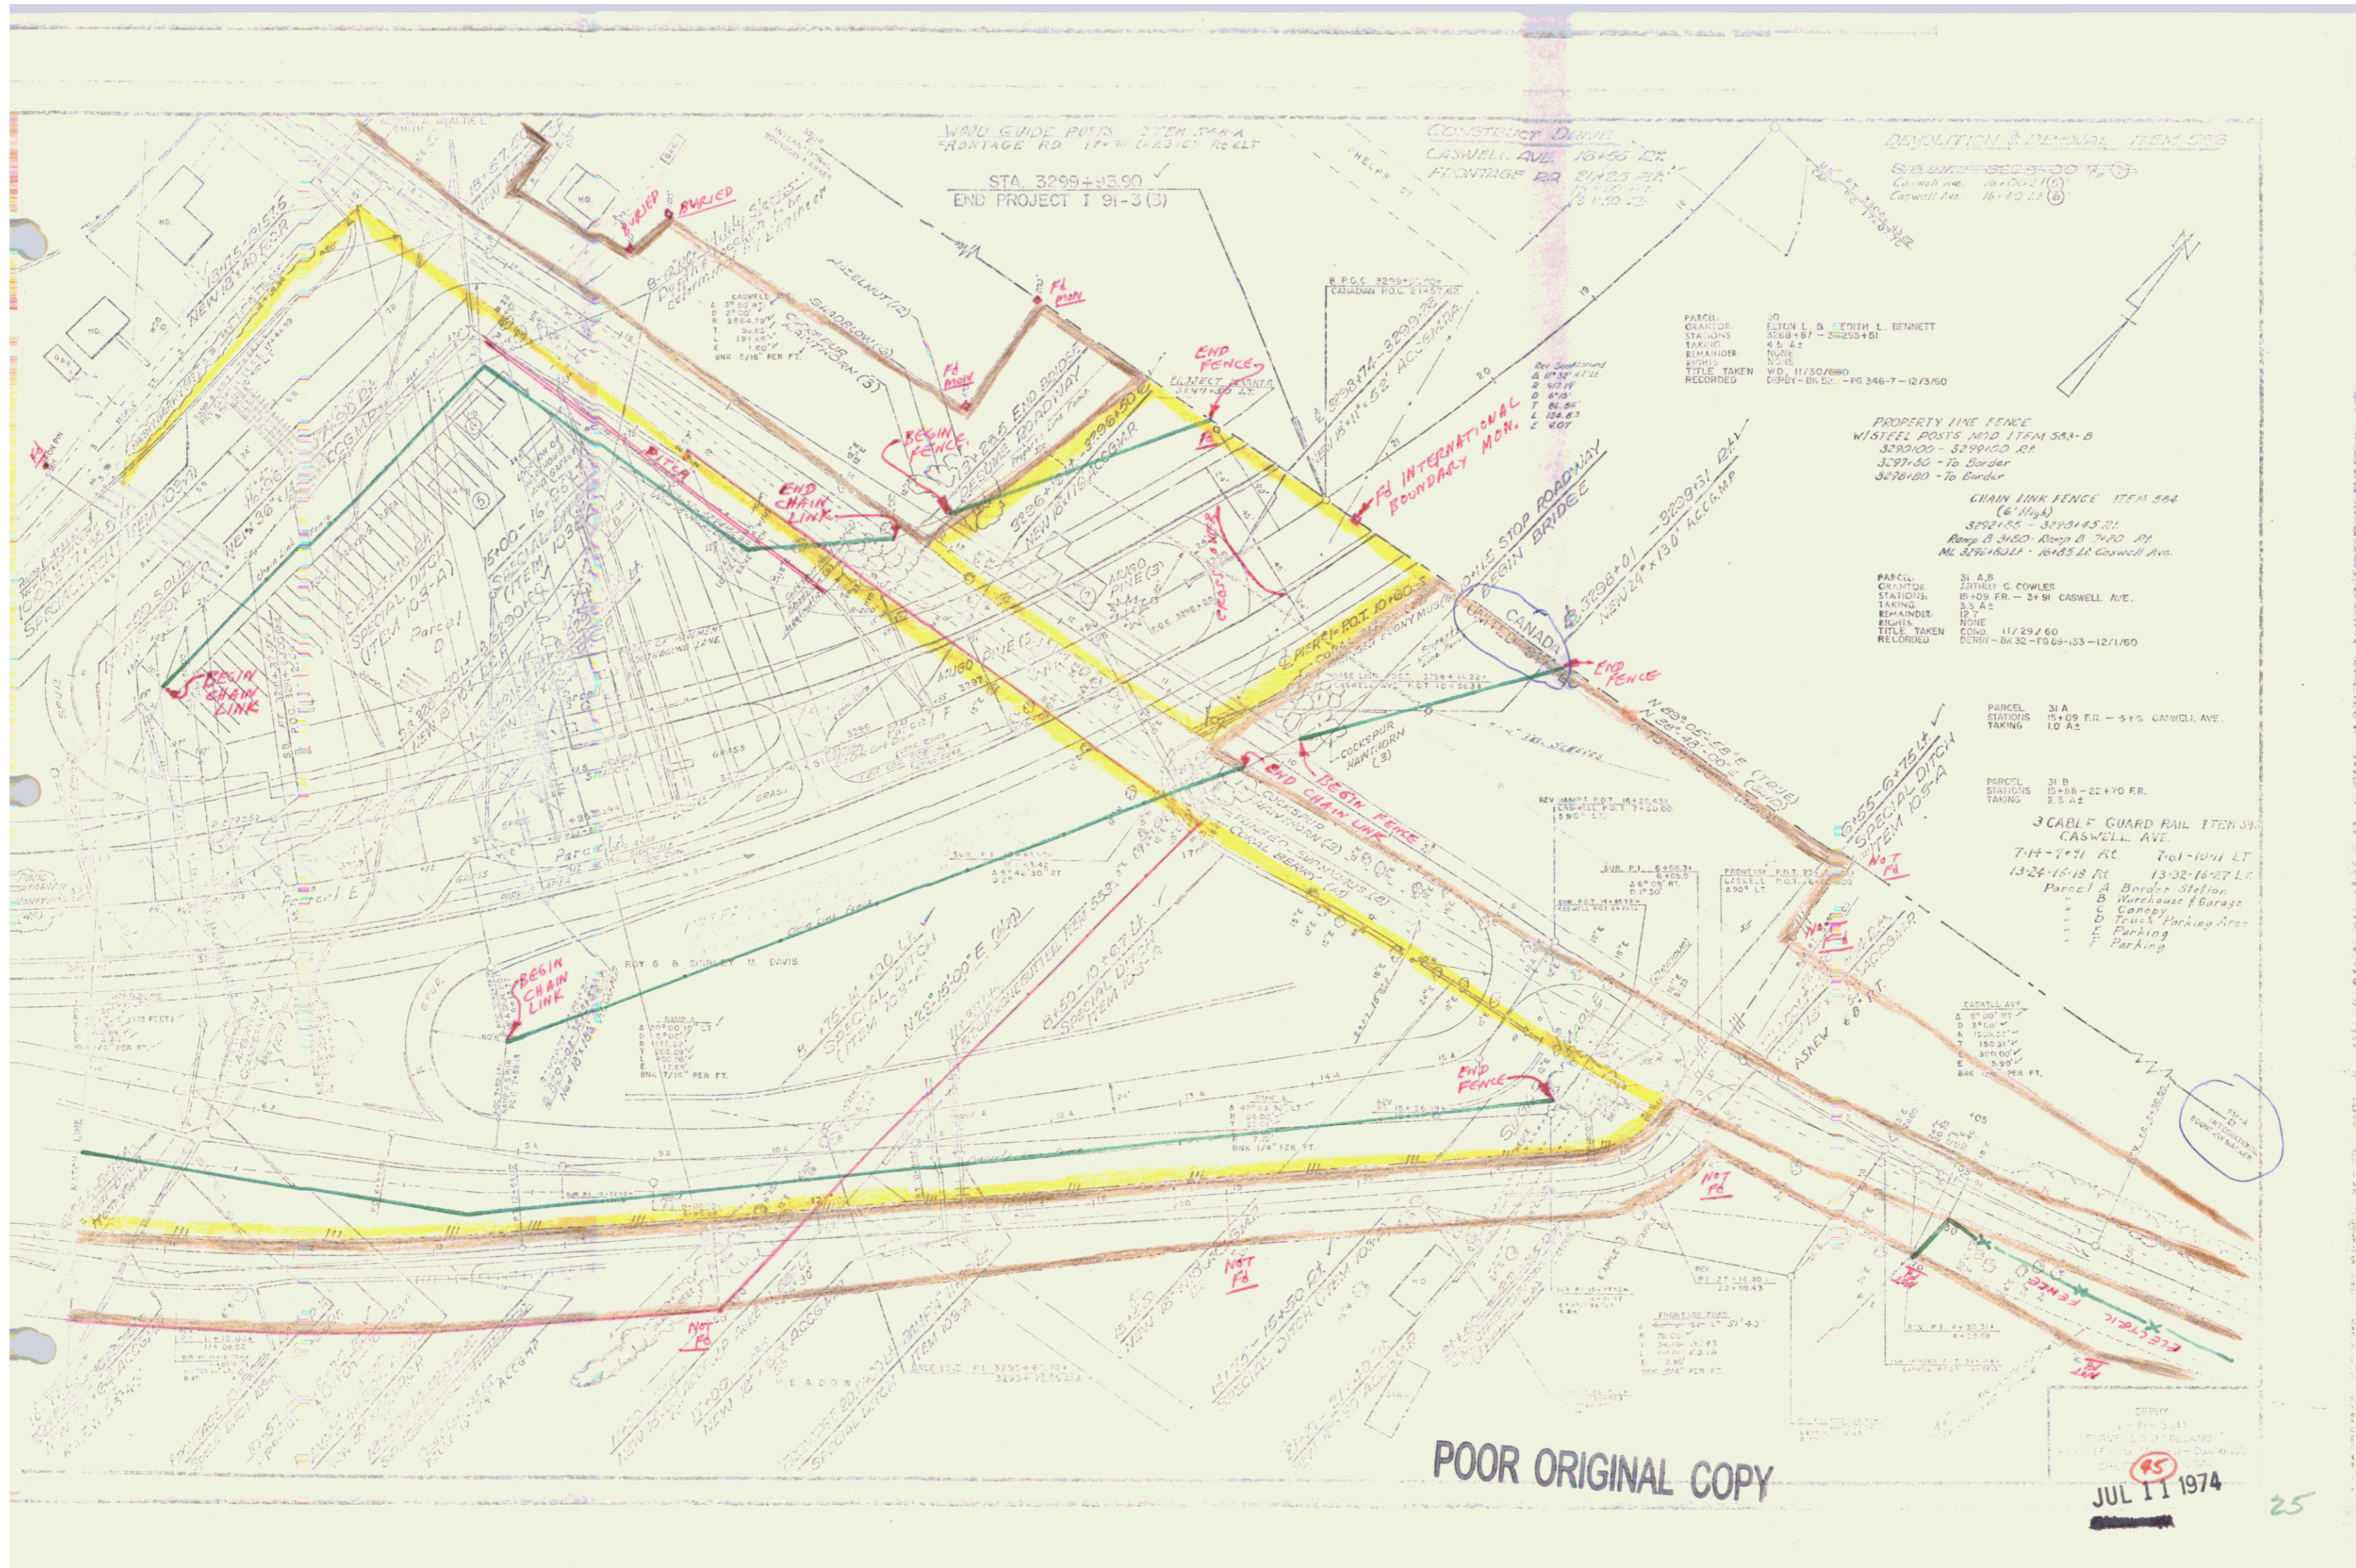

POOR ORIGINAL COPY

JUL 11 1974

25

3 CABLE GUARD RAIL
 ITEM 543
 7+80=0+1.2 L&A 7+61-10+11 L.T.
 8+83=9+9.2A 7+17-9+91 R.T.

PARCEL 26C
 GRANTOR R.C. 9.
 STATIONS 0+00-0+01
 TAKING 0.5A.1
 SHIRLEY M. DAVIS

PARCEL 49 A.B
 GRANTOR HENRIETTA BALL BANTING
 STATIONS 0+00-16+39.2
 TAKING 1.3A.2
 REMAINDER NONE
 RIGHTS NONE
 TITLE TAKEN W.D.O.F. 12/23/60
 RECORDED DEEDY - BK 52 - PG 360-1 - 1/3/61


PARCEL 37
 GRANTOR MARY RITA B WILLIAM P. JONIS
 STATIONS 9+70-13+14.2
 TAKING 1.3A.2
 REMAINDER NONE
 RIGHTS NONE
 TITLE TAKEN COND. 1/23/60
 RECORDED DEEDY - BK 32 - PG 89-133 - 12/1/60

REV. CURVE DATA
 L 9200' R.A.
 D 3'00"
 R 1909.86'
 T 150.31'
 L 300.00'
 E 5.90'
 20% 2% A/F


STA. 2+00
 BEGIN CONSTRUCTION

1160
 1150
 1140
 1130

1140
 1130
 1120

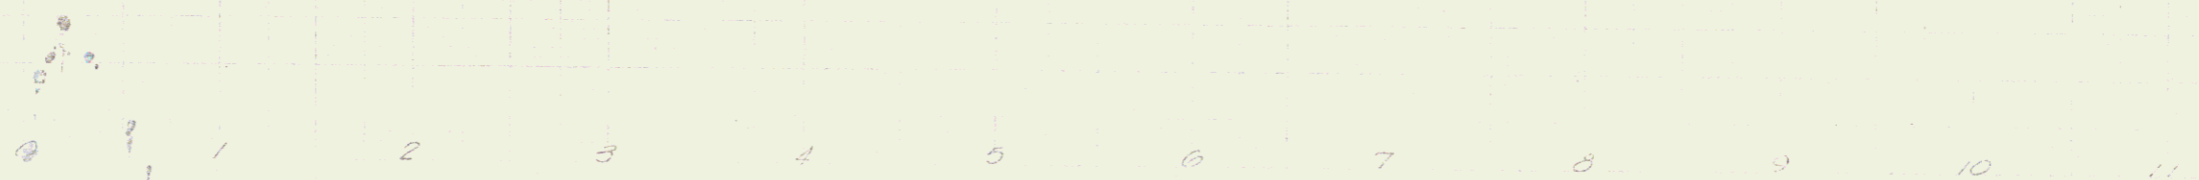

DEEDY
 21-21-3121
 50
 JUL 11 1974 28

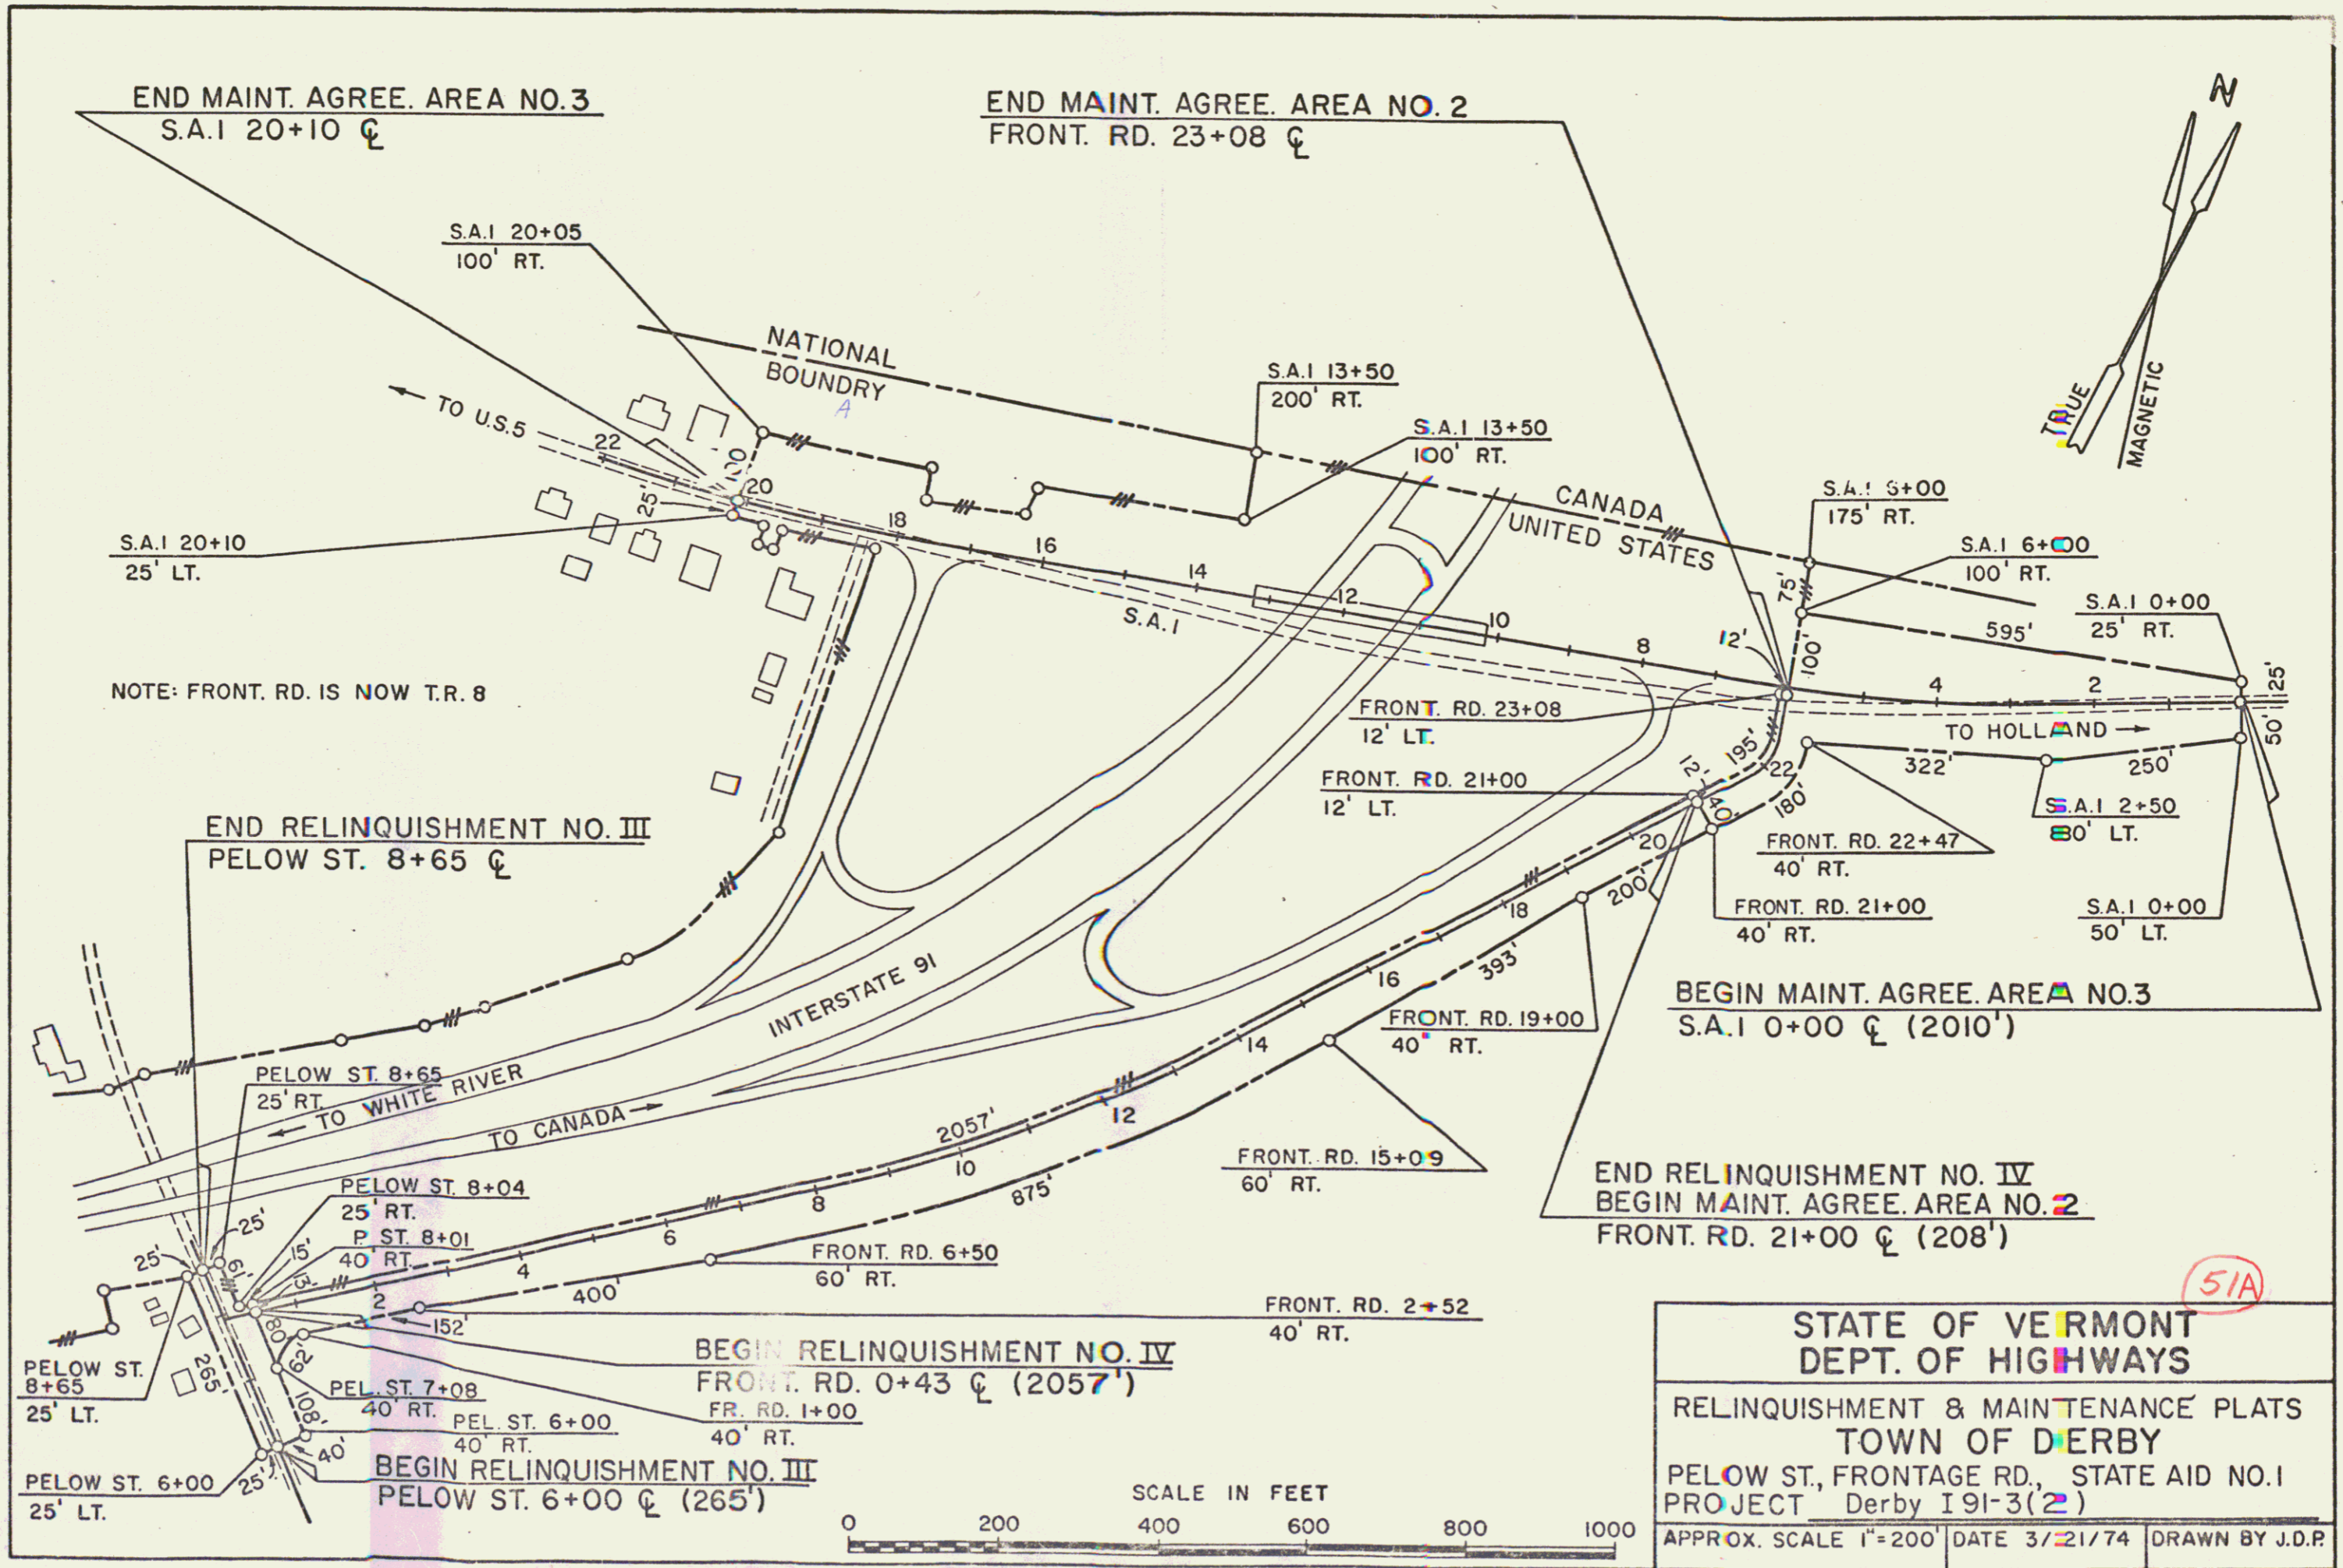

END MAINT. AGREE. AREA NO. 3
S.A. 1 20+10 C


END MAINT. AGREE. AREA NO. 2
FRONT. RD. 23+08 C

S.A. 1 20+05
100' RT.

NATIONAL
BOUNDARY

S.A. 1 13+50
200' RT.

S.A. 1 13+50
100' RT.

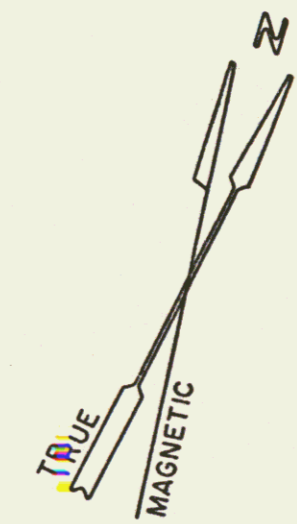

S.A. 1 20+10
25' LT.

NOTE: FRONT. RD. IS NOW T.R. 8

END RELINQUISHMENT NO. III
PELOW ST. 8+65 C

CANADA
UNITED STATES

S.A. 1 6+00
175' RT.

S.A. 1 6+00
100' RT.

S.A. 1 0+00
25' RT.

FRONT. RD. 23+08
12' LT.

FRONT. RD. 21+00
12' LT.

BEGIN MAINT. AGREE. AREA NO. 3
S.A. 1 0+00 C (2010')

PELOW ST. 8+65
25' RT.

INTERSTATE 91

FRONT. RD. 15+09
60' RT.

END RELINQUISHMENT NO. IV
BEGIN MAINT. AGREE. AREA NO. 2
FRONT. RD. 21+00 C (208')

PELOW ST. 8+04
25' RT.

PELOW ST. 8+01
40' RT.

BEGIN RELINQUISHMENT NO. IV
FRONT. RD. 0+43 C (2057')

FRONT. RD. 2+52
40' RT.

PELOW ST. 7+08
40' RT.

PELOW ST. 6+00
40' RT.


BEGIN RELINQUISHMENT NO. III
PELOW ST. 6+00 C (265')


PELOW ST. 6+00
25' LT.




STATE OF VERMONT
DEPT. OF HIGHWAYS
RELINQUISHMENT & MAINTENANCE PLATS
TOWN OF DERBY
PELOW ST, FRONTAGE RD., STATE AID NO. 1
PROJECT Derby I 91-3(2)
APPROX. SCALE 1"=200' DATE 3/21/74 DRAWN BY J.D.P.


51A

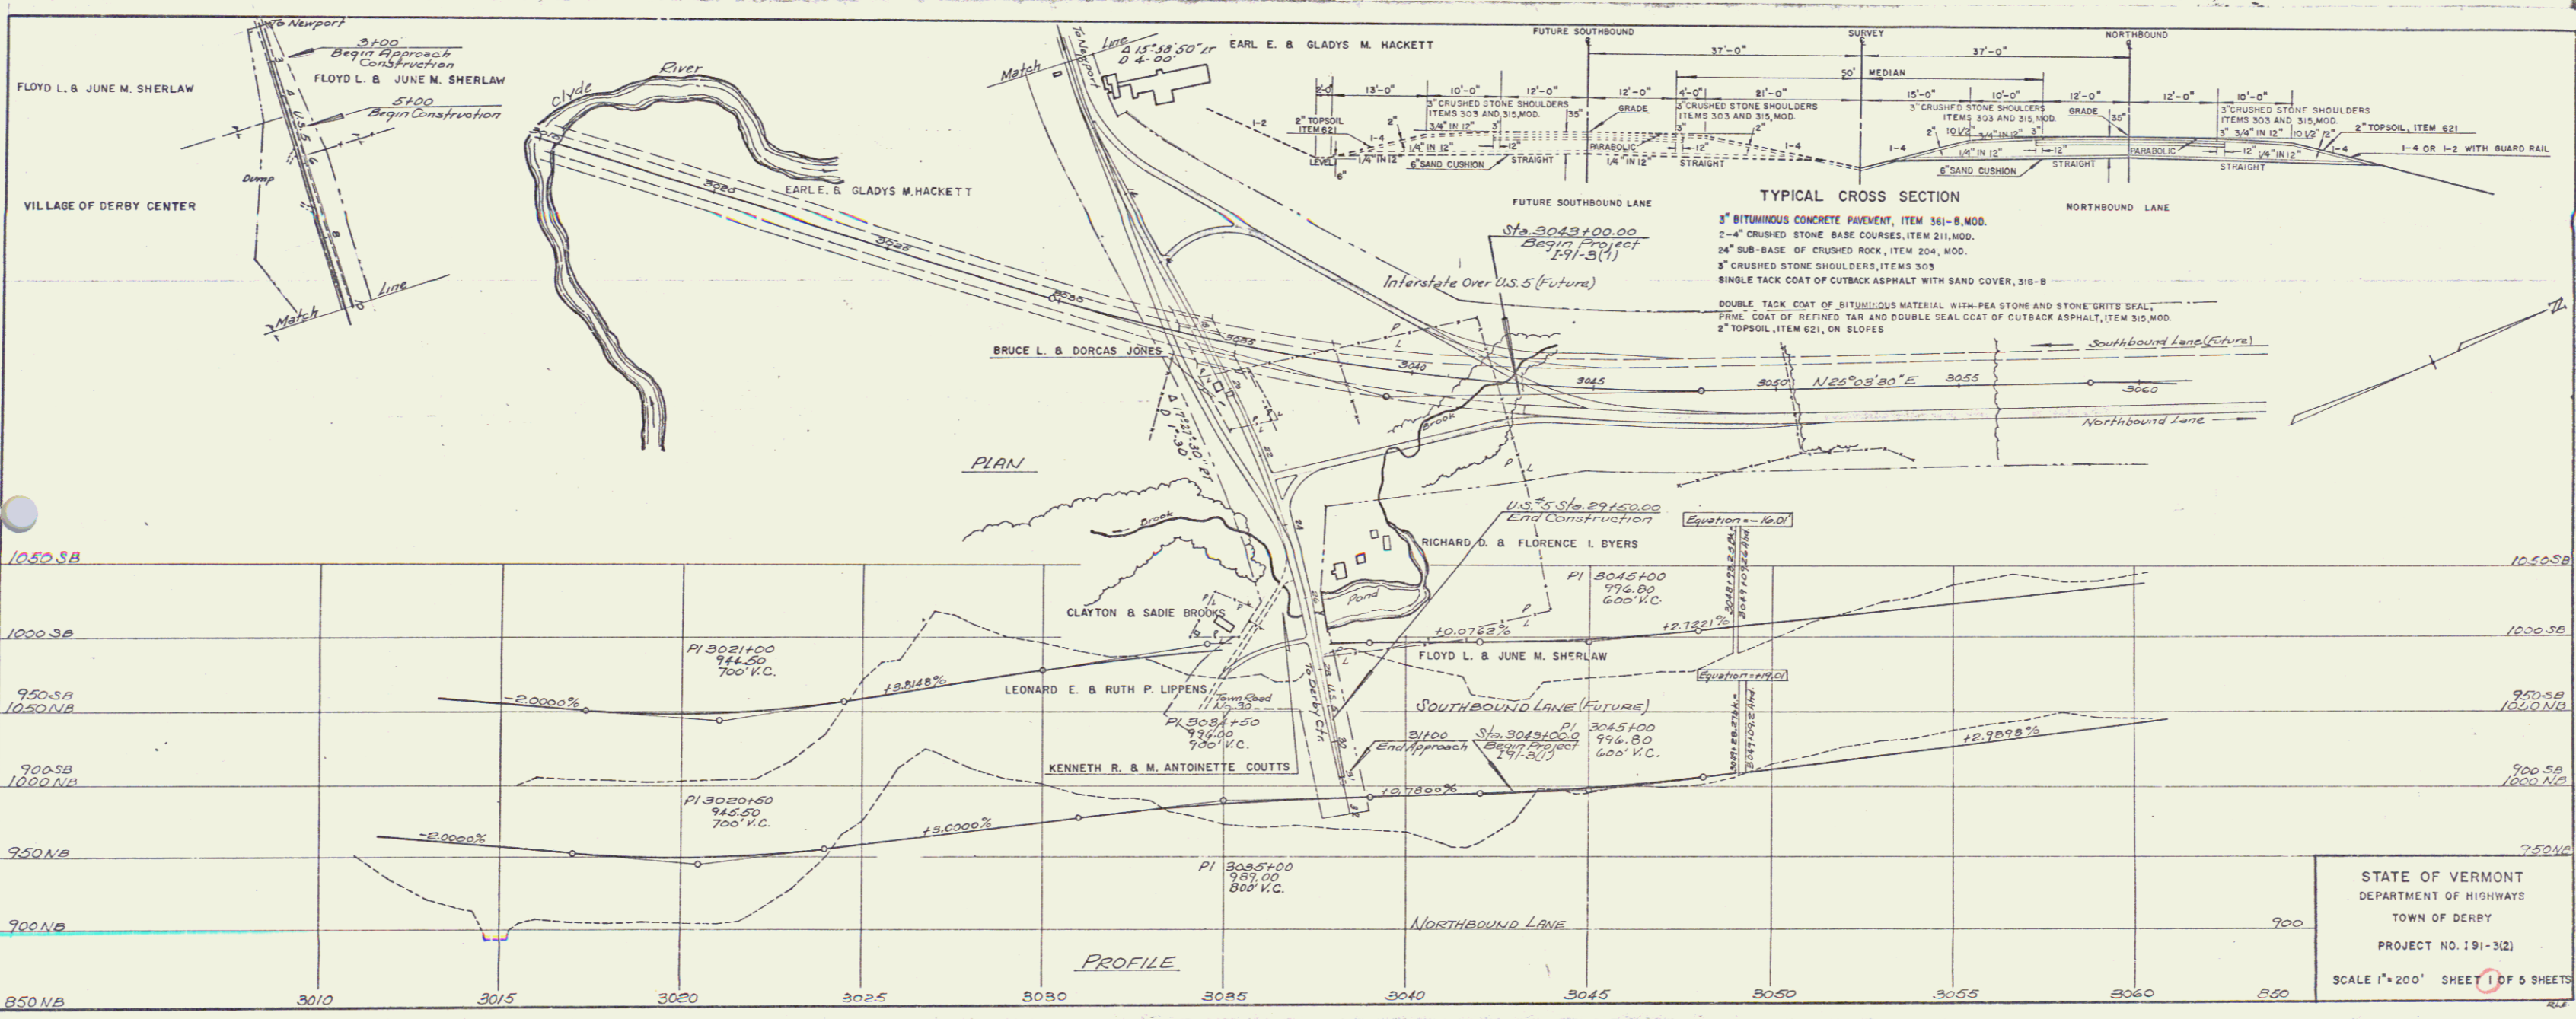

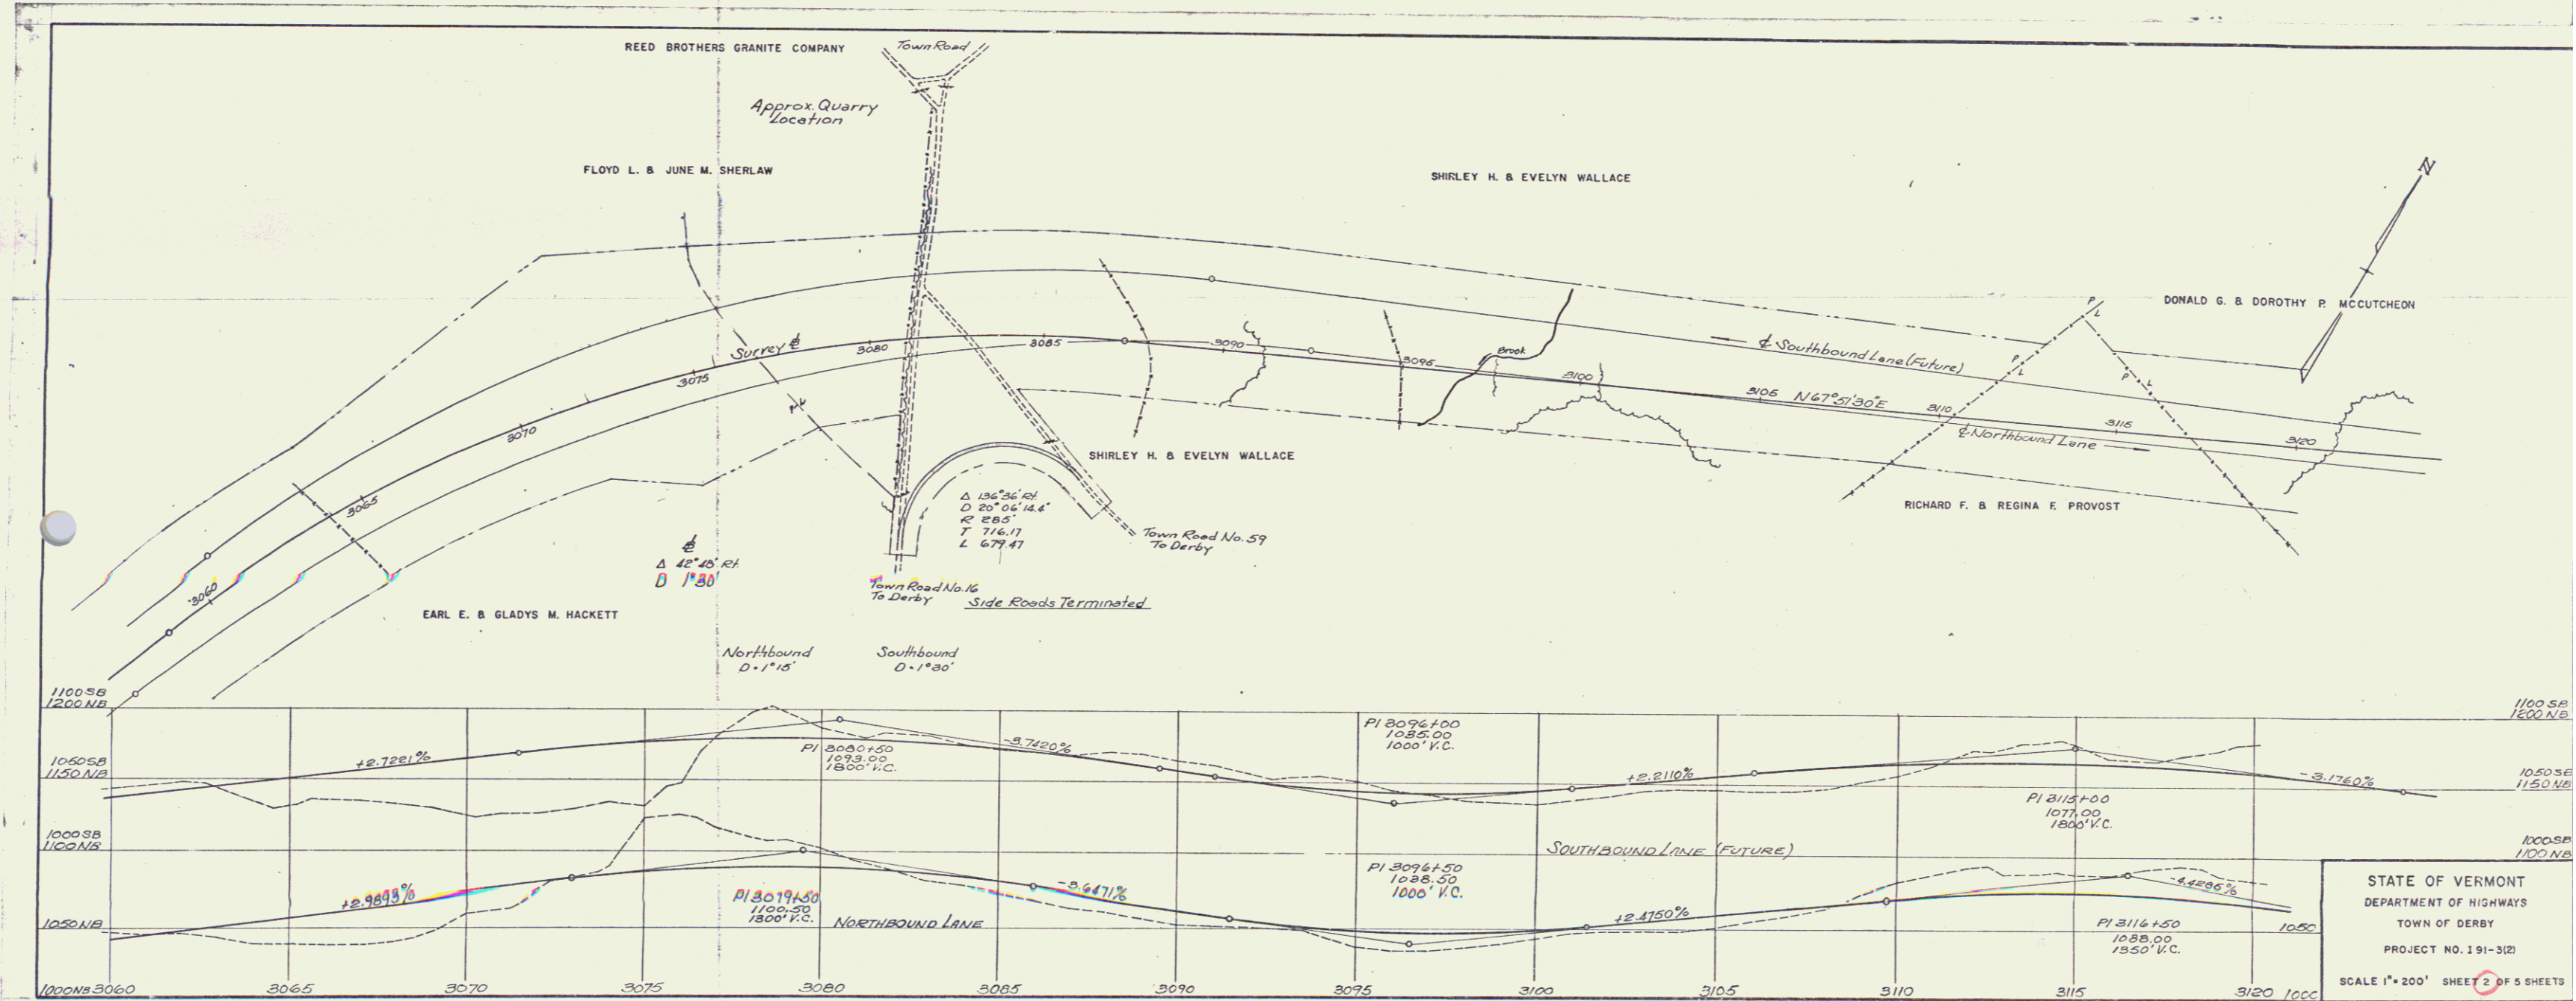

STATE OF VERMONT
 DEPARTMENT OF HIGHWAYS
 TOWN OF DERBY
 PROJECT NO. 191-3(2)
 SCALE 1"=200' SHEET 2 OF 5 SHEETS

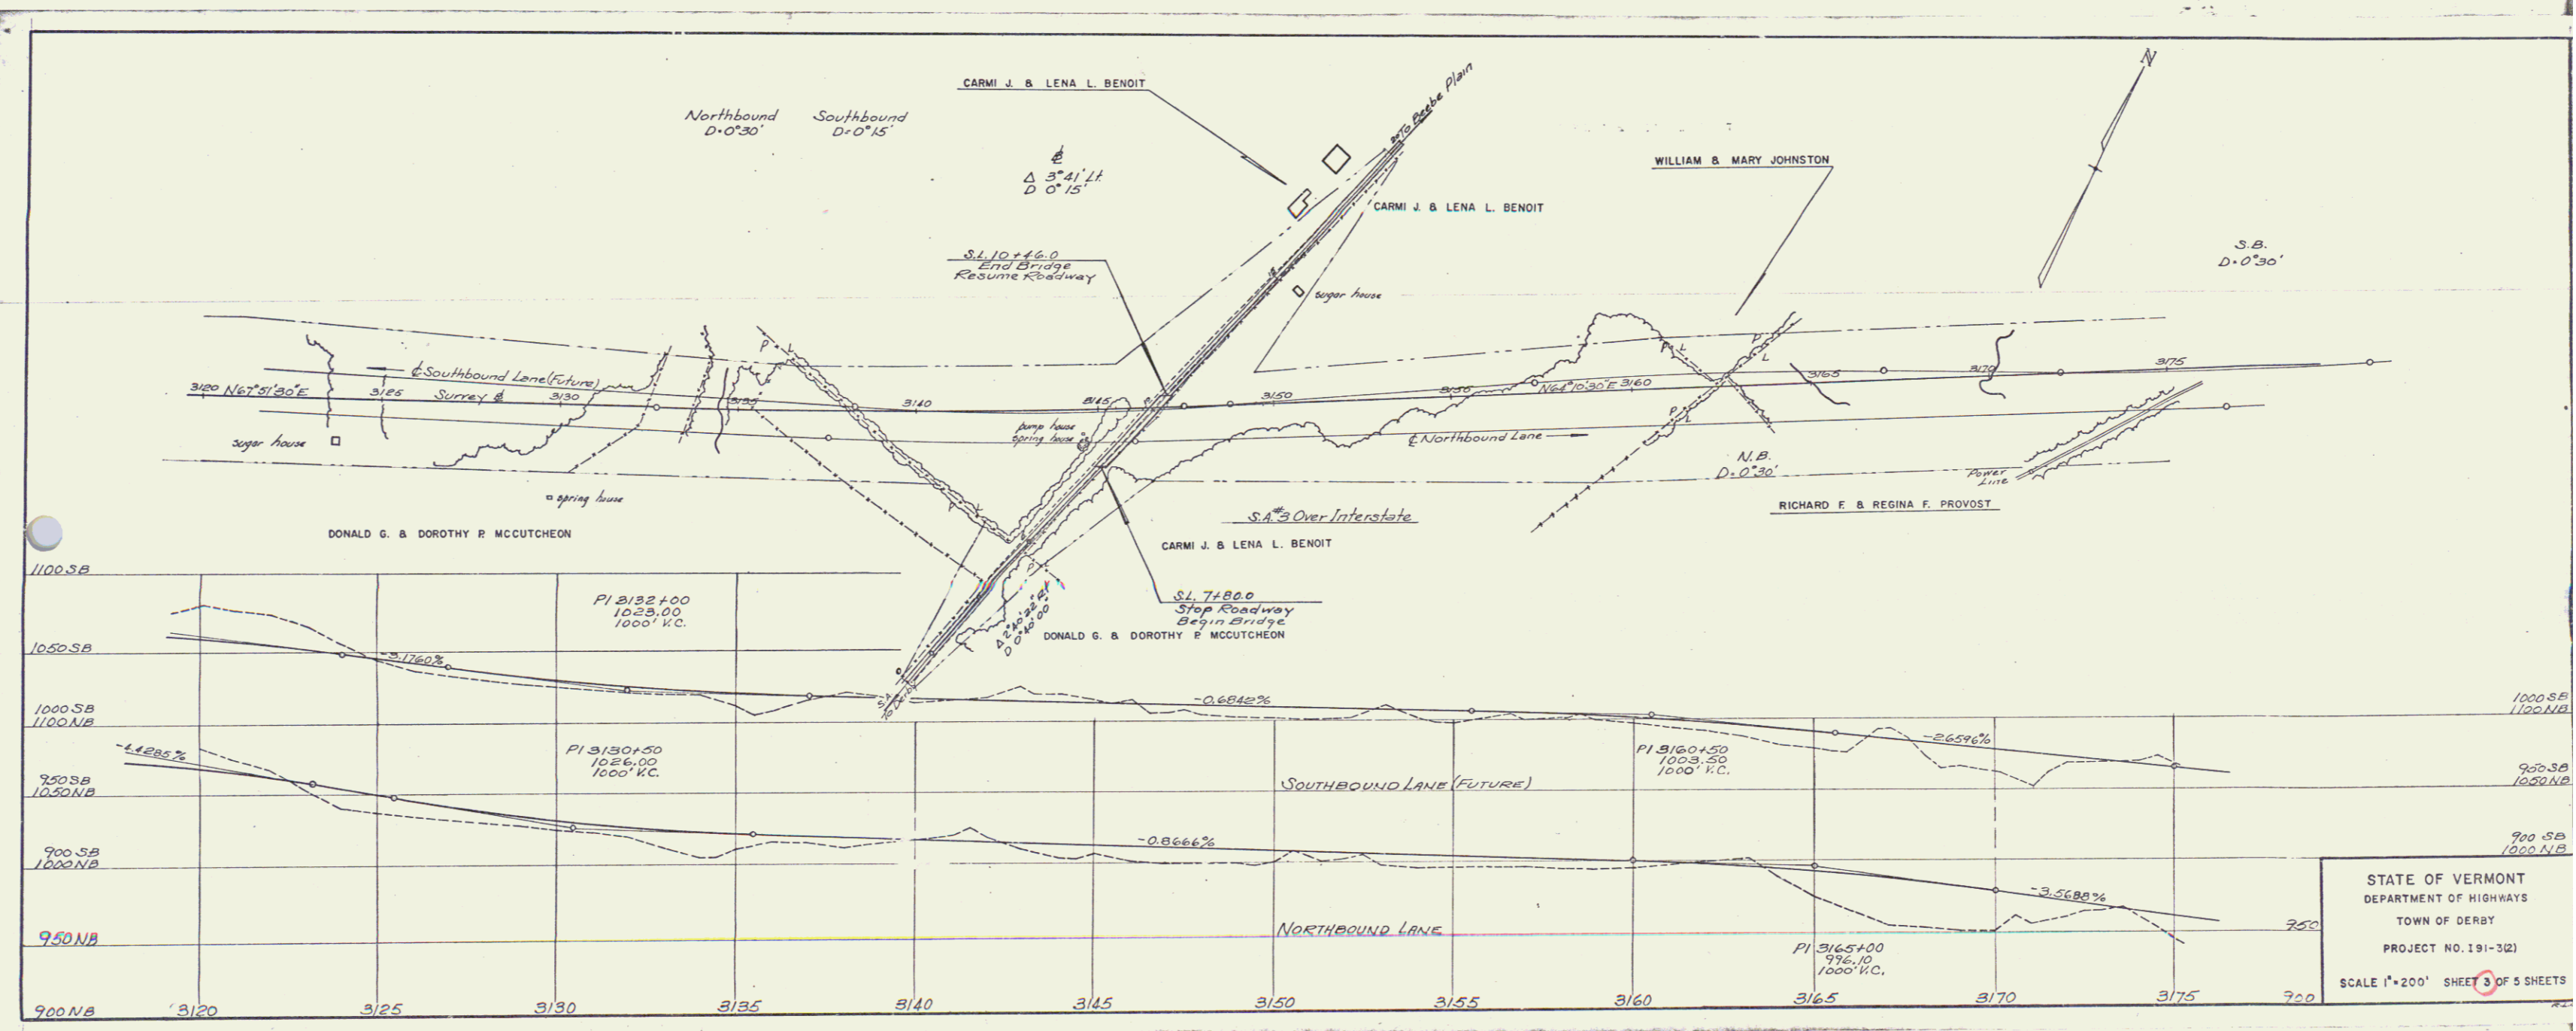

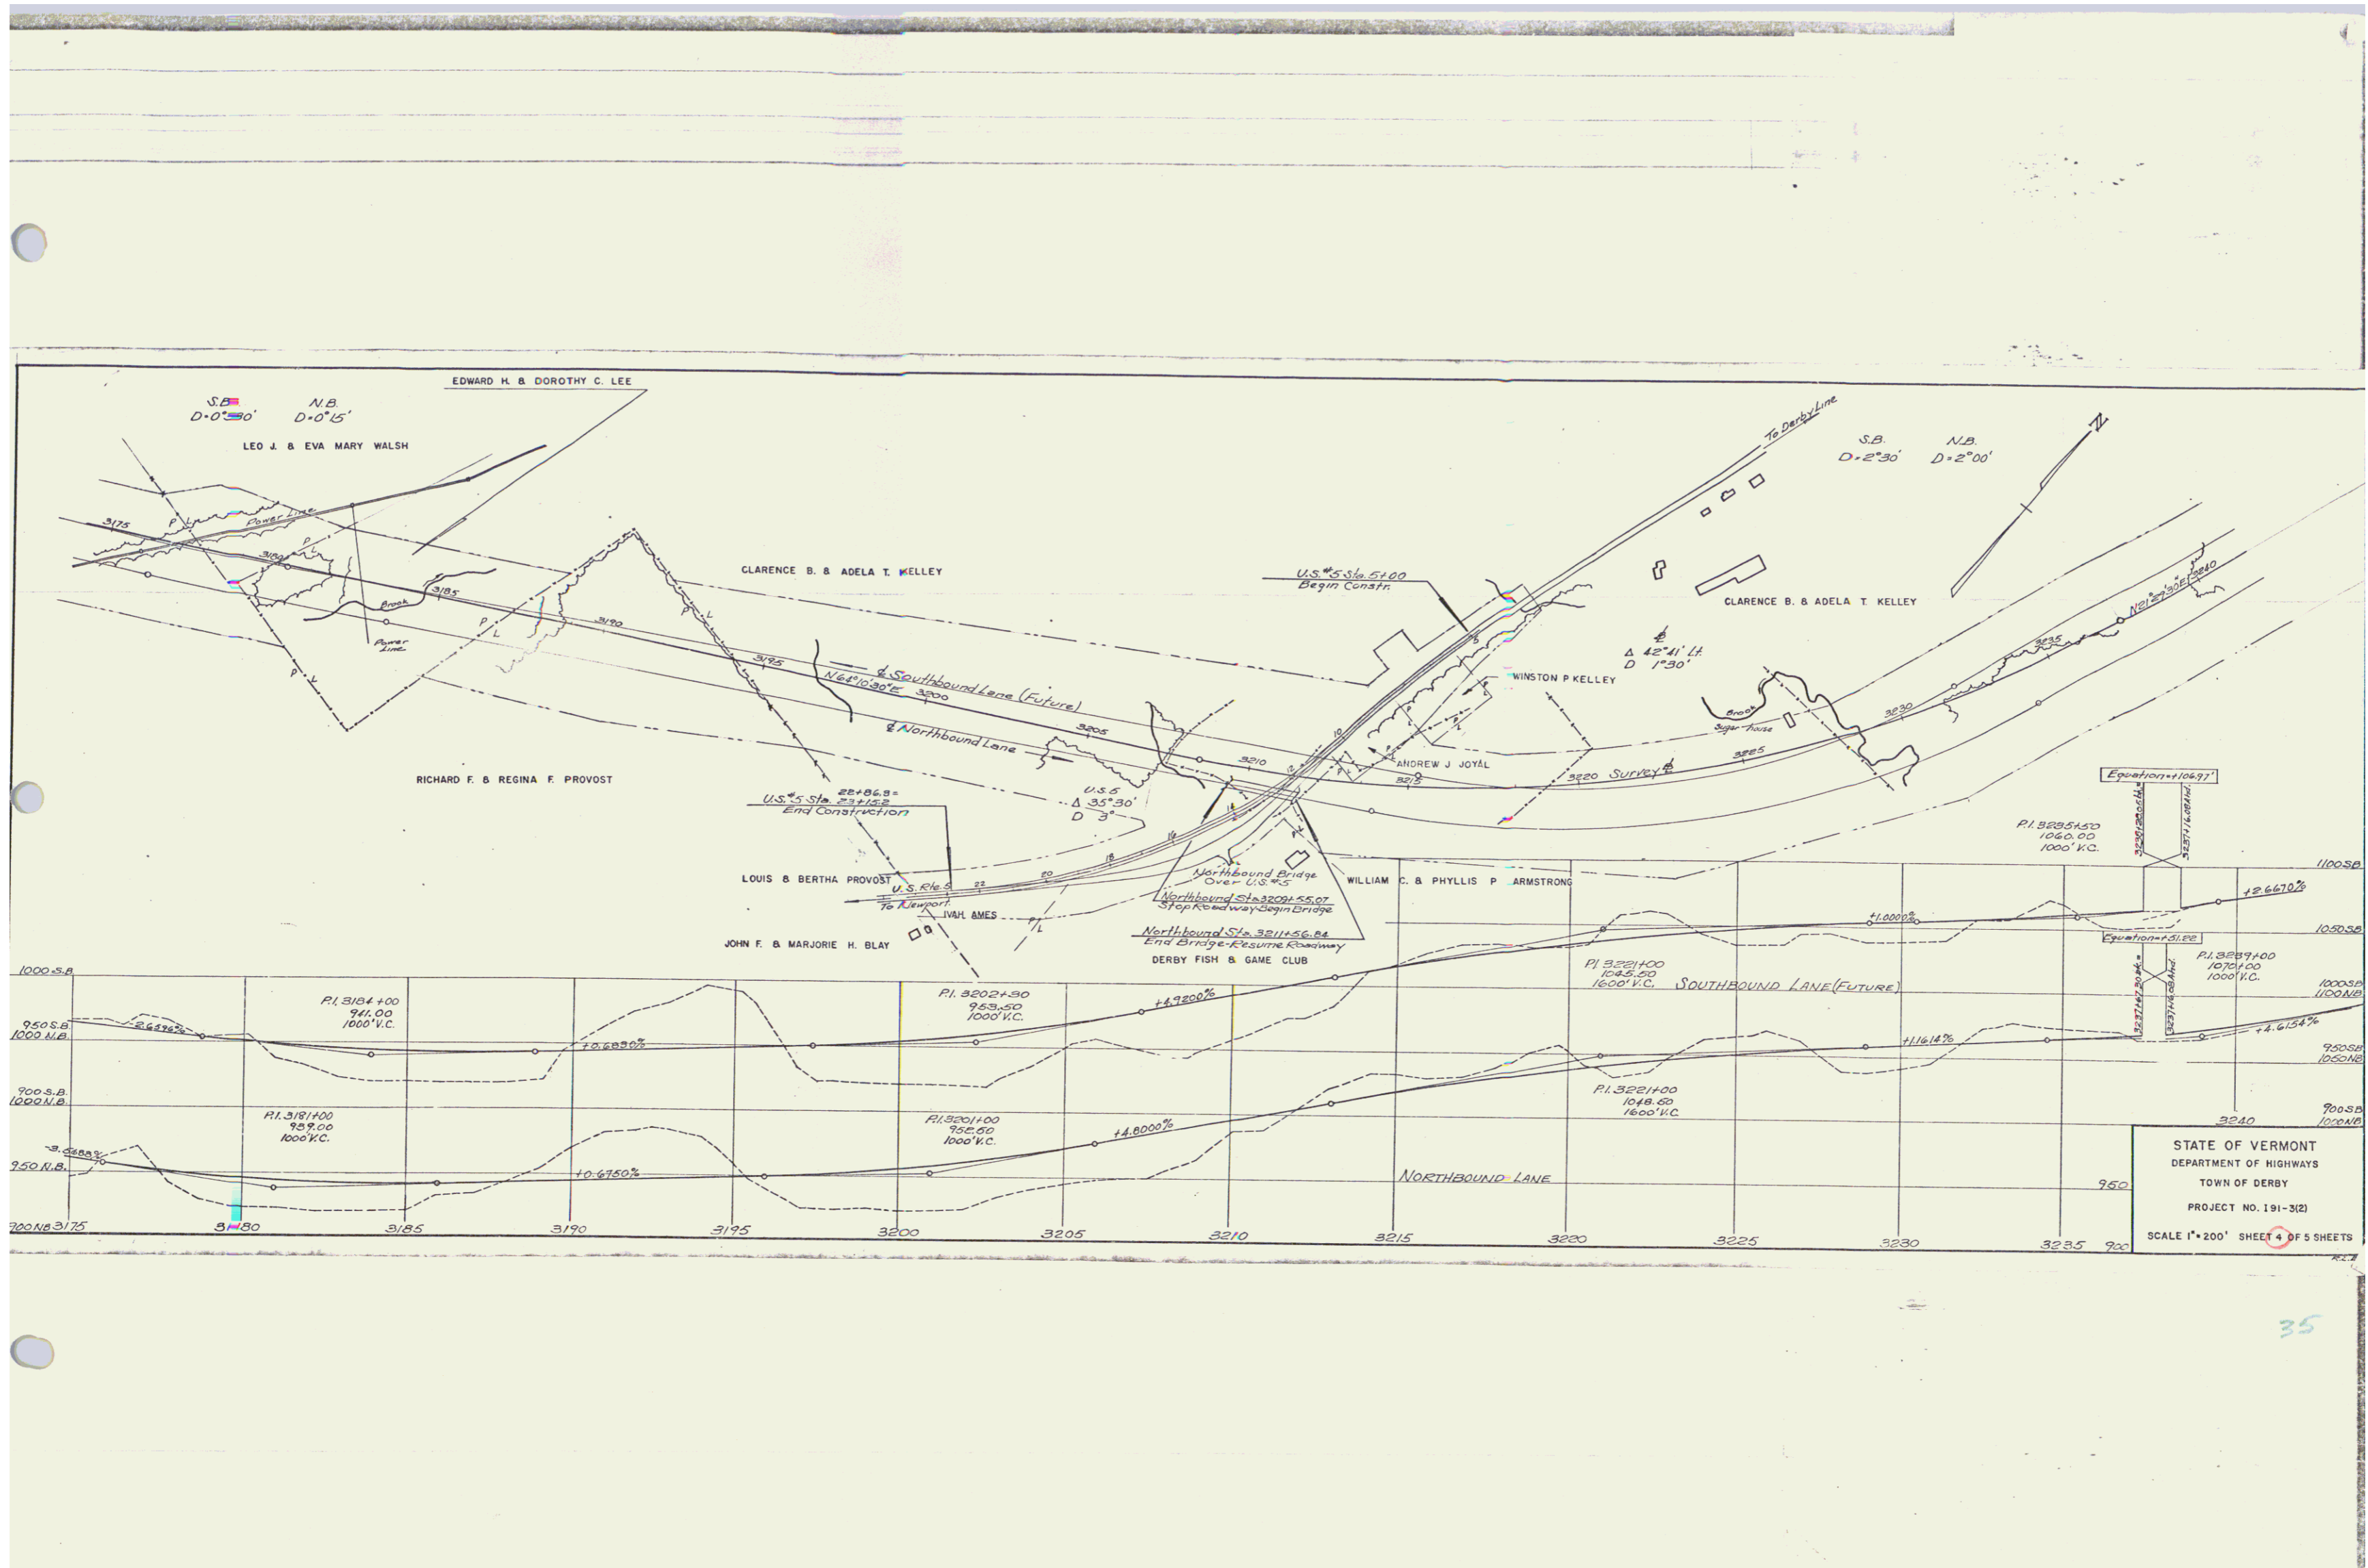

35

