


SCHEDULED WORK
 MILLING AND PATCHING OF
 SURFACE OF ROAD
 FENCE LINE FENCE REMOVAL
 STAGE 2 CONSTRUCTION

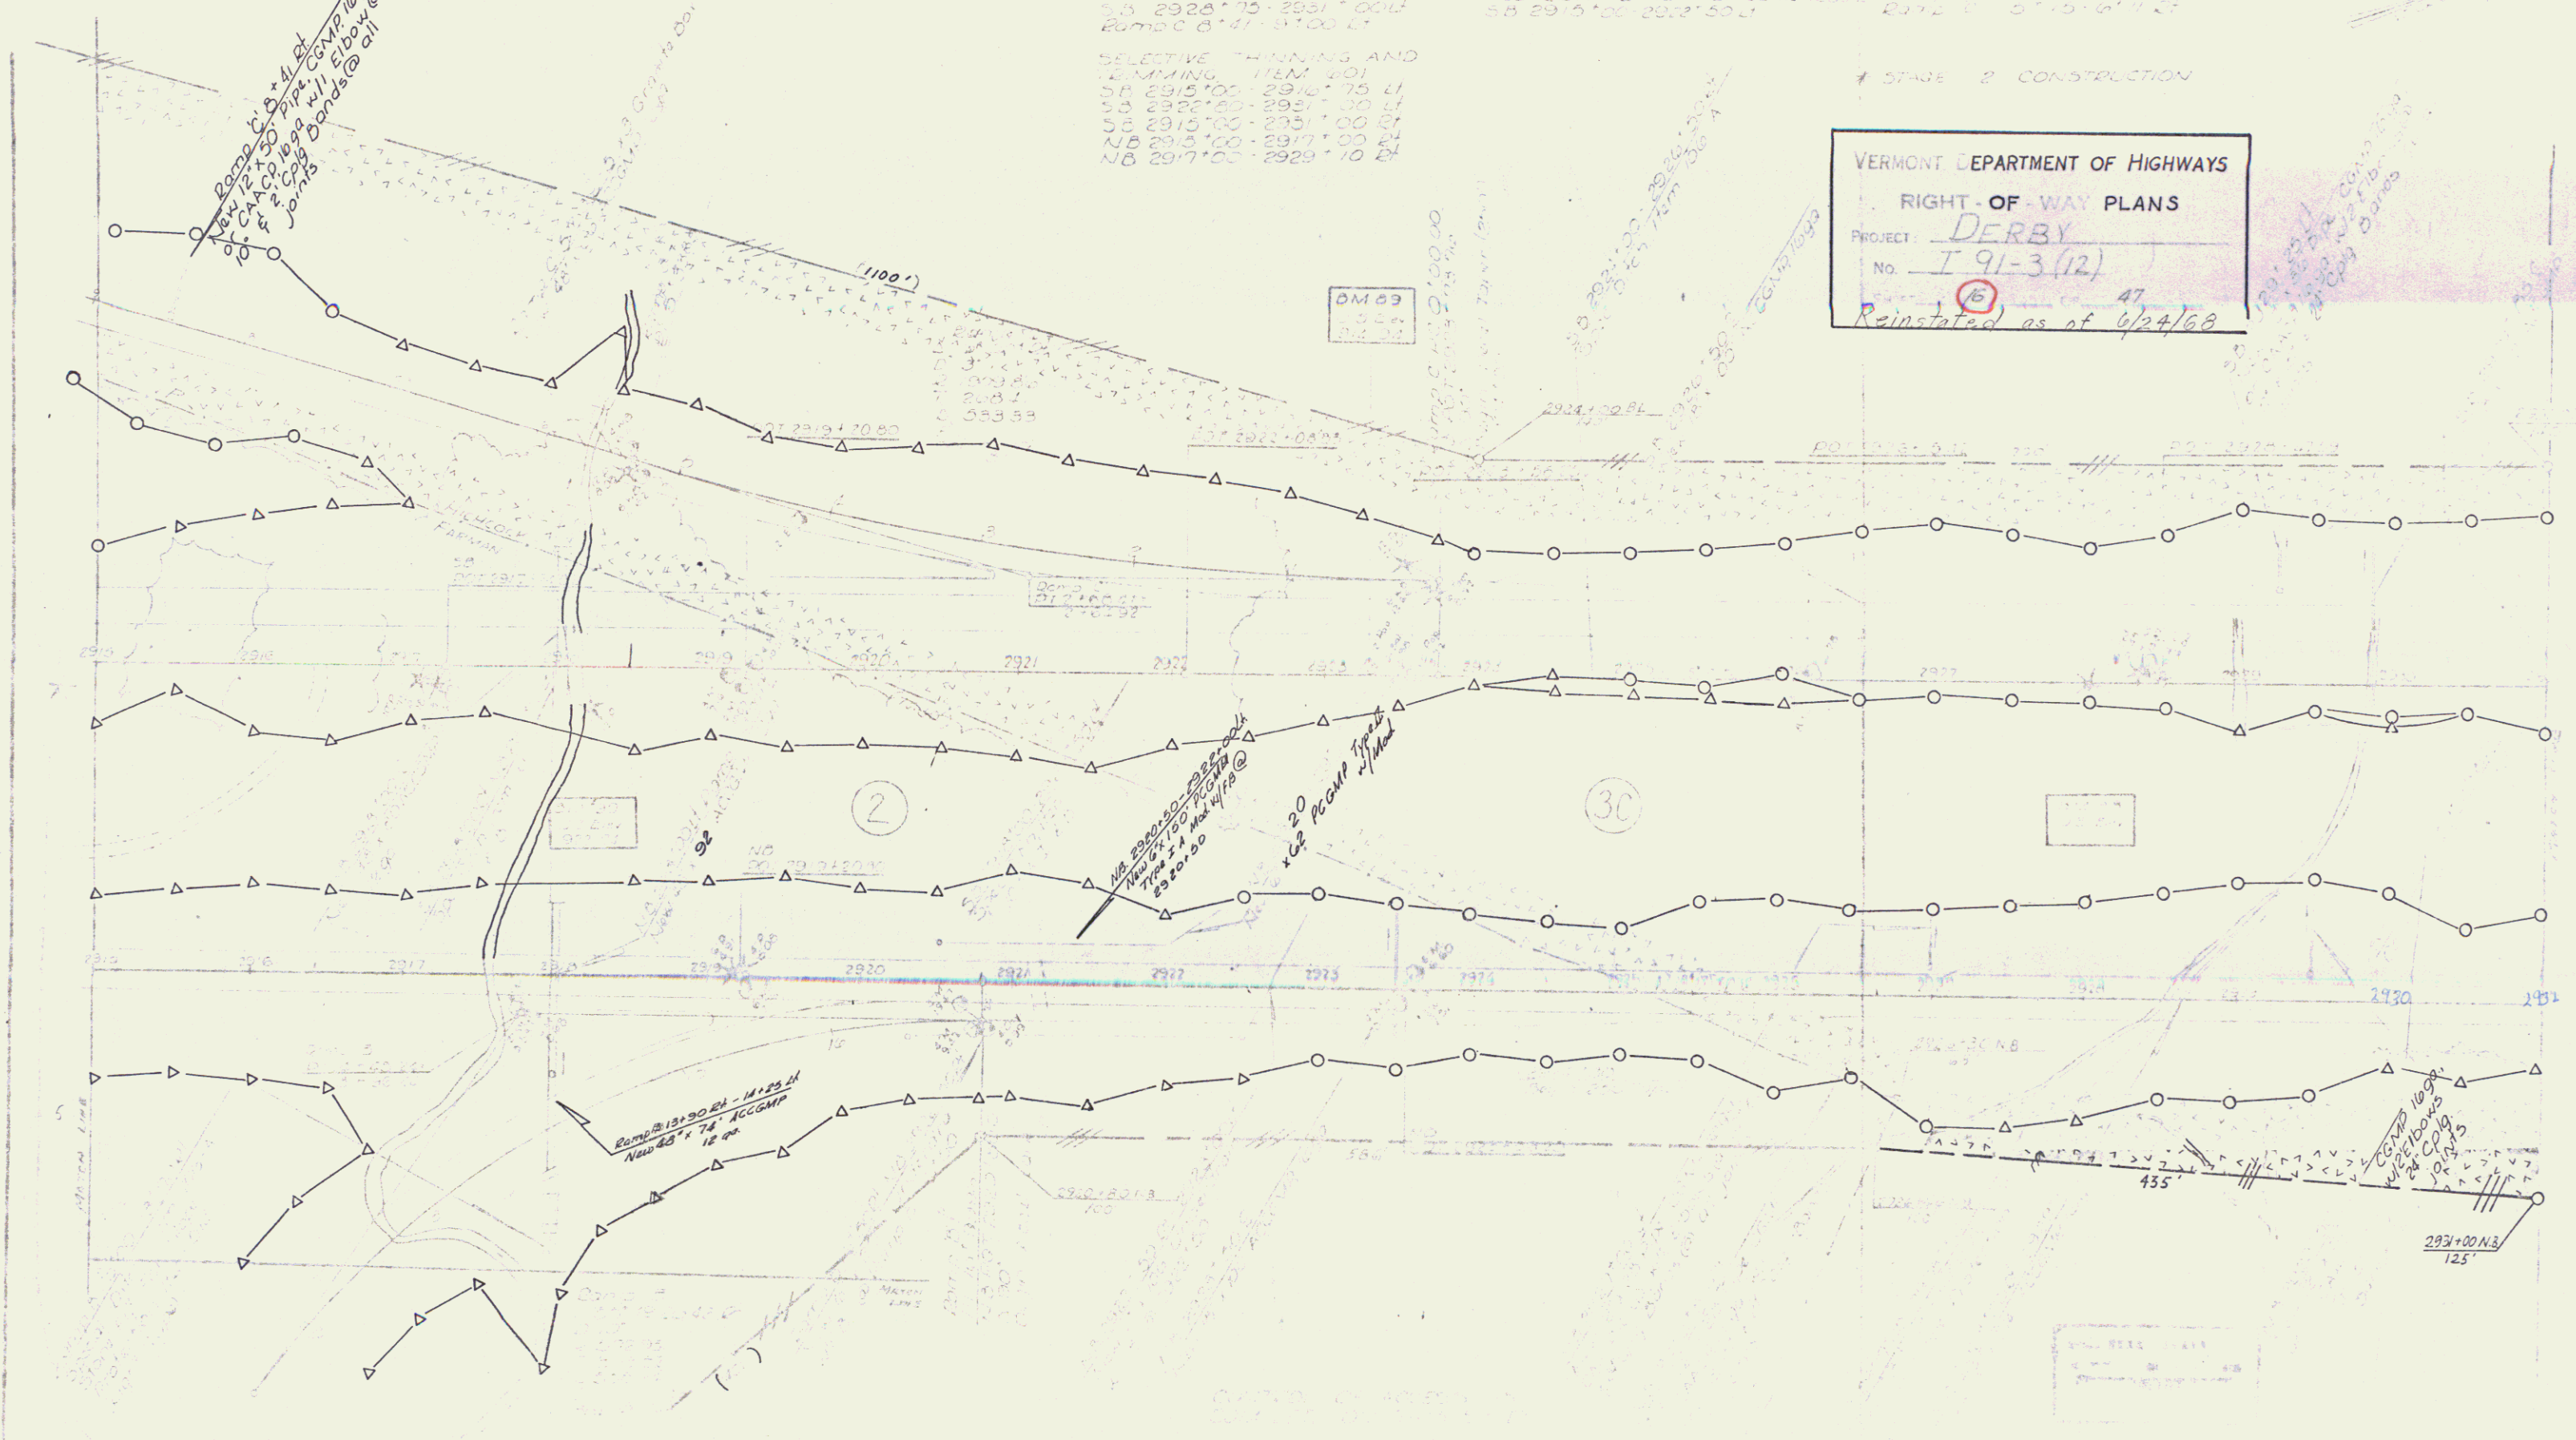

POOR ORIGINAL COPY

Row & CONST

R.O.W 5