

DRILLING & BLASTING OF SOLID
ROCK SUBGRADE ITEM 10
12+44 TO 15+175

THREE CARBIDE LEAD WIRE
WIRE MESH SYSTEM 540
12+44 TO 15+175
32+50 TO 35+100


VERMONT DEPARTMENT OF HIGHWAYS

RIGHT-OF-WAY


PROJECT: DARBY

No. T 91-3(12)

SHEET 12 OF 47

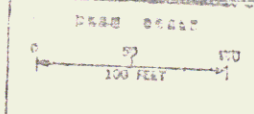


Δ 1.35
D.O. 725.58
1.00 75.10
55.32
3.00
Dist. Do not build

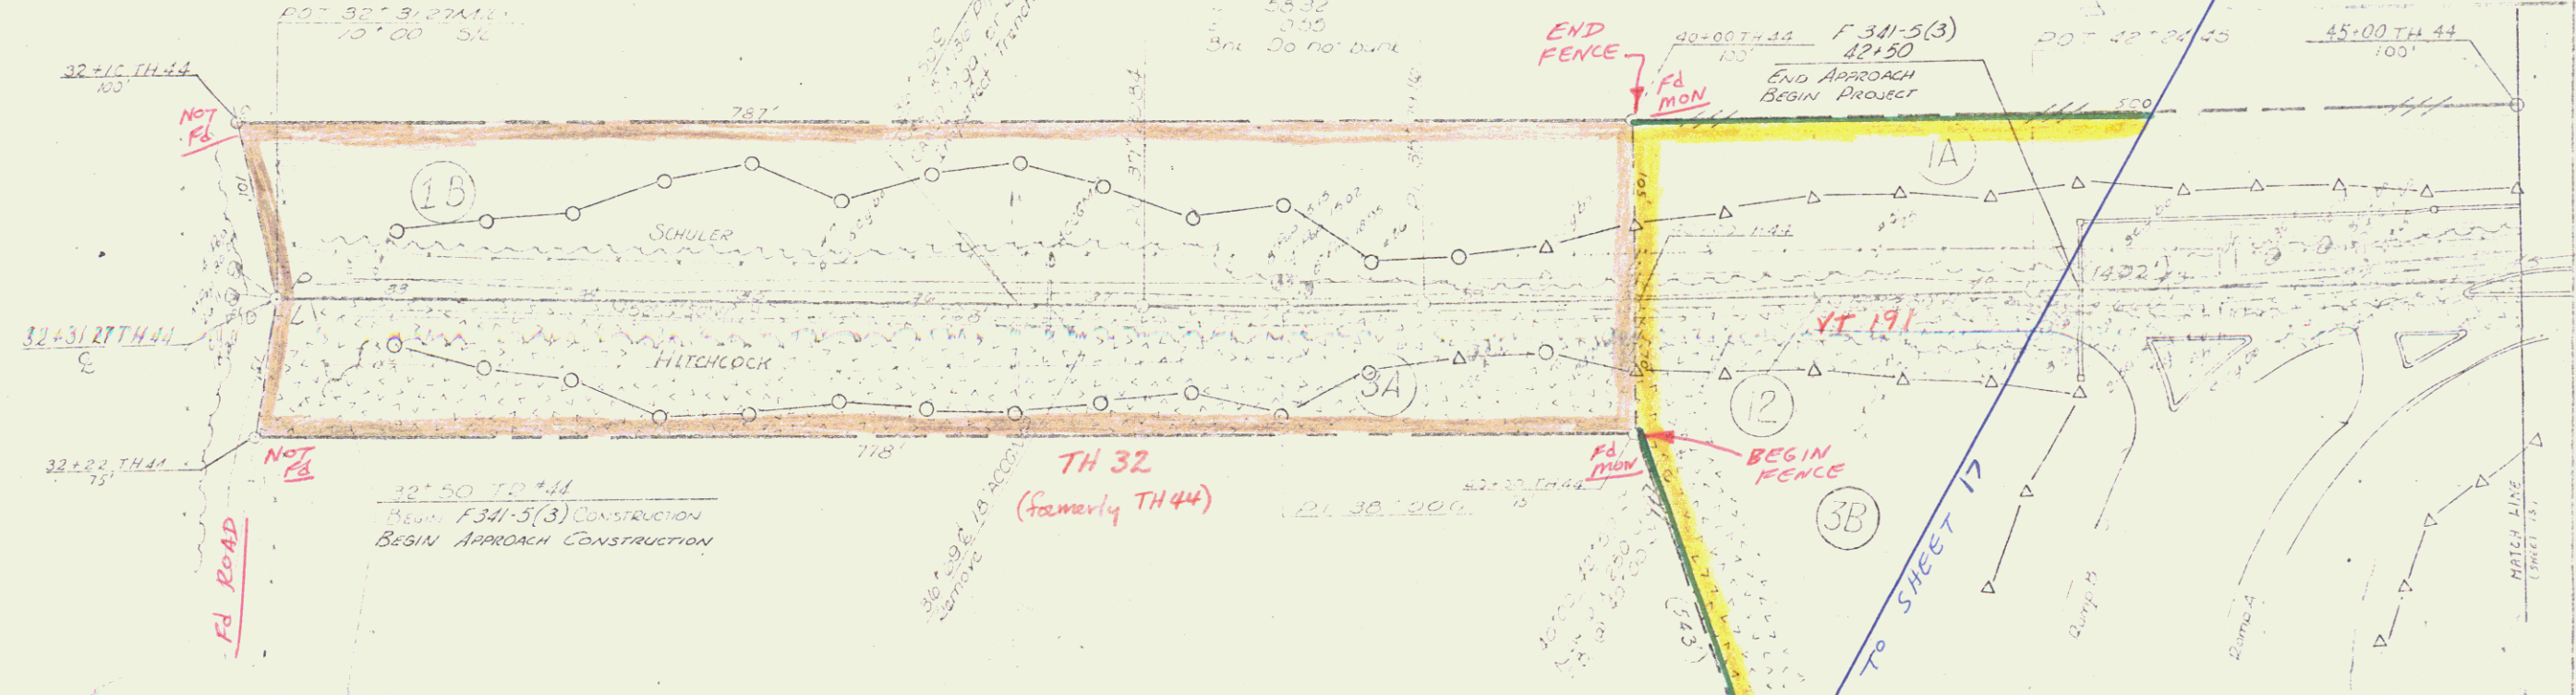

32+50 TO 44
Begin F 341-5(3) Construction
Begin Approach Construction

TH 32
(formerly TH 44)

MATCH TO SHEET 17

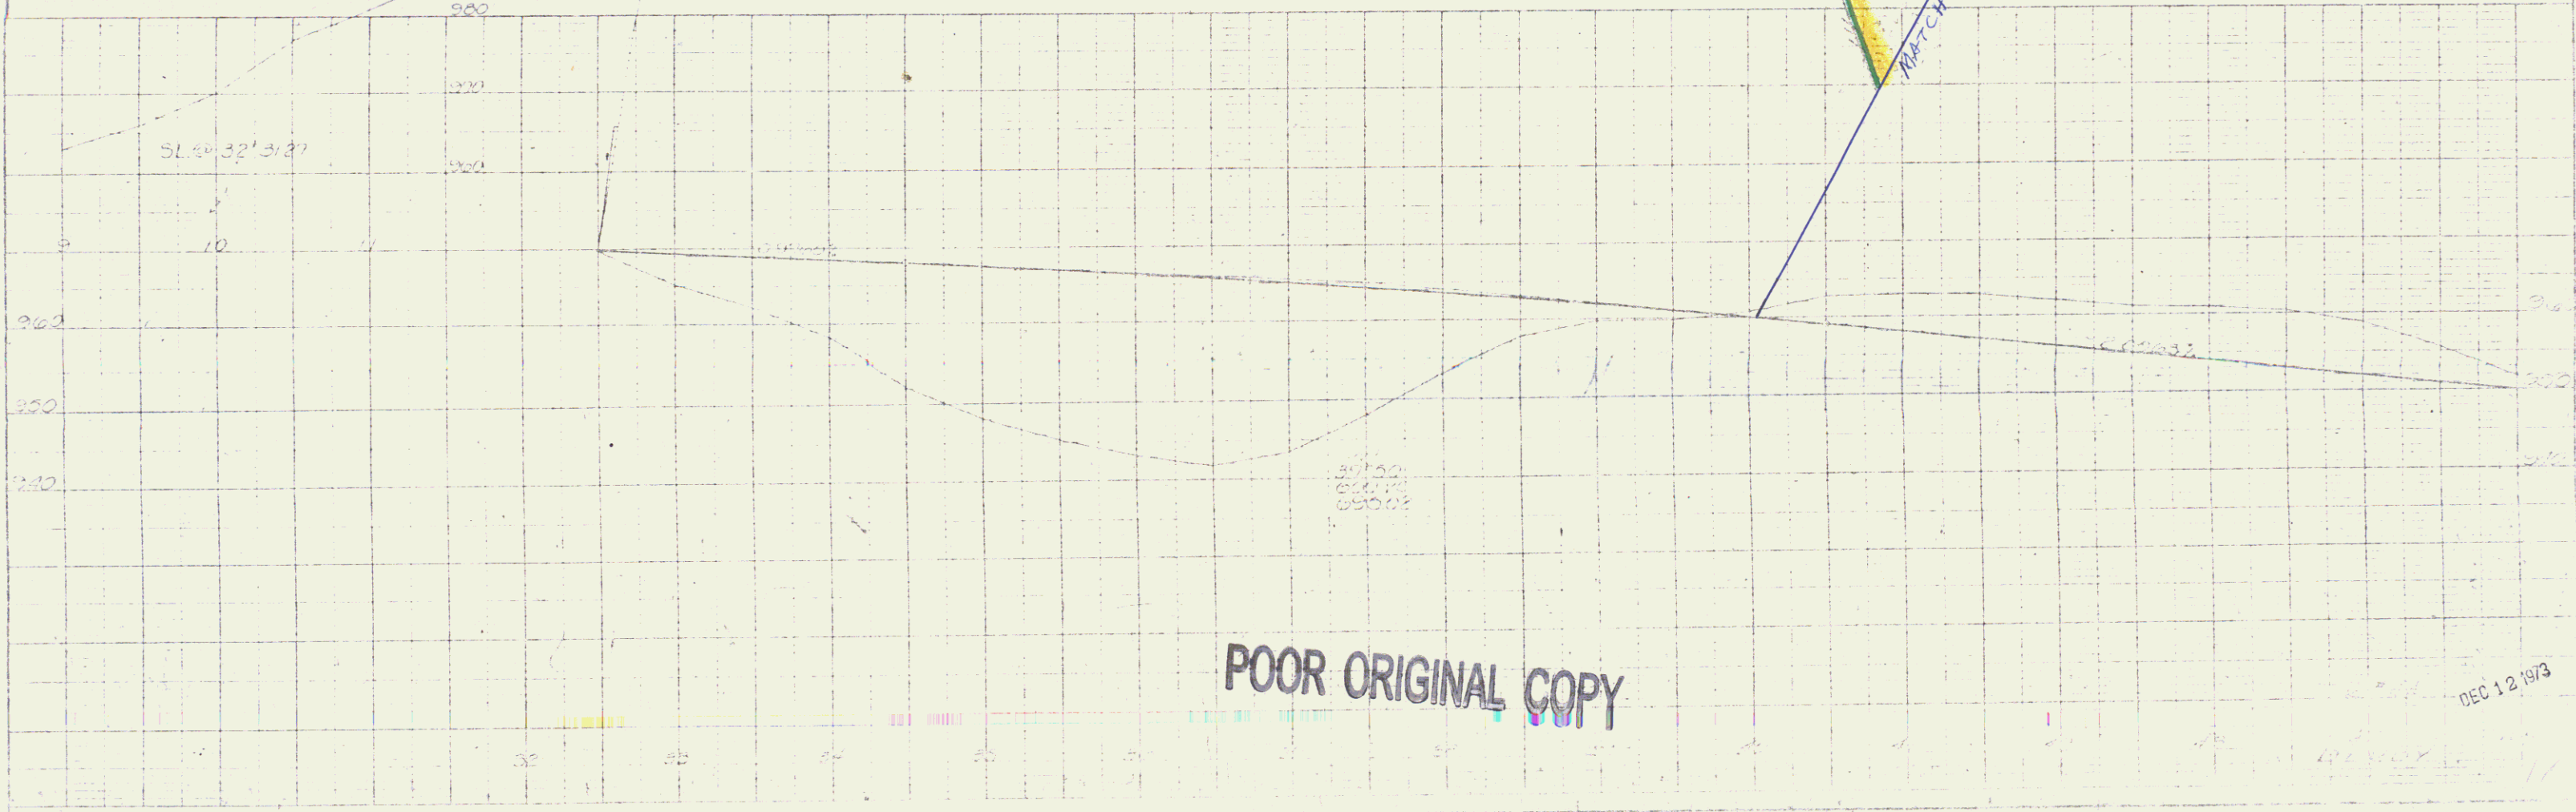

POOR ORIGINAL COPY

DEC 12 1973