


STAGE 2 CONSTRUCTION

58 2965+17.81 - 2965+40.11  
 ACCOMP 16' 00"  
 New 24' 100'

58 2963+70.81 - 2963+118  
 ACCOMP 16' 00"  
 New 24' 118'

58 2971+133 N.B.  
 135'

58 2971+100  
 ACCOMP 16' 00"  
 New 24' 100'

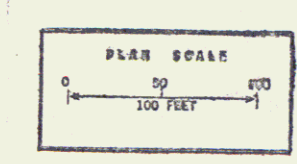

VERMONT DEPARTMENT OF HIGHWAYS  
 RIGHT-OF-WAY PLANS  
 PROJECT: DERBY  
 No. T 91-3(12)  
 SHEET 21 OF 47

POOR ORIGINAL COPY