
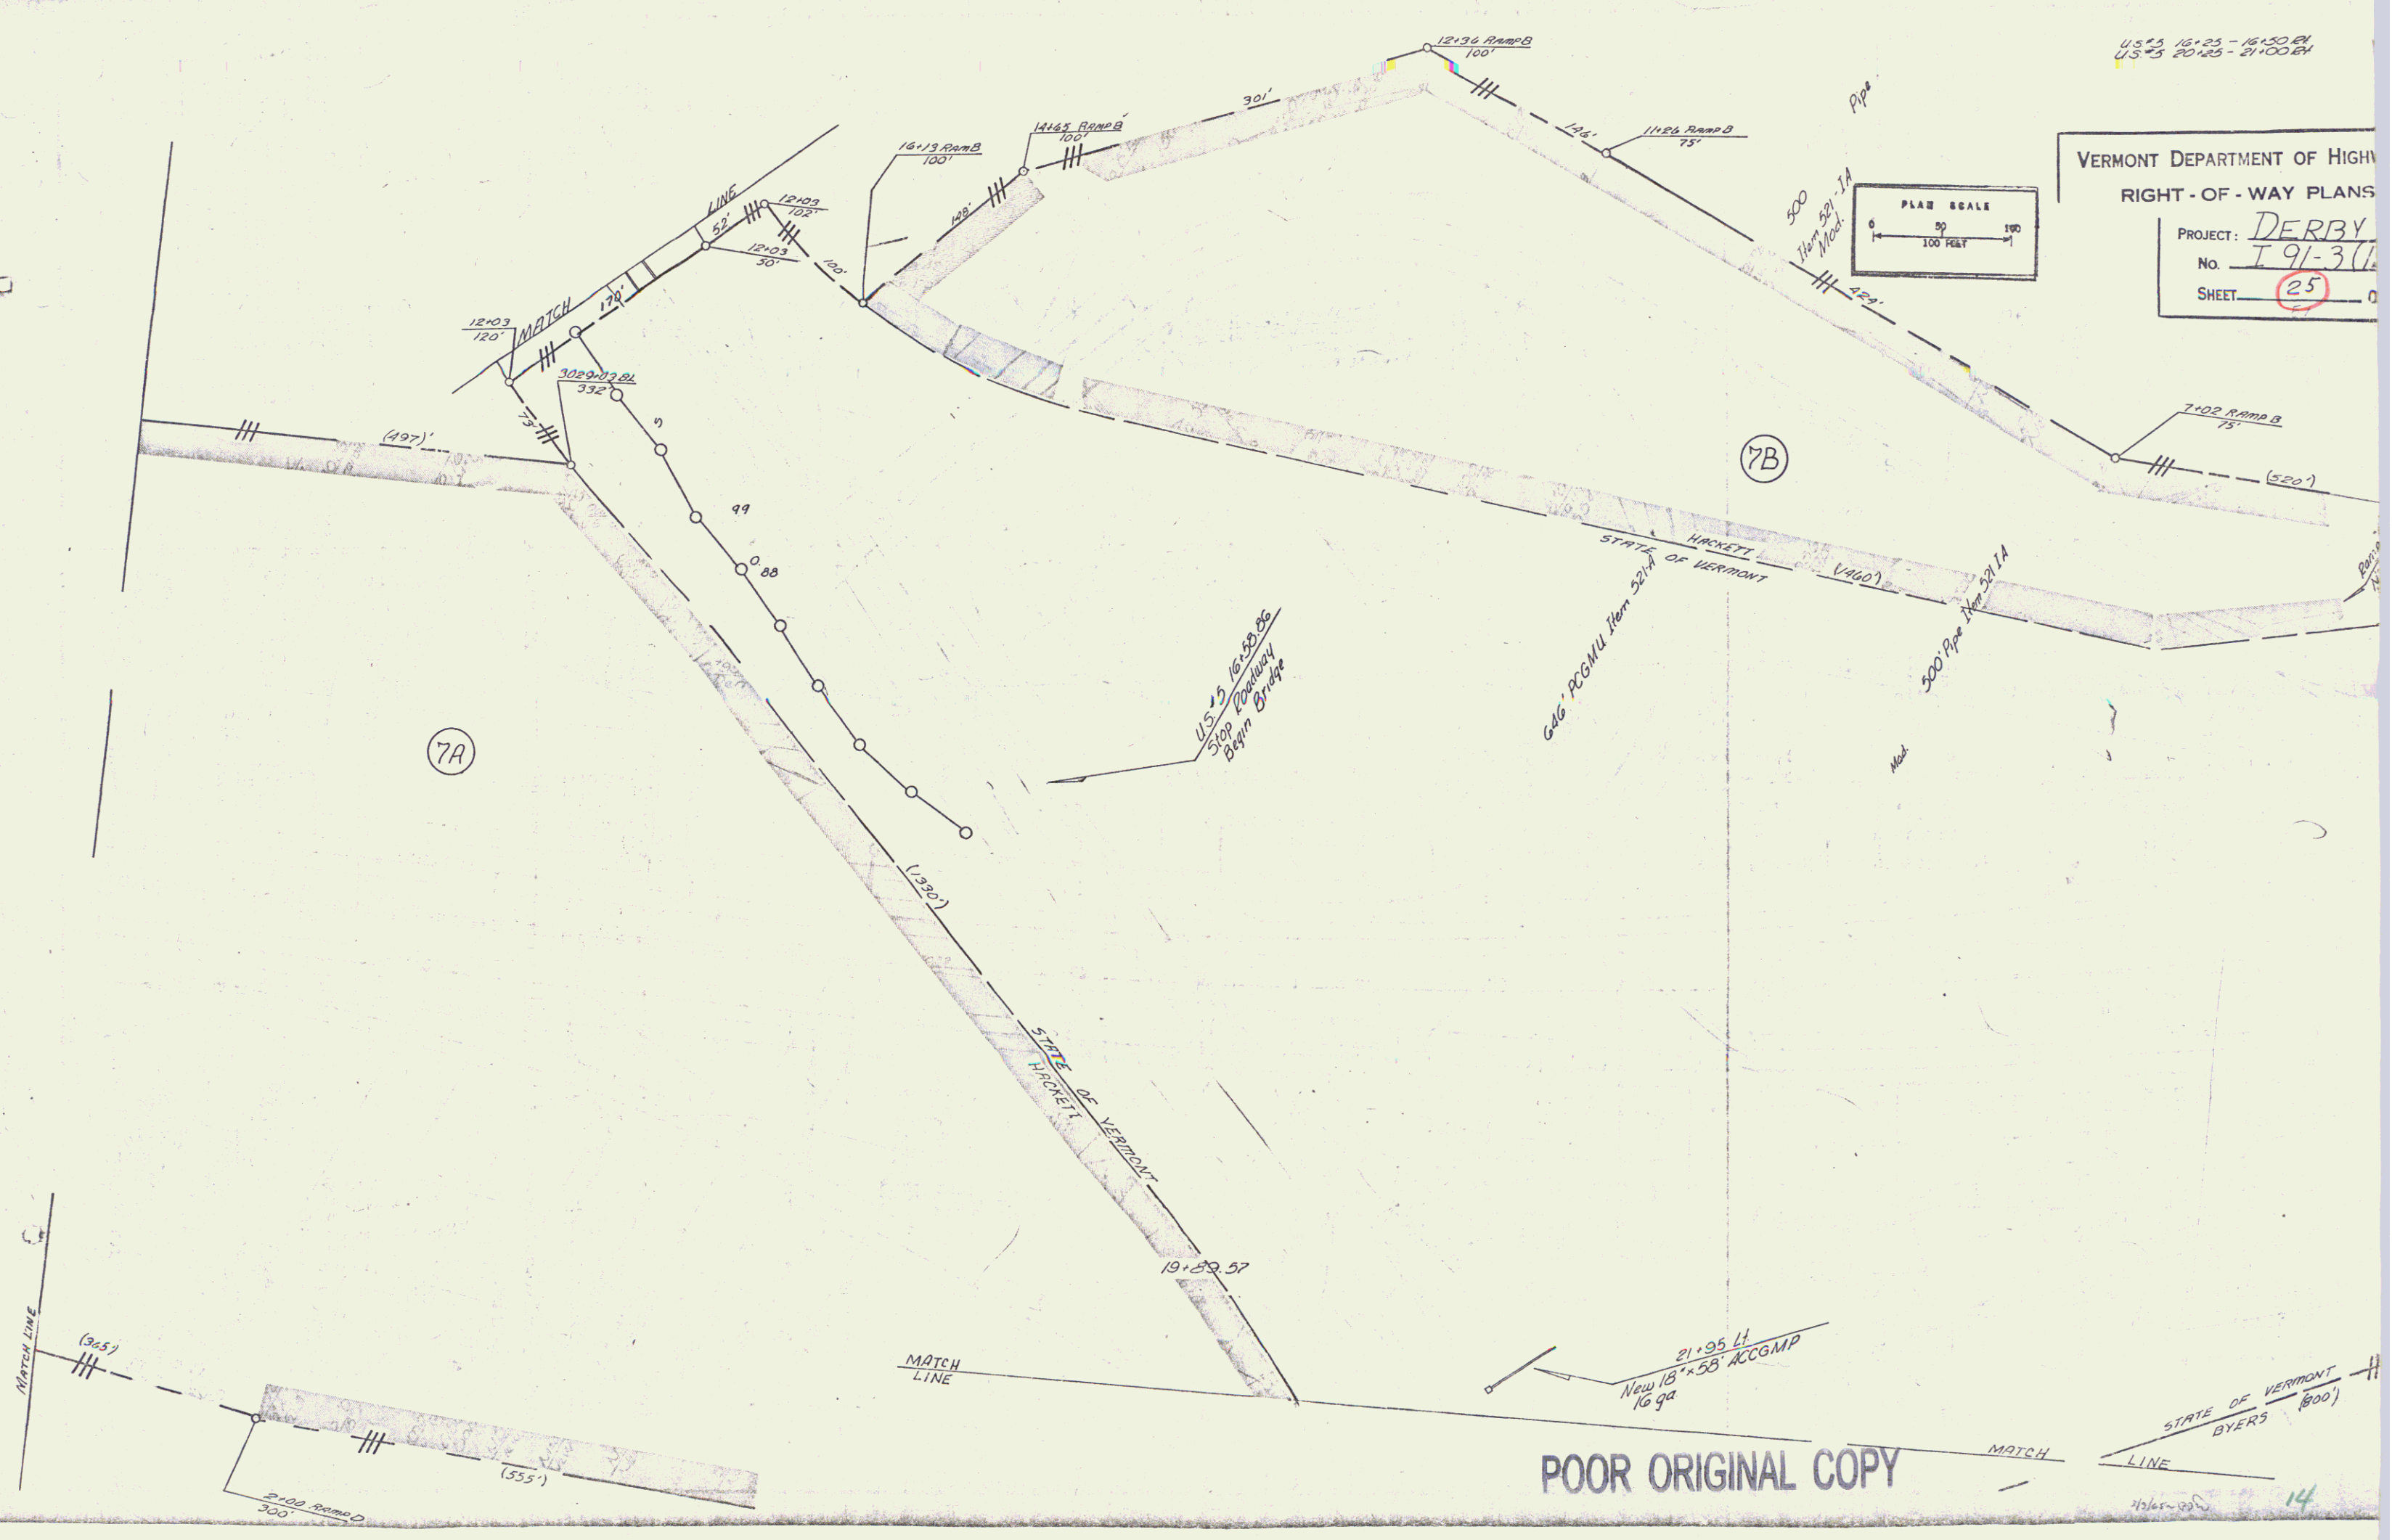


U.S. 25 16+25 - 16+30.84  
U.S. 25 20+25 - 21+00.84

VERMONT DEPARTMENT OF HIGHWAYS  
RIGHT-OF-WAY PLANS  
PROJECT: DERBY  
No. T 91-3 (1)  
SHEET 25 OF 0

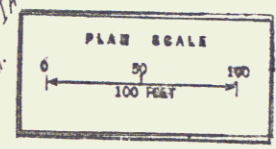

POOR ORIGINAL COPY

1965-03 14