
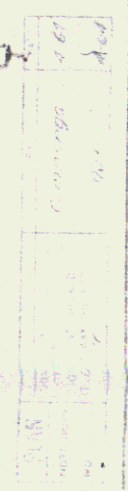


CONST. FORMS HUBER TABLE BOARD 2411 IDENTIFIED DEPOSIT # SLOPE 20/100
 1:50' HORIZ. 1:50' HORIZ. 1:50' HORIZ. 1:50' HORIZ.

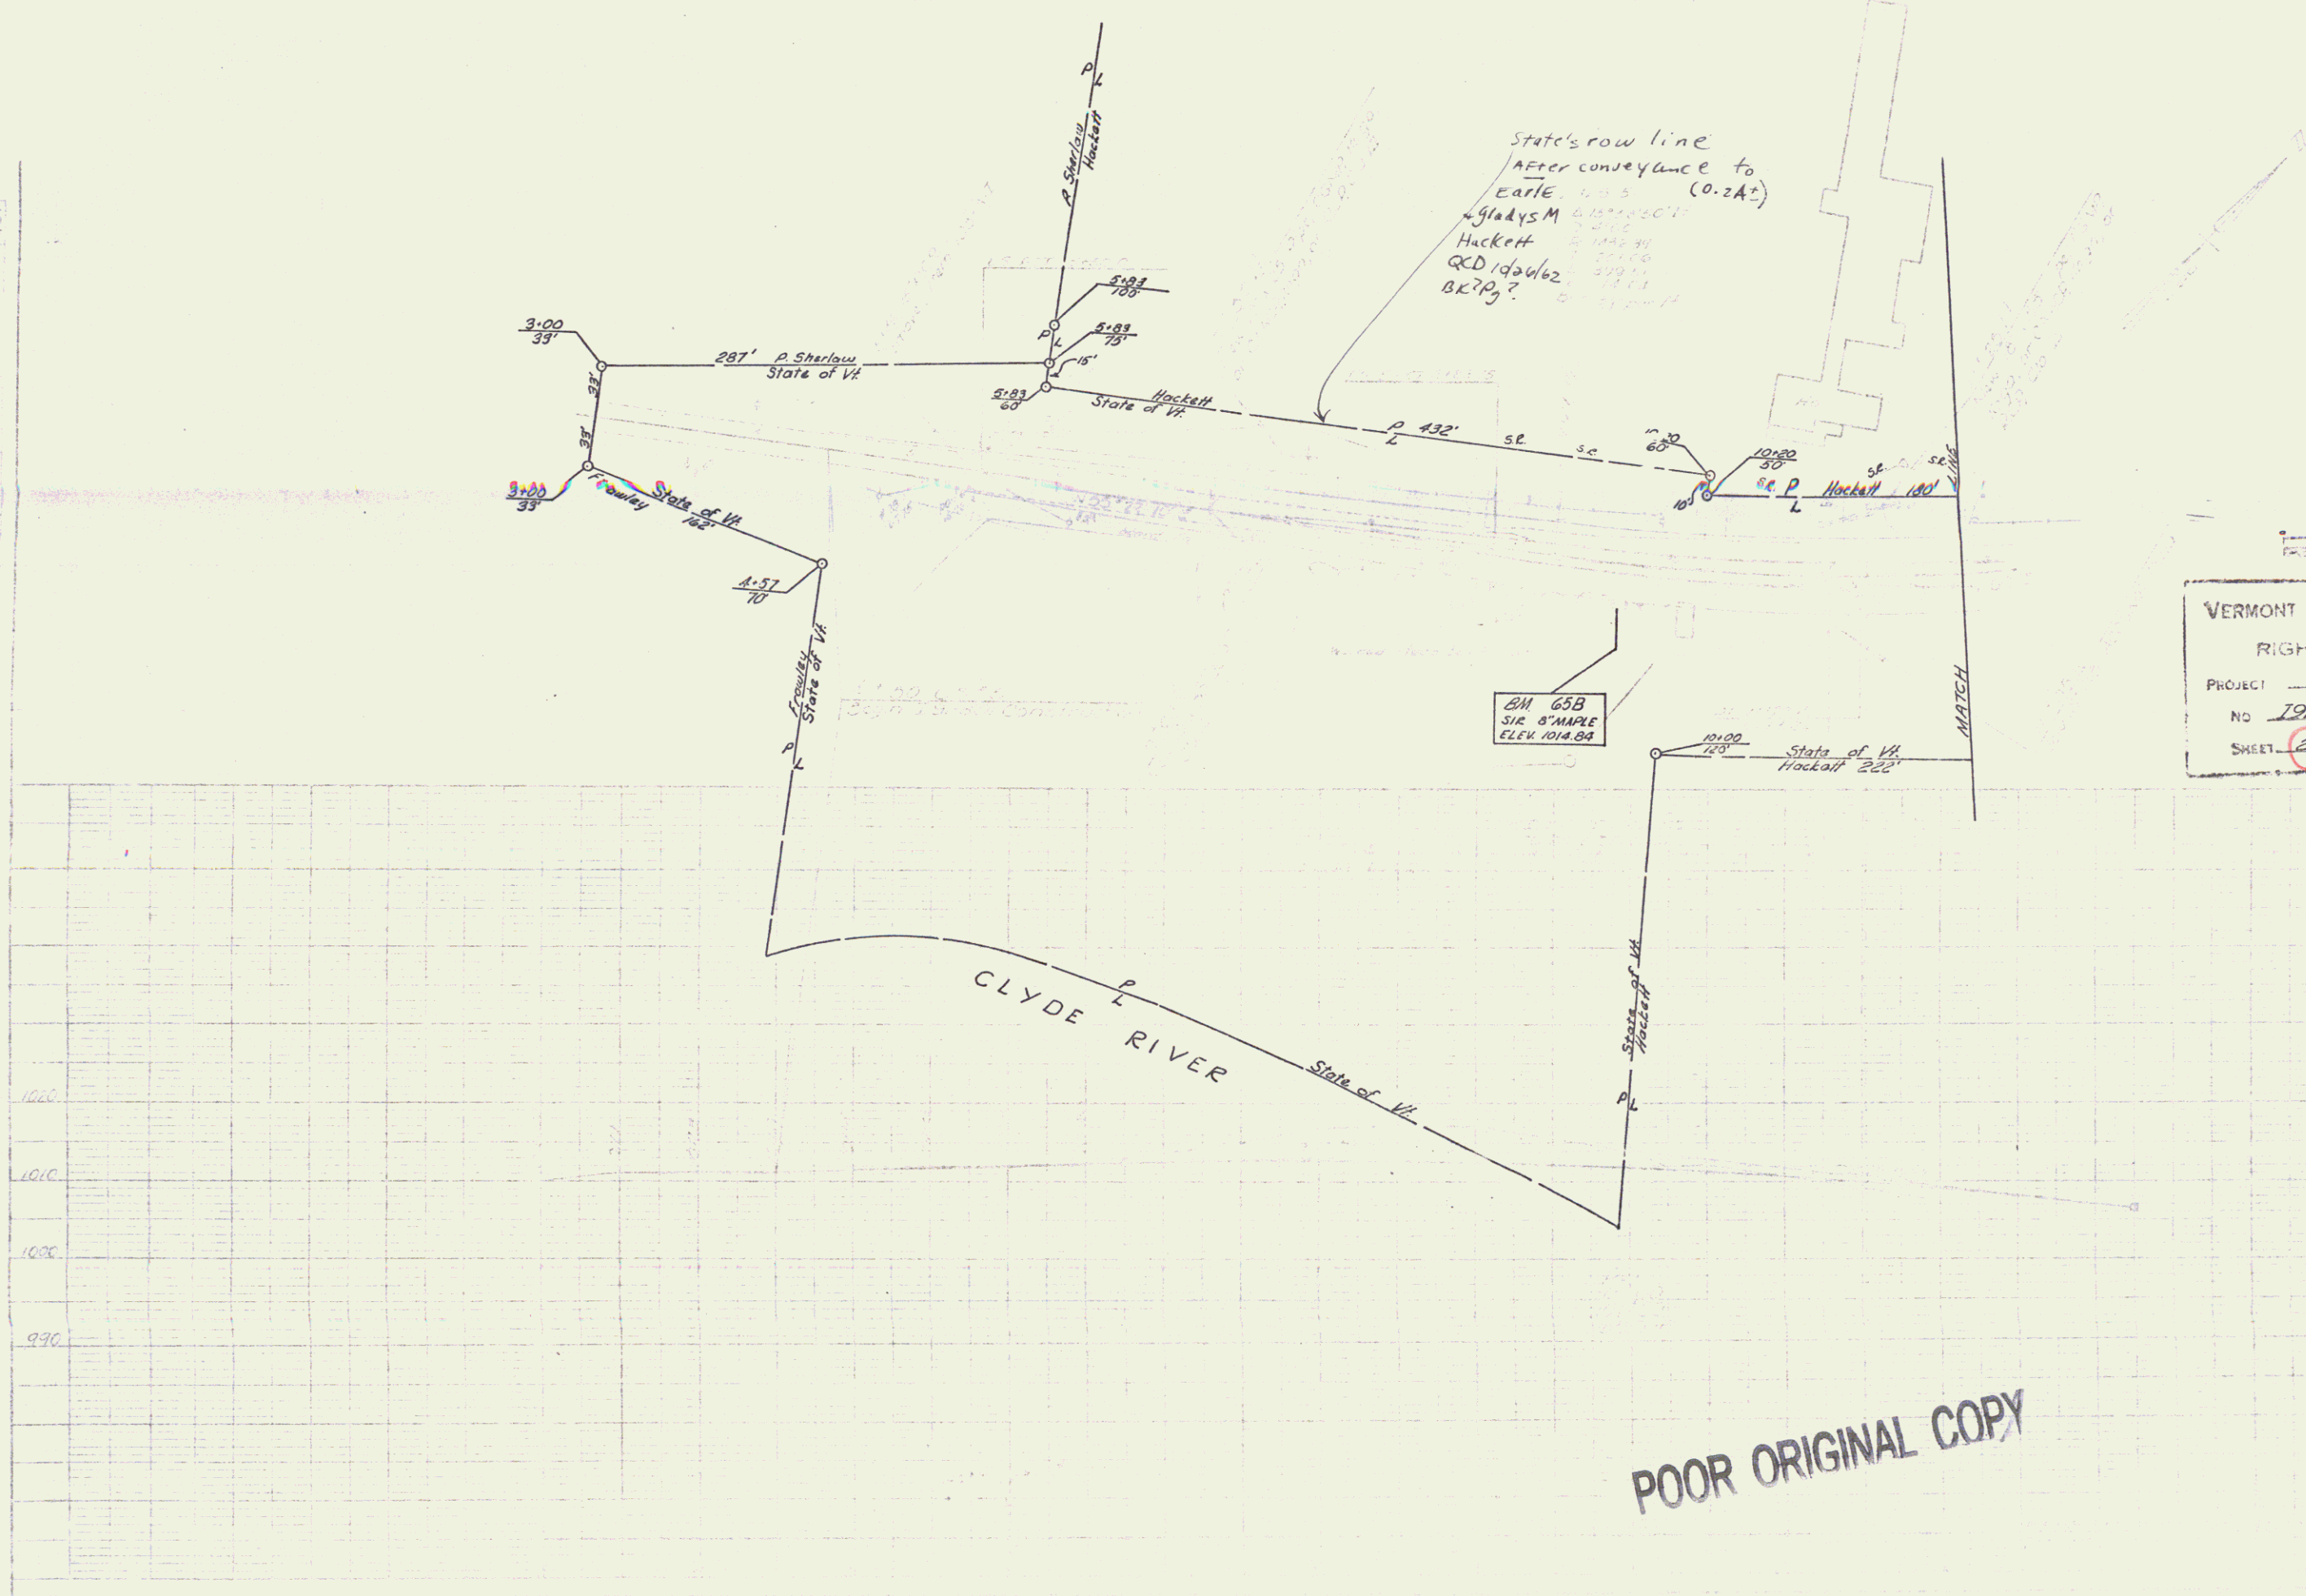

Scale
 1" = 25' HORIZ. 1" = 10' VERT.

VERMONT DEPARTMENT OF HIGHWAYS
 RIGHT-OF-WAY PLANS
 PROJECT DERBY
 NO. 191-30(2)
 SHEET 27A OF 47

POOR ORIGINAL COPY