

PROPERTY LINE FENCE STAGE 2
 ITEM 533-IL Mod
 S.B. 2899+00'-2909+41.4'
 N.B. 2899+00'-2909+00.0'
 DEMOLITION AND DISPOSAL
 OF BUILDING, ITEM 506
 N.B. 2914+45.0'



DRILLING AND BLASTING
 OF SOLID ROCK SUBGRADE
 ITEM 115
 N.B. 2899+00'-2915+00'
 S.B. 2899+00'-2899+50'
 S.B. 2900+70'-2901+29.65'
 S.B. 2902+70'-2903+70.20'

BM 94
 U3 Elev.
 907.88

Ramp D
 Δ 16' 00" Lt.
 D 3' 00"
 R 1909.86
 T 268.41
 L 533.33
 Ent. 5' 11"

SELECTIVE THINNING AND TRIMMING
 ITEM 601
 S.B. 2907+00'-2910+75 Lt.
 S.B. 2911+75'-2915+00 Lt.
 S.B. 2899+50'-2900+50 Rt.
 S.B. 2900+75'-2910+00 Rt.
 S.B. 2910+50'-2915+00 Rt.
 N.B. 2905+50'-2909+10 Rt.
 N.B. 2910+00'-2913+00 Rt.
 N.B. 2914+50'-2915+00 Rt.

Demolition and Disposal
 of Building, Item 506
 N.B. 2914+45.0'

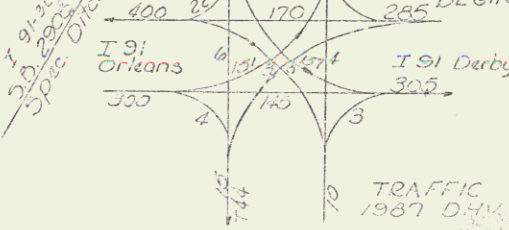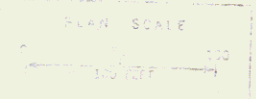

DERBY
 SURVEYED BY: J. J. [unclear] DATE: 9/50
 DRAWN BY: [unclear] DATE: 11/53
 TRACED BY: [unclear] DATE: 1/54
 PROJ. I No. 31 (1/52)
 SHEET 37 OF 55
 22

JUL 11 1974