


24" SUB-BASE OF SAND  
SB 2963+00 - 2966+00

DRILLING AND BLASTING OF  
SOLID ROCK SUBGRADE, ITEM 115  
+ NB 2963+00 - 2966+50  
SB 2963+00 - 2966+00  
+ NB 2963+00 - 2964+00 Restrict Drilling &  
Blasting of Solid Rock Subgrade to Child Limits  
\* STAGE 2 CONSTRUCTION

SELECTIVE THINNING AND  
TRIMMING, ITEM 601  
SB 2963+00 - 2970+00  
SB 2972+50 - 2979+00  
SB 2963+00 - 2979+00  
NB 2963+00 - 2979+00

\* THREE CABLE GUARD RAIL W/  
LIGHT STEEL POSTS, ITEM 5  
NB 2963+00 - 2979+00  
SB 2963+75 - 2979+00  
SB 2971+75 - 2974+75  
\* TREATED TIMBER CURB  
ITEM 358  
NB 2973+00 - 2979+00  
SB 2973+00 - 2979+00

PROPERTY LINE FENCE  
W/ STEEL POSTS, W/ 4"  
SB 2963+00 - 2979+00  
NB 2963+00 - 2979+00

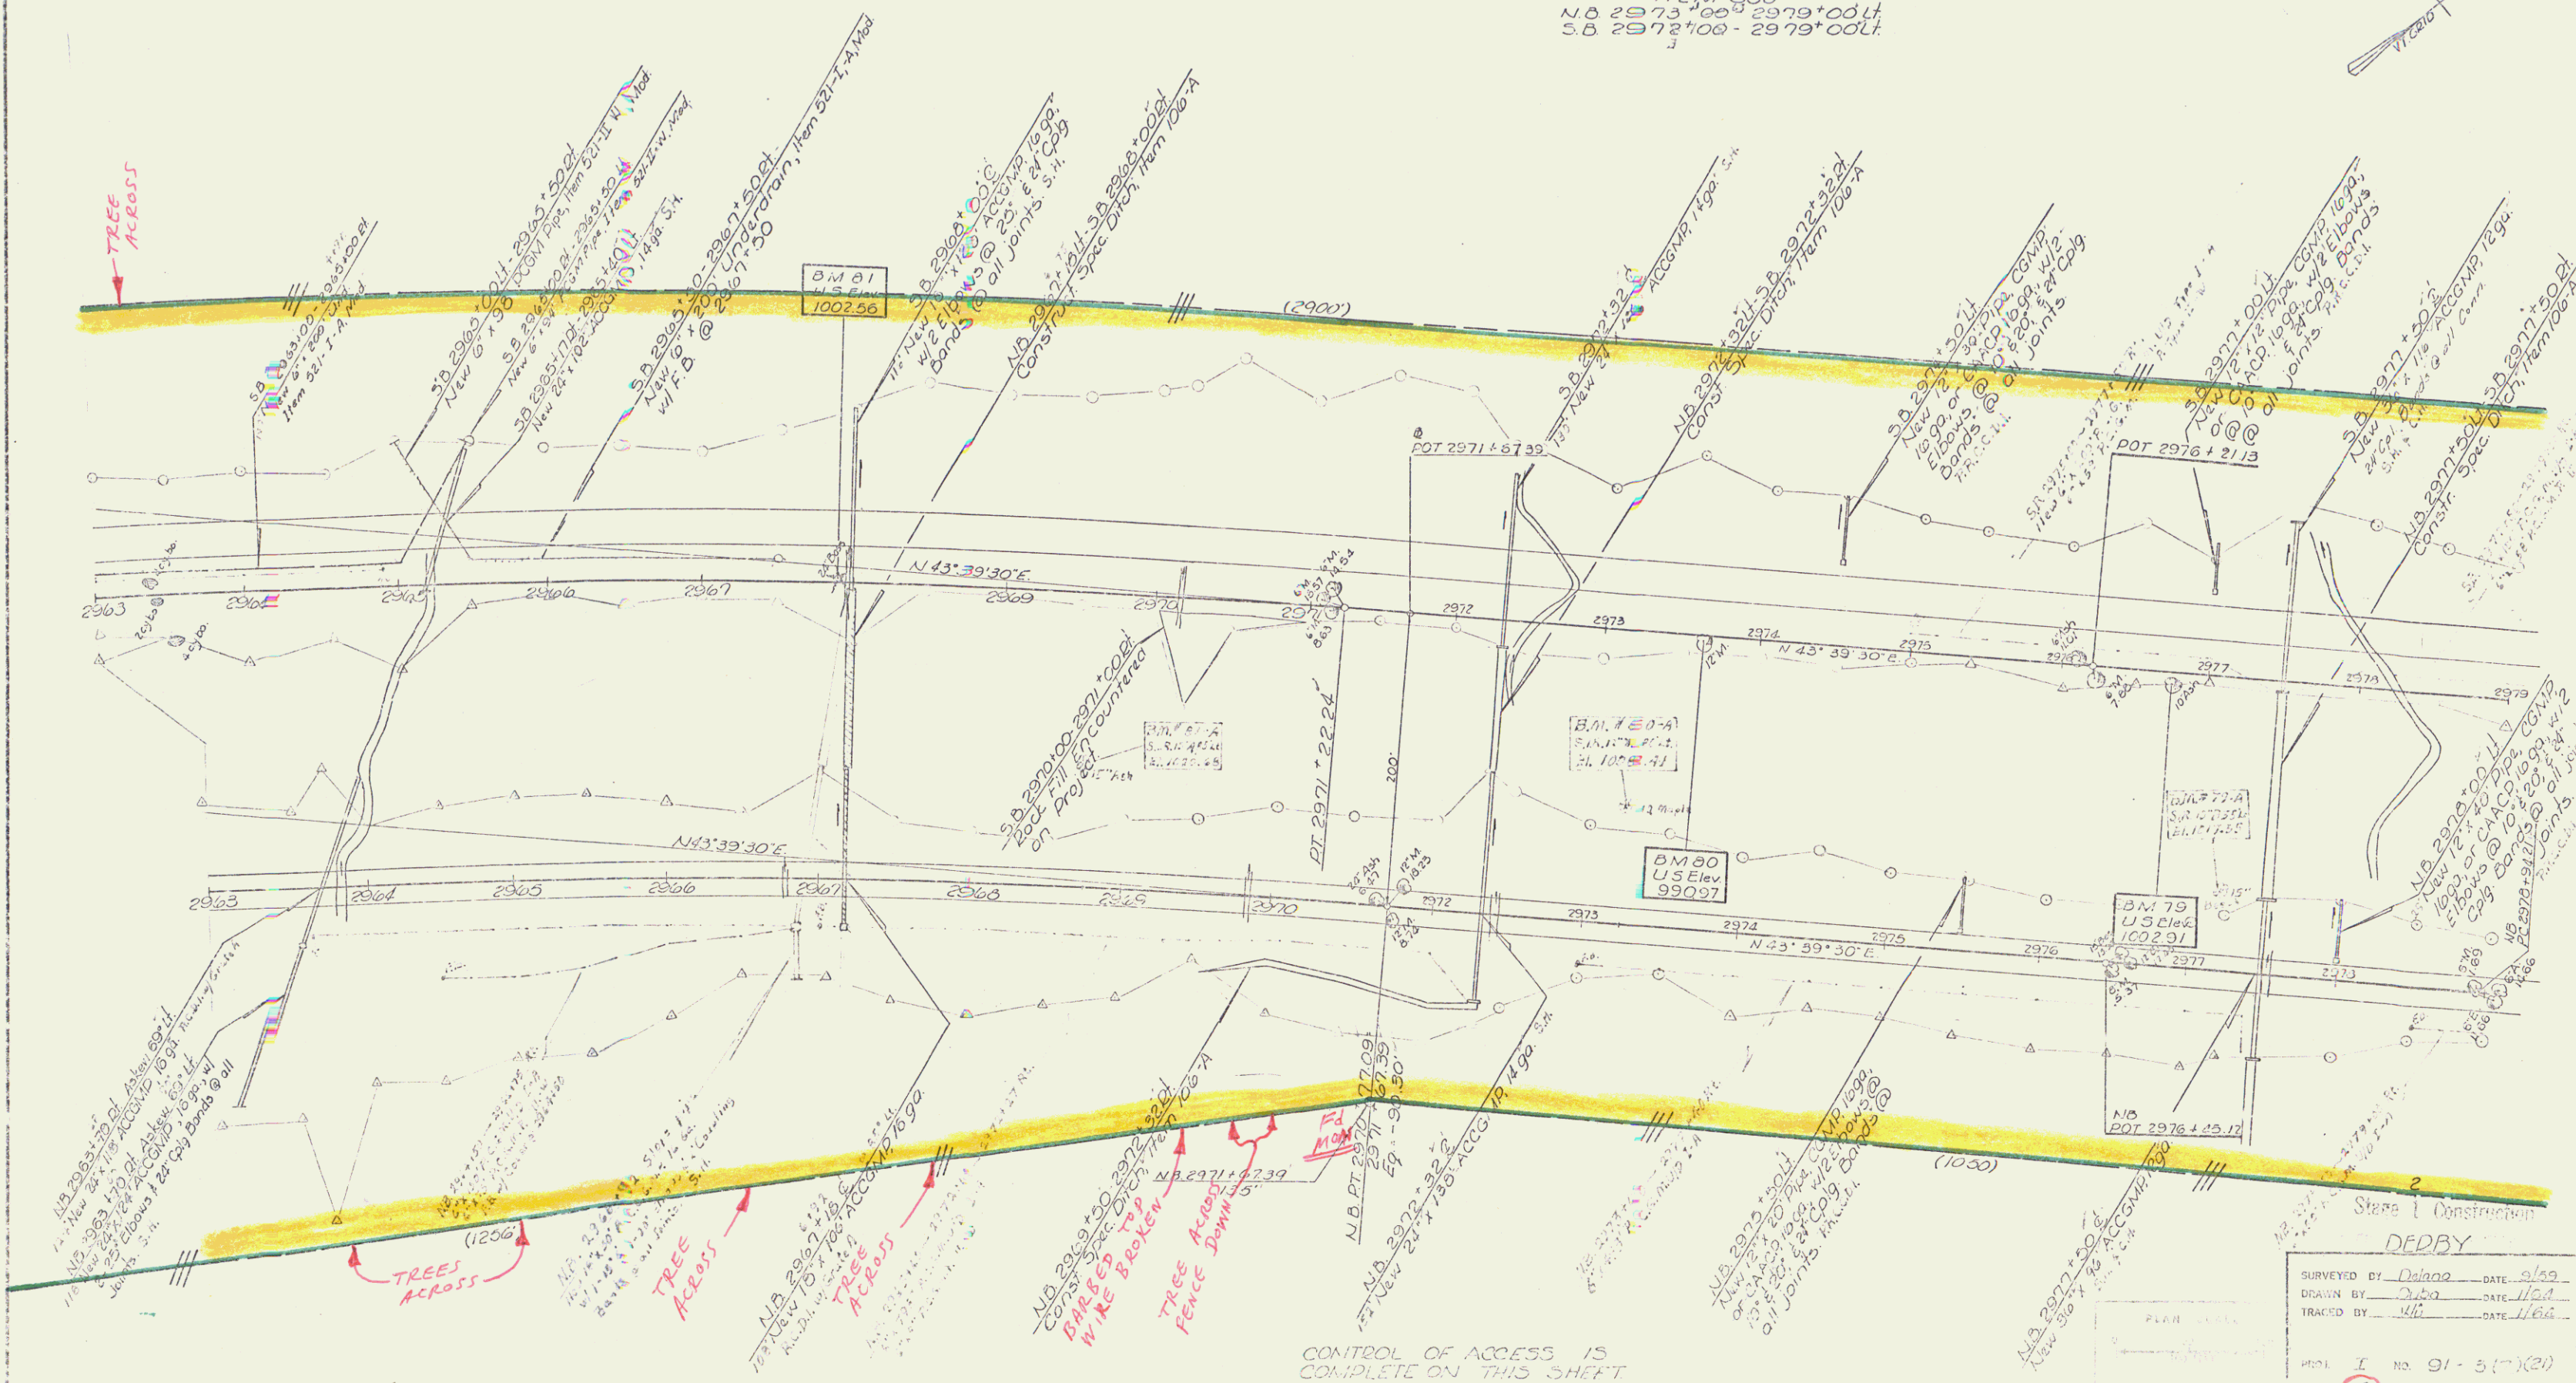

Stage 1 Construction  
DEDBY  
SURVEYED BY: Dahn DATE: 9/59  
DRAWN BY: Dahn DATE: 11/60  
TRACED BY: Uli DATE: 11/60  
SHEET 42 OF 554  
ROW 26  
JUL 11 1974

CONST