


Cummings  
A.I.A.  
8/84

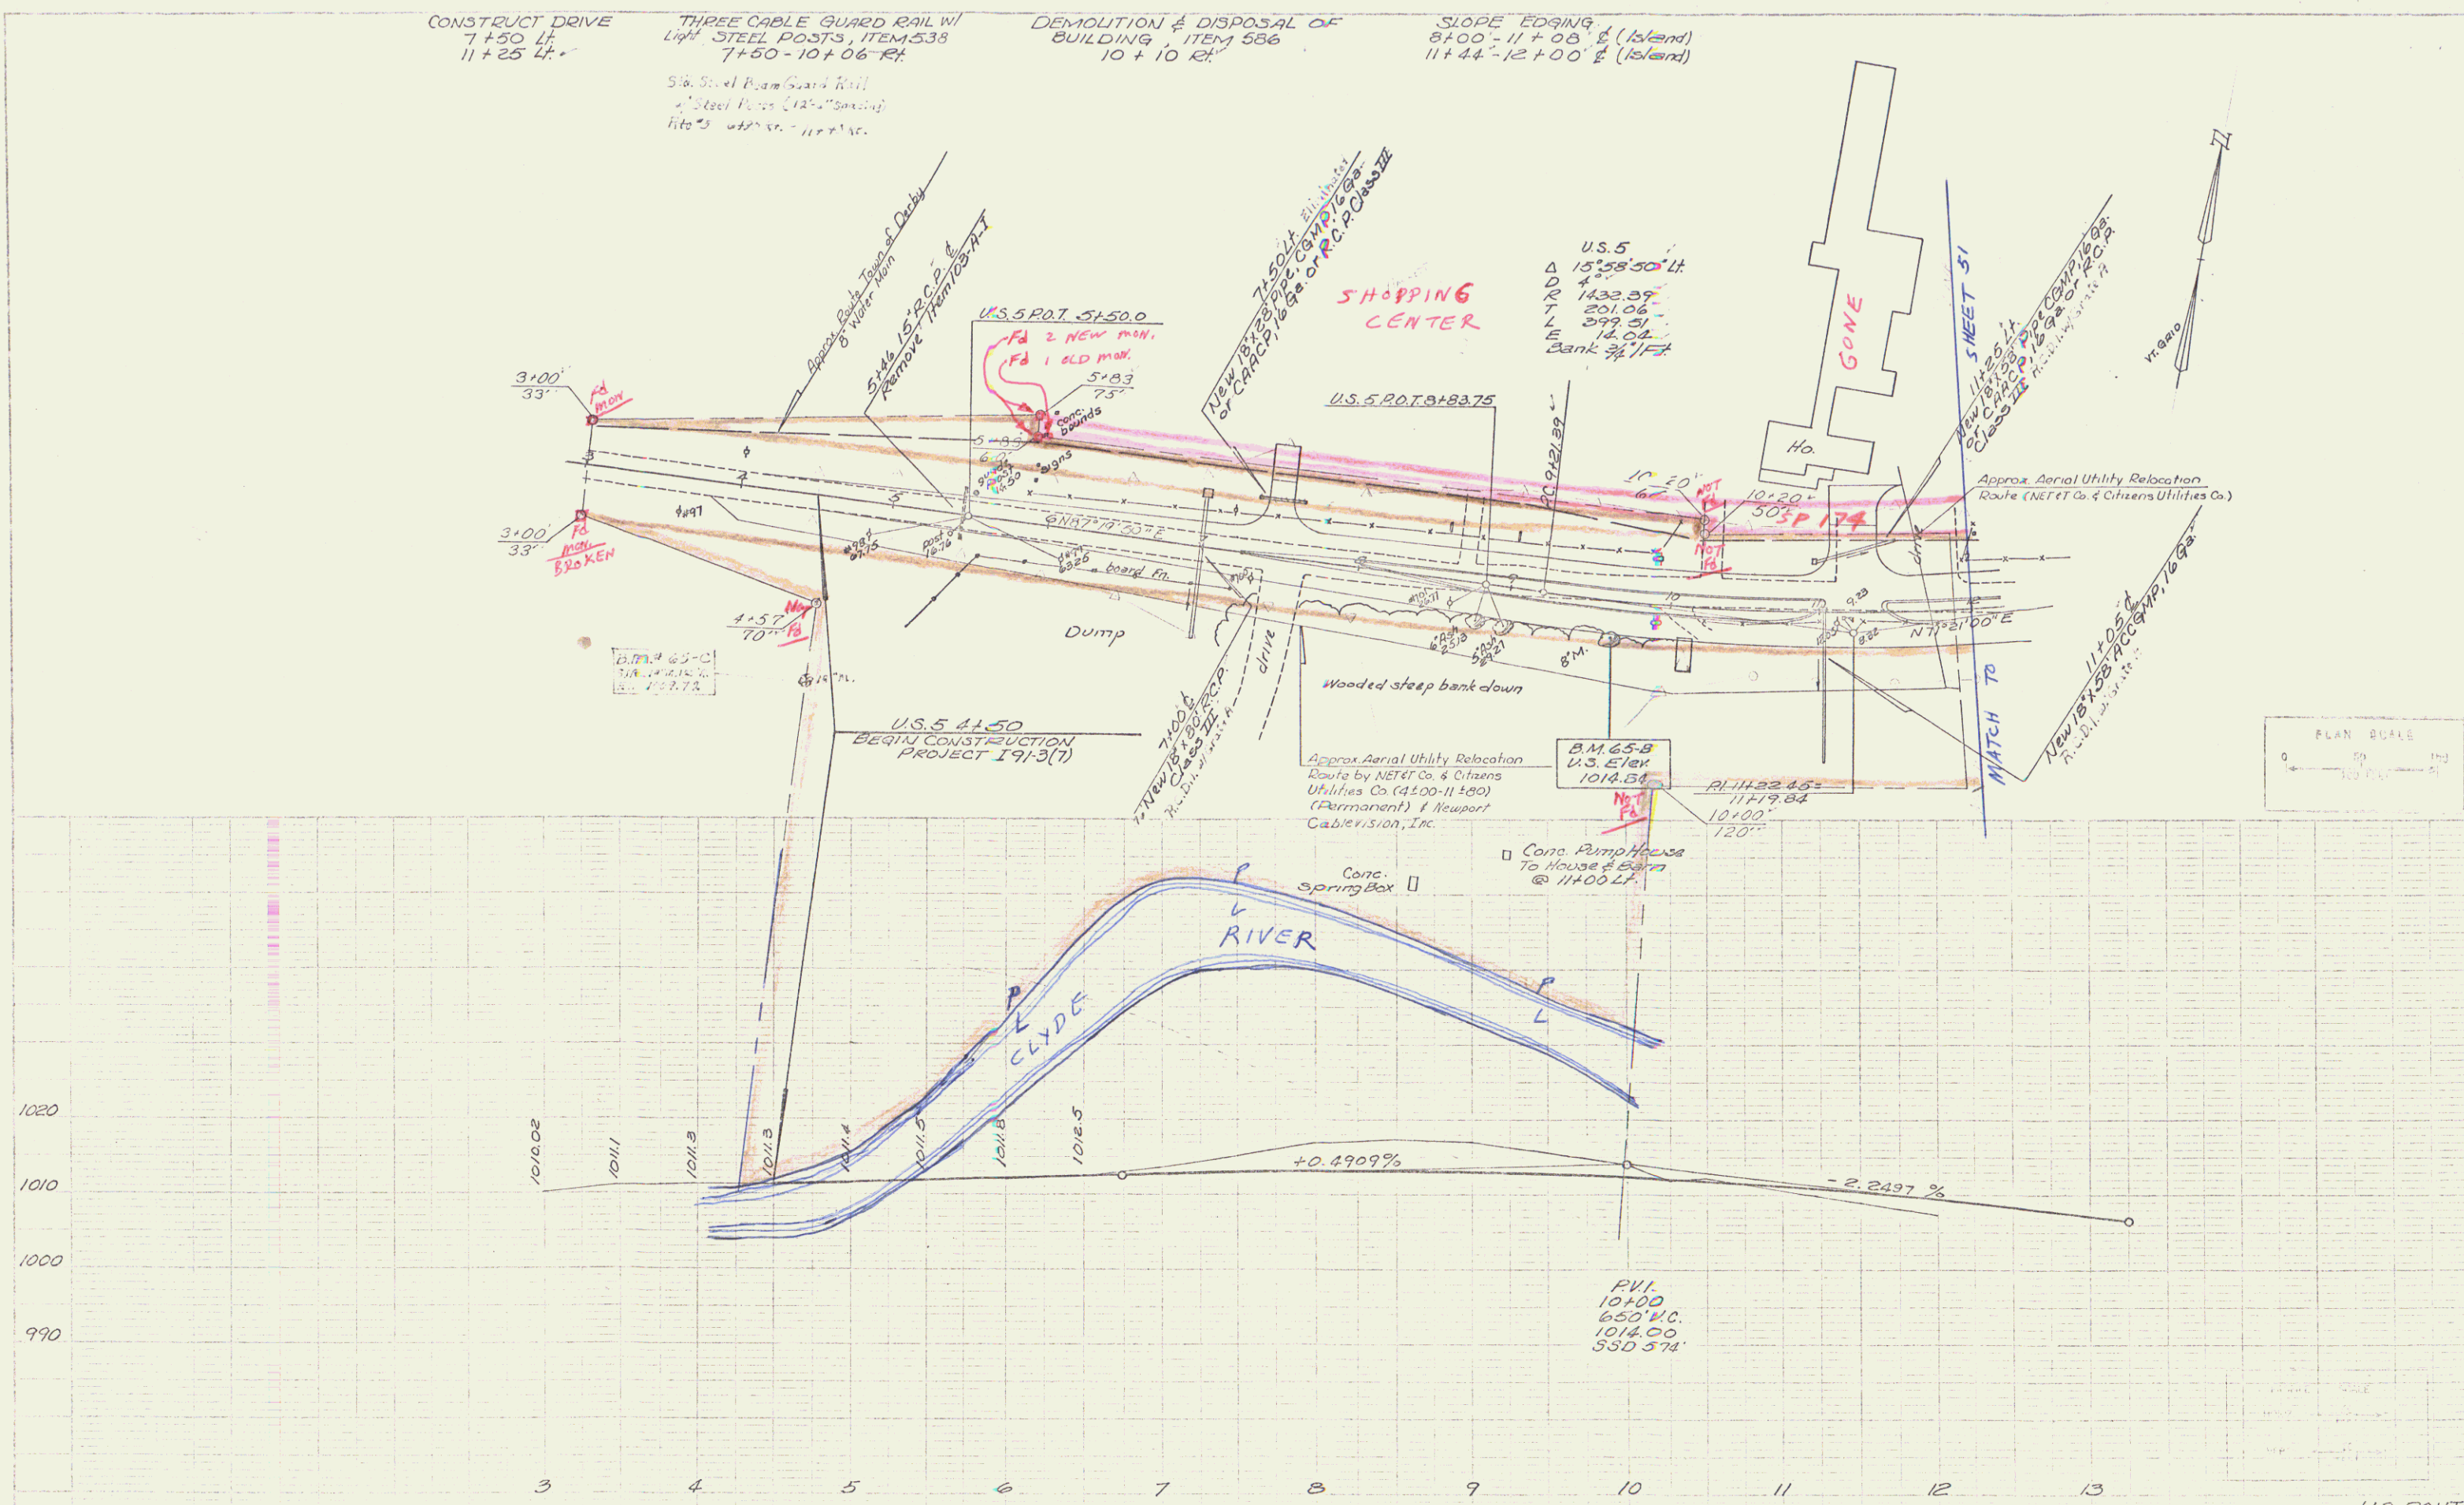

TO BE BUILT IN ITS ENTIRETY  
DURING STREET CONSTRUCTION.

U.S. ROUTE 5  
DERBY  
191-3(7)  
Sheet 55 of 55