
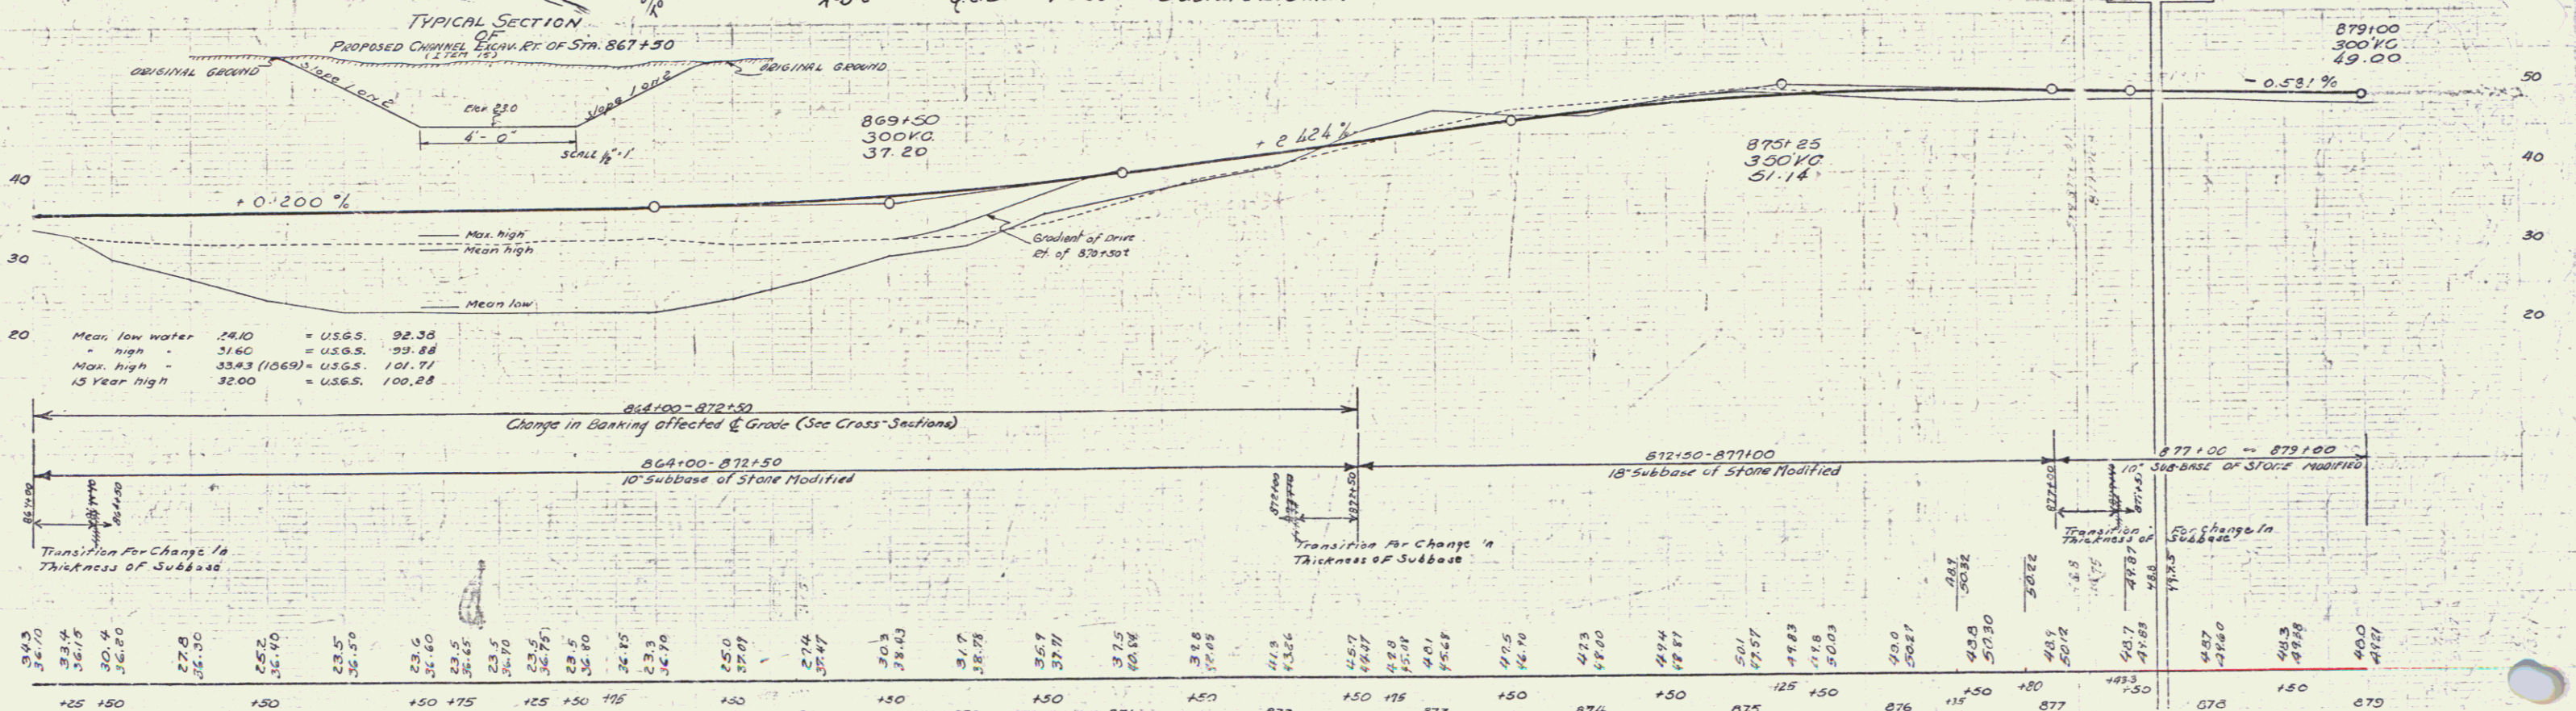


**NOTE:**  
 Sta 864+00 - 871+00 LT.  
 Sta 864+00 - 868+50 RT.  
 FILL TO BE MADE  
 FRONT LEASE EXCAVATION  
 ENCOUNTERED ON PROJECT.

STA 873+00 - STA 876+50 LEFT  
 Clearing & Trimming Roadside (Item 100)  
 All dead growth to be removed, & such living trees  
 as may be designated by the engineer, to open  
 views of lake.

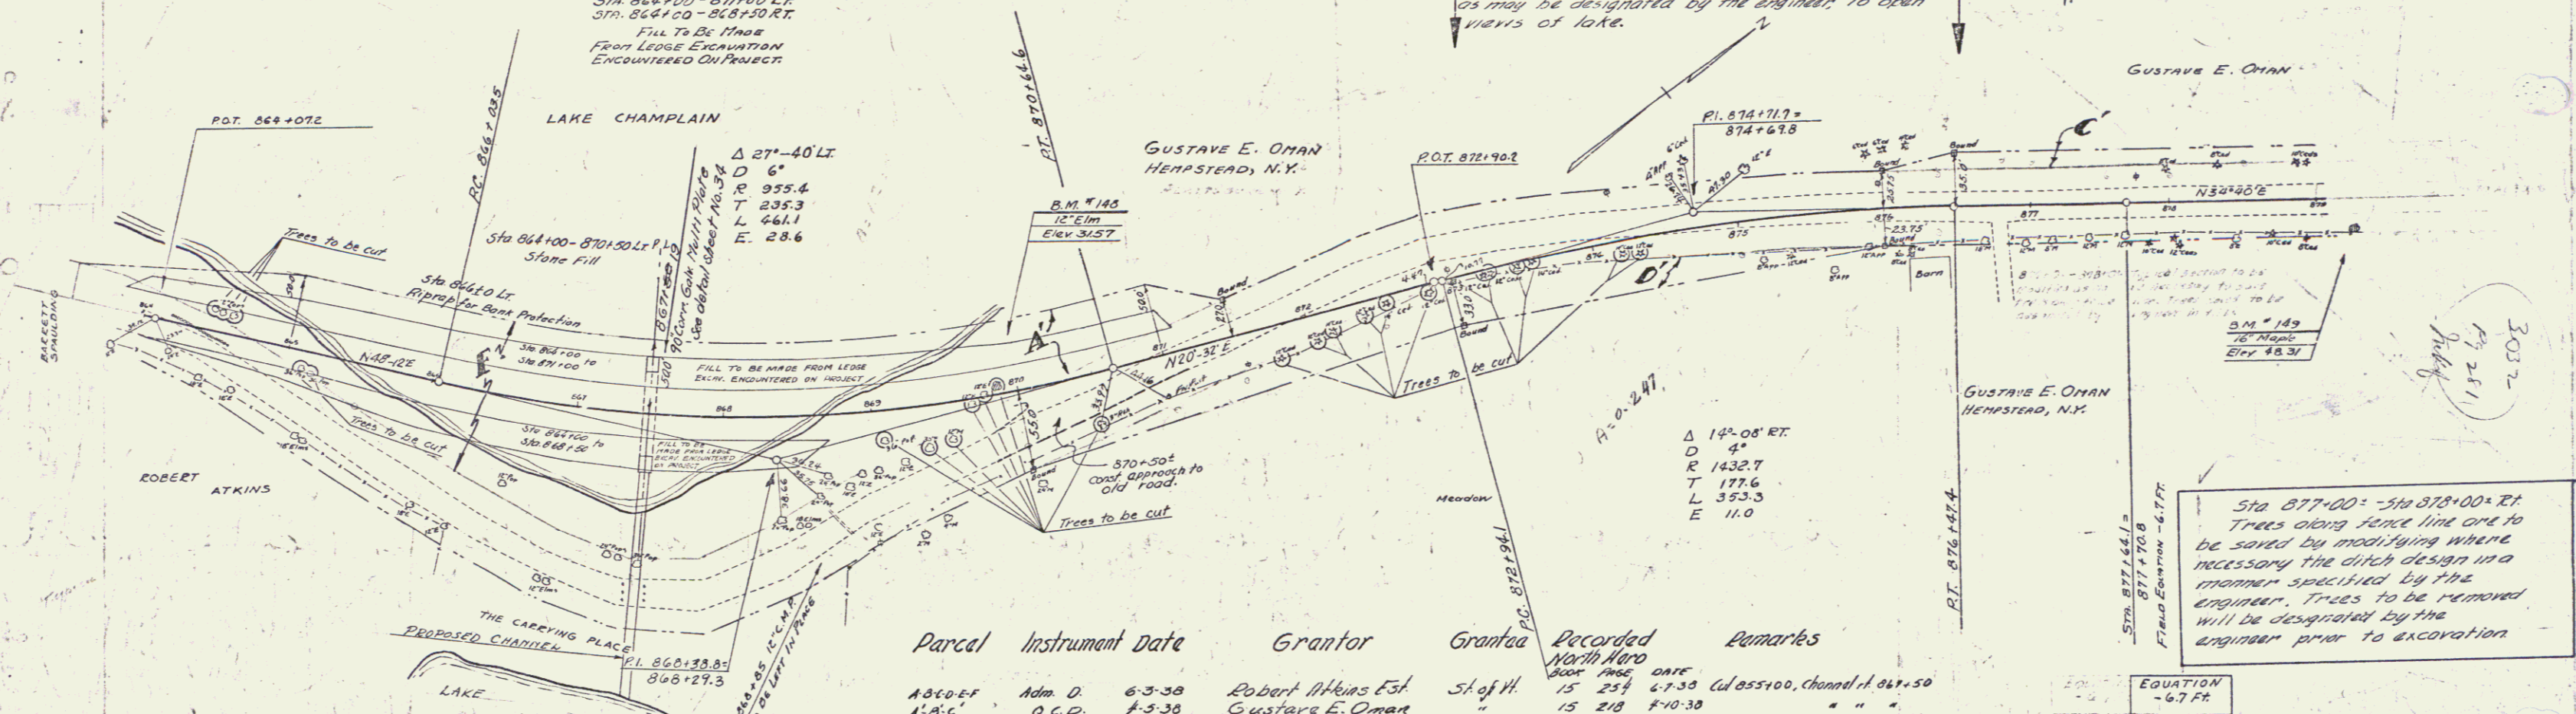

864	865	866	867	868	869	870	871	872	873	874	875	876	877	878	879
30.00	31.74	30.94	32.50	29.92	33.50	33.60	33.5	33.5	33.5	33.5	33.5	33.5	33.5	33.5	33.5
31.74	30.94	32.50	29.92	33.50	33.60	33.5	33.5	33.5	33.5	33.5	33.5	33.5	33.5	33.5	33.5

B.M. #148 Spike in root of 12" Elm 36' LI Sta 869+00 Elev 31.57  
 B.M. #149 Spike in root of 16" Maple 19' LI Sta 879+23 Elev 48.31