



Control of section of old highway between Sta. 921+00 Lt. and Sta. 926+73 Lt. relinquished to Town of North Hero, Recorded Book 15, Page 302 of Land Records, Date July 15, 1939

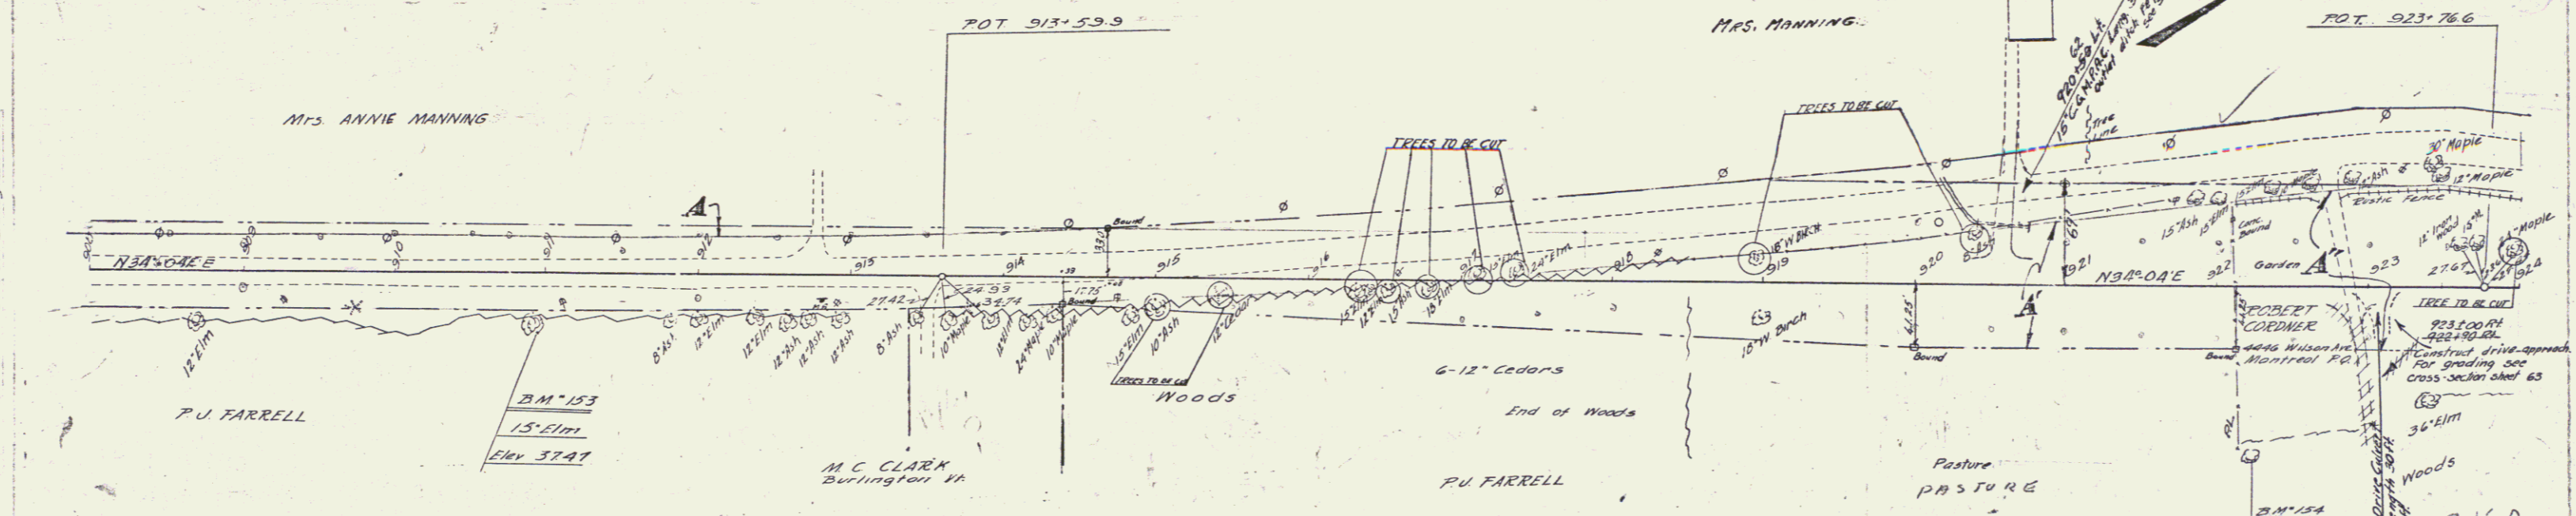

Parcel	Instrument Data	Grantor	Grantee	Recorded North Hero Book Page Date	Remarks
A	Q.C.D. 4-28-38	Mrs. Annie Manning	Shel H.	15 247 5-3-38	
A-B	N.D. 4-21-38	P.J. Farrell	"	15 239 5-3-38	Cut 926+50
A"	Q.C.D. 4-29-38	R.L. Cordner	"	15 245 5-3-38	

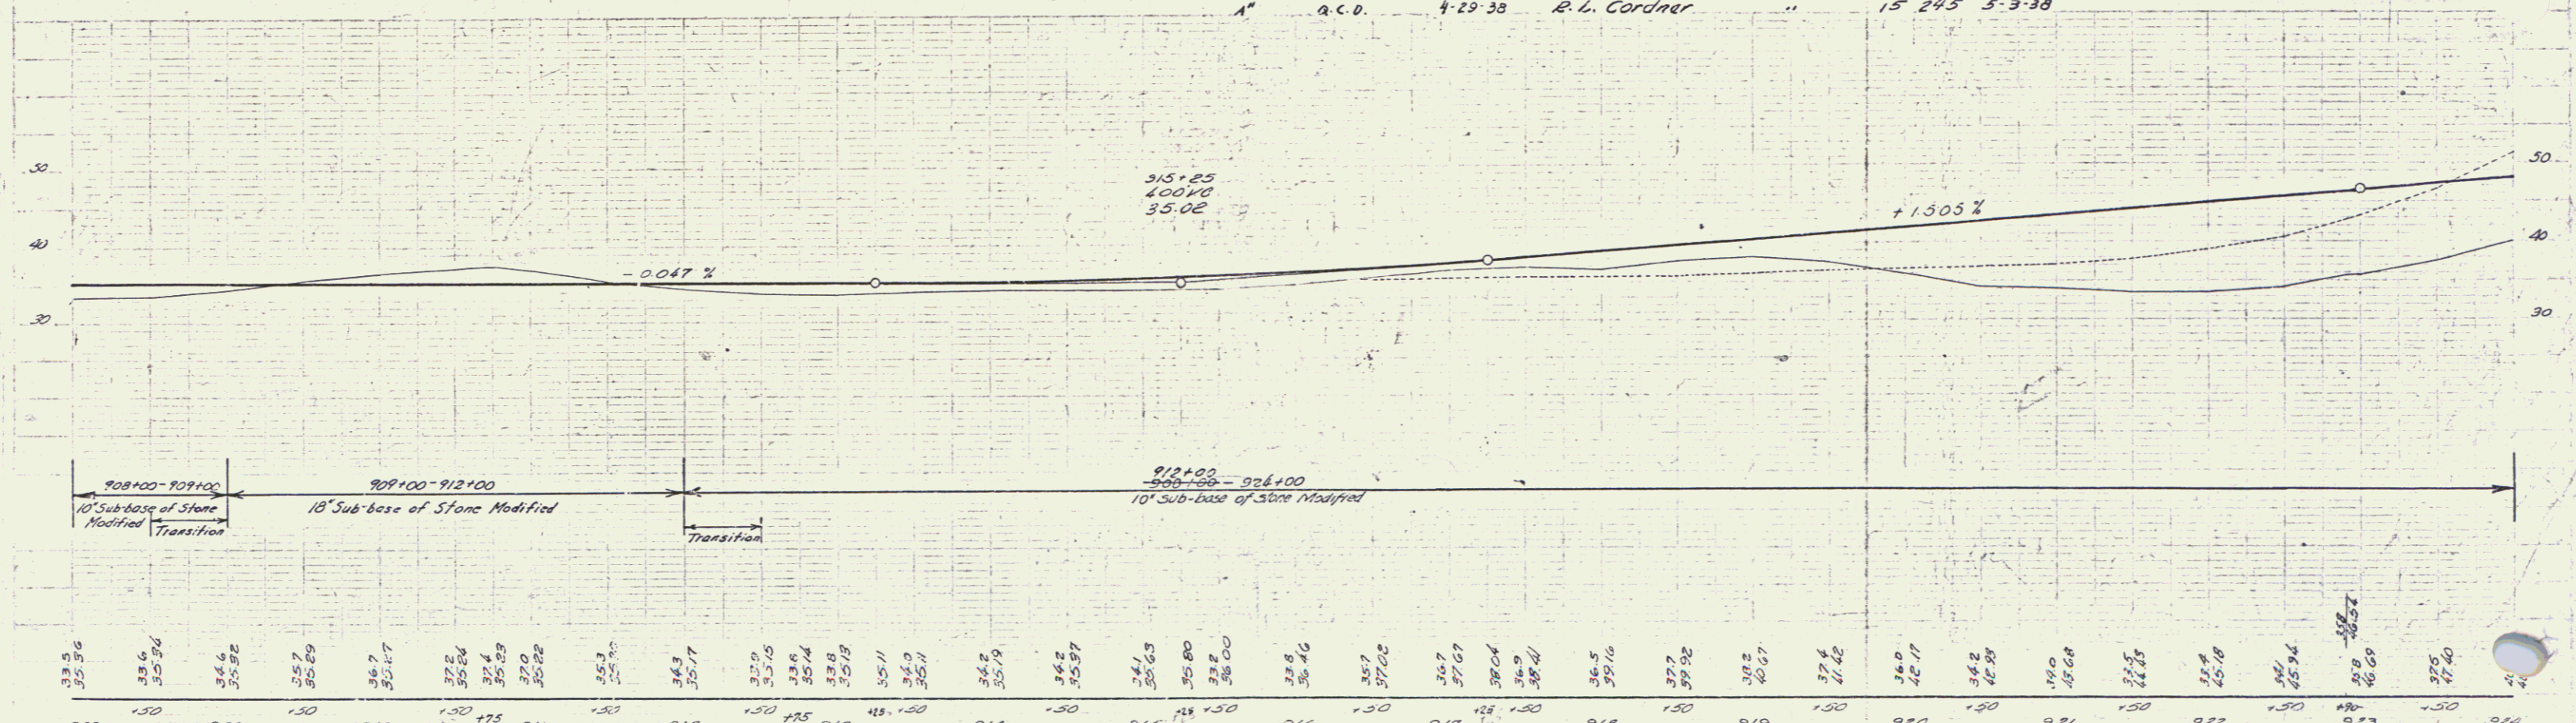

908	33.5	35.56	1.30	909	33.6	35.96	1.30	910	34.6	35.82	1.30	911	35.7	35.89	1.30	912	36.7	35.77	1.30	913	37.2	35.54	1.30	914	37.4	35.29	1.30	915	37.0	35.22	1.30	916	35.7	35.22	1.30	917	35.7	35.22	1.30	918	36.5	35.22	1.30	919	37.7	35.22	1.30	920	38.2	35.22	1.30	921	38.2	35.22	1.30	922	38.2	35.22	1.30	923	38.2	35.22	1.30	924	38.2	35.22	1.30
-----	------	-------	------	-----	------	-------	------	-----	------	-------	------	-----	------	-------	------	-----	------	-------	------	-----	------	-------	------	-----	------	-------	------	-----	------	-------	------	-----	------	-------	------	-----	------	-------	------	-----	------	-------	------	-----	------	-------	------	-----	------	-------	------	-----	------	-------	------	-----	------	-------	------	-----	------	-------	------	-----	------	-------	------

SERIES FAP NO 188 G SHEET 11 OF 104

N.H.P.C. (8)