


Parcel	Instrument Data	Grantor	Grantee	Recorded North	Recorded Page	Recorded Date	Remarks
A	a.c.d.	4-28-38	John Tudhope	15	248	5-3-38	
A'-B'	a.c.d.	4-22-38	Mrs. Harriet D. Beardsley	"	15	221	4-27-38
A''-B''-C''	a.c.d.	5-26-38	John & Mary T. Howes	"	15	252	6-3-38 Ctd. 935+65
A'''-B'''-C'''	a.c.d.	5-13-38	Fenton Hazen	"	15	250	5-16-38 " 953+77

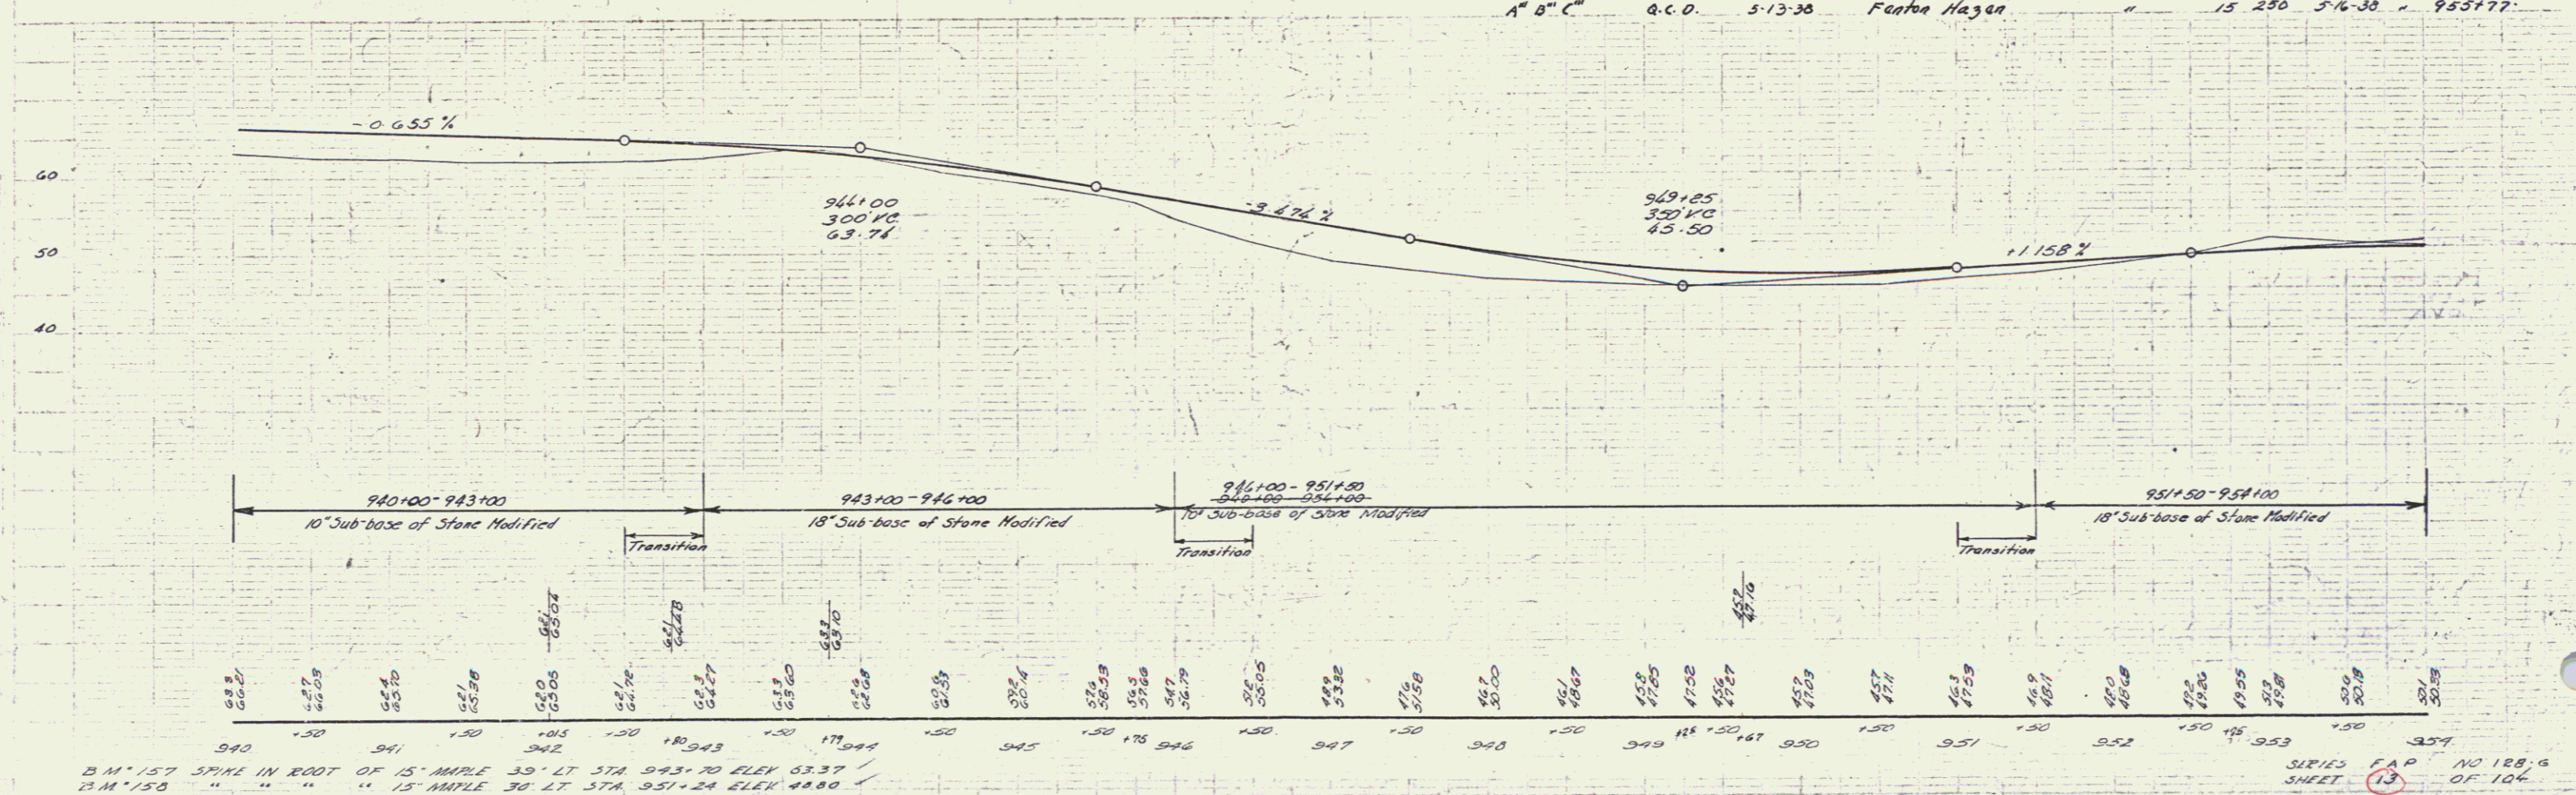

B.M. 157 SPINE IN ROOT OF 15' MAPLE 33' LT STA 943+70 ELEV 63.37  
 B.M. 156 " " " " 15' MAPLE 30' LT STA 951+24 ELEV 48.80

SERIES CAP NO 128,6  
 SHEET 13 OF 106  
 H. H. H.

S.M. LANE  
 F.J. DUNN  
 TRACED R.L. BUNNY

S.M. LANE  
 F.J. DUNN