


Control of section of old highway between Sta. 967+14 Rt. & Sta. 972+52 Rt. relinquished to Town of North Hero. Recorded Book 15, Page 302 of Land Records, Date July 19, 1939.


128-G 1939 12 106

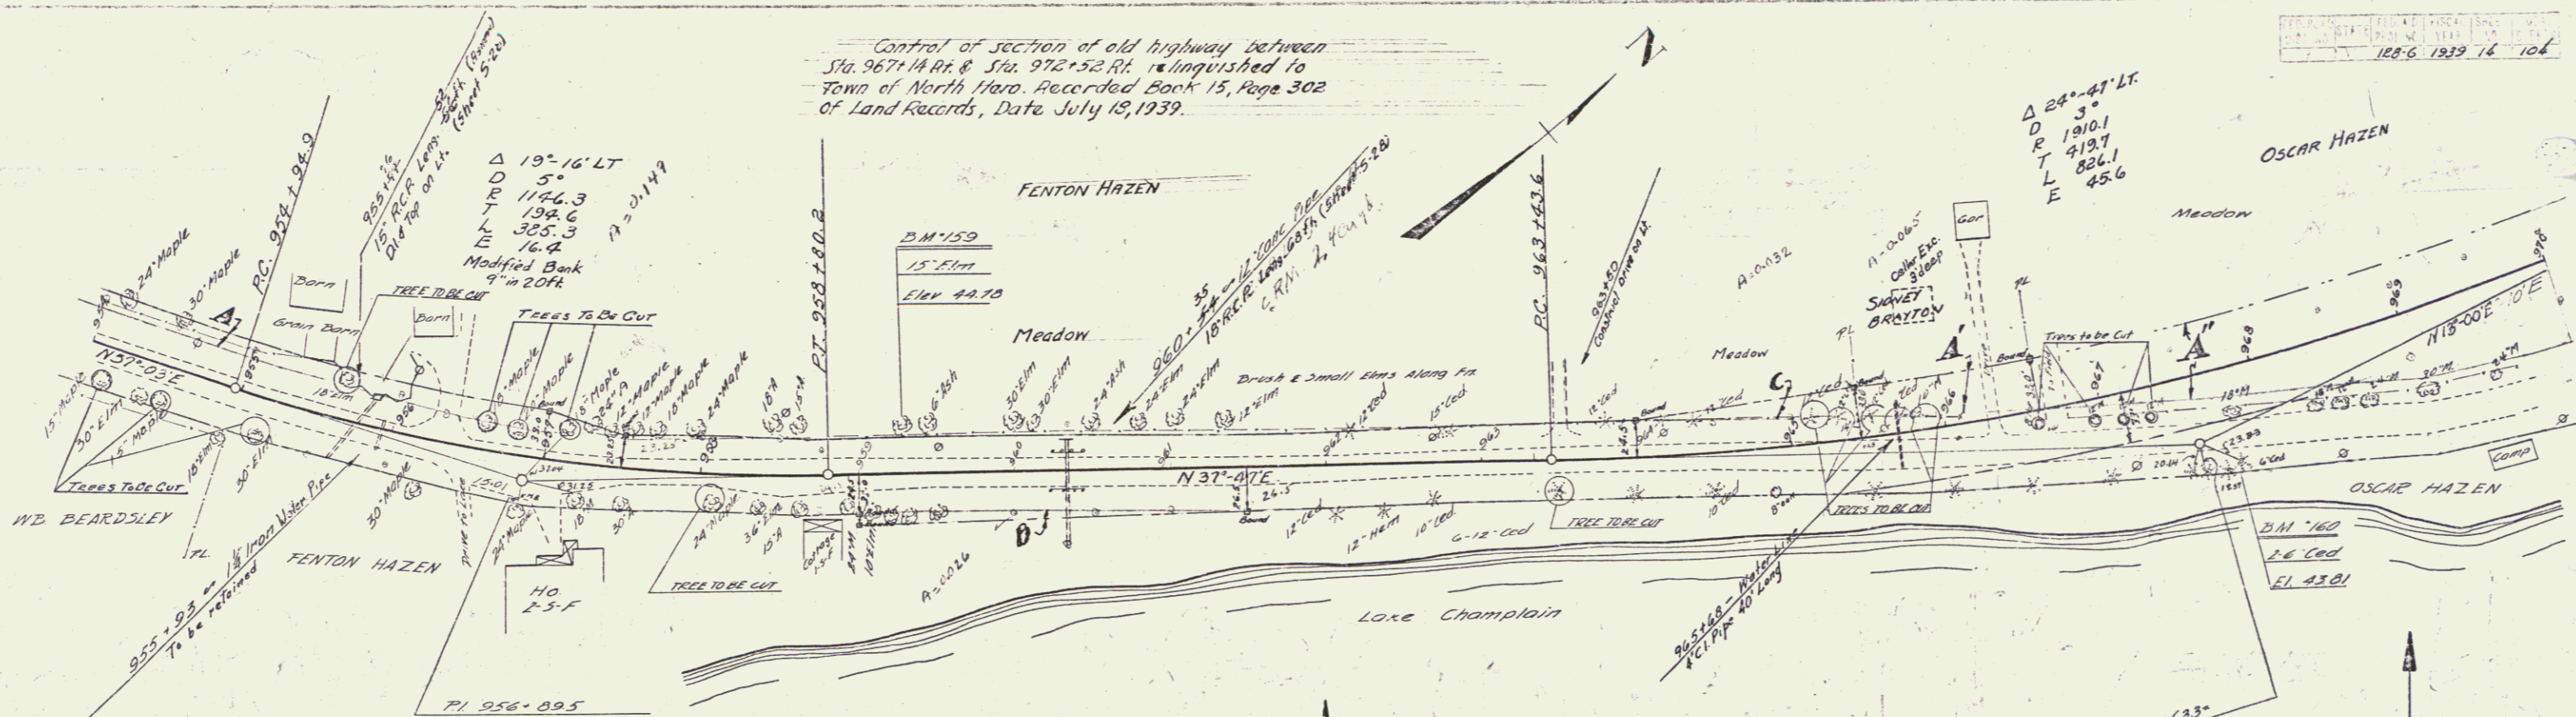

Parcel	Instrument	Date	Grantor	Grantee	Recorded	Remarks
A-B-C	O.C.A.	5-13-30	Fenton Hazen	Stop #1	15 230	5-18-38 Cal. 955+77
A	Condem.		Sidney Brayton	"	15 234	3-19-30
A-B-C	W.D.	7-21-39	Oscar Hazen	"	15 234	5-3-30 Cal. 977+30

Clearing & Trimming Roadsides (Item 100)
Stumps & dead trees to be removed & disposed of as ordered by the engineer to open views of lake.

STA 962+00 to 969+00 RT.

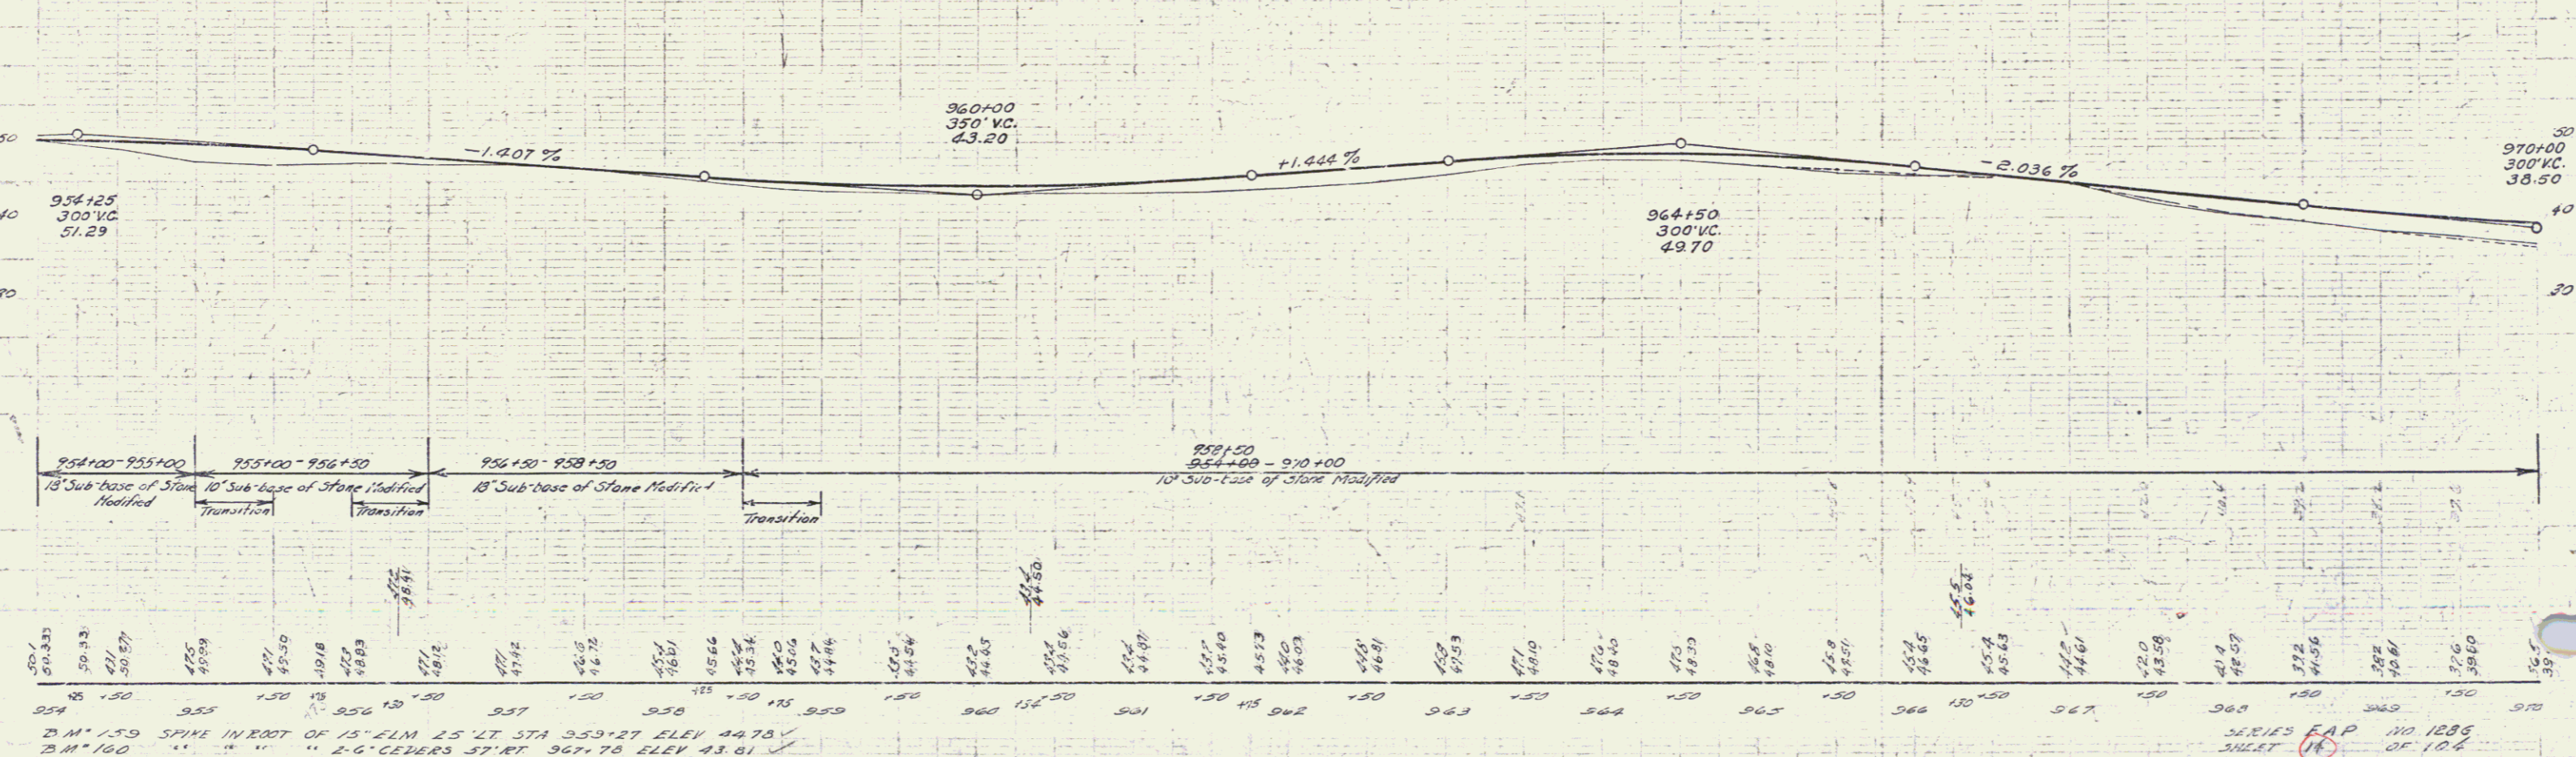

B.M. 159 SPINE IN ROOT OF 15' LIM 25' LT STA 959+27 ELEV 44.78
B.M. 160 " " " 2'-6" CEMERS 37' RT 967+78 ELEV 43.81

SERIES EAP 110 1289 SHEET 11 OF 106