



REVISIONS  
 BY ENGINEER  
 DATE  
 REASON

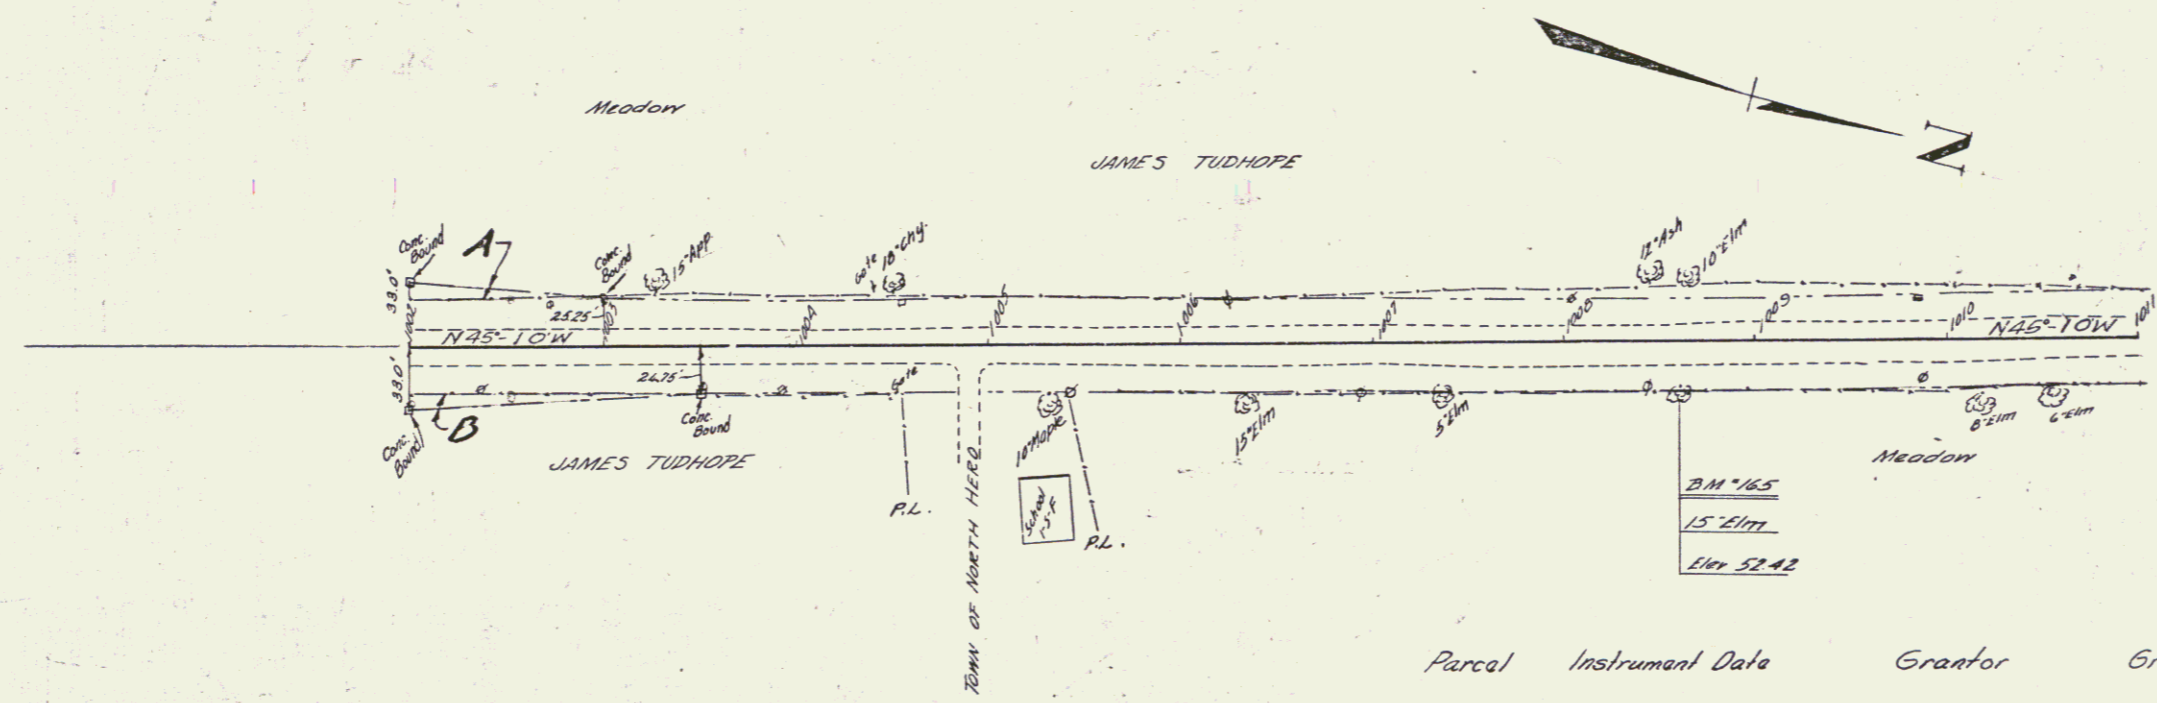

Parcel	Instrument Data	Grantor	Grantee	Recorded North Here Book Page Date	Remarks
ABCD	Adm. D. 4-27-38	James Tudhope et al.	Sheff M.	15 237 5-3-38	

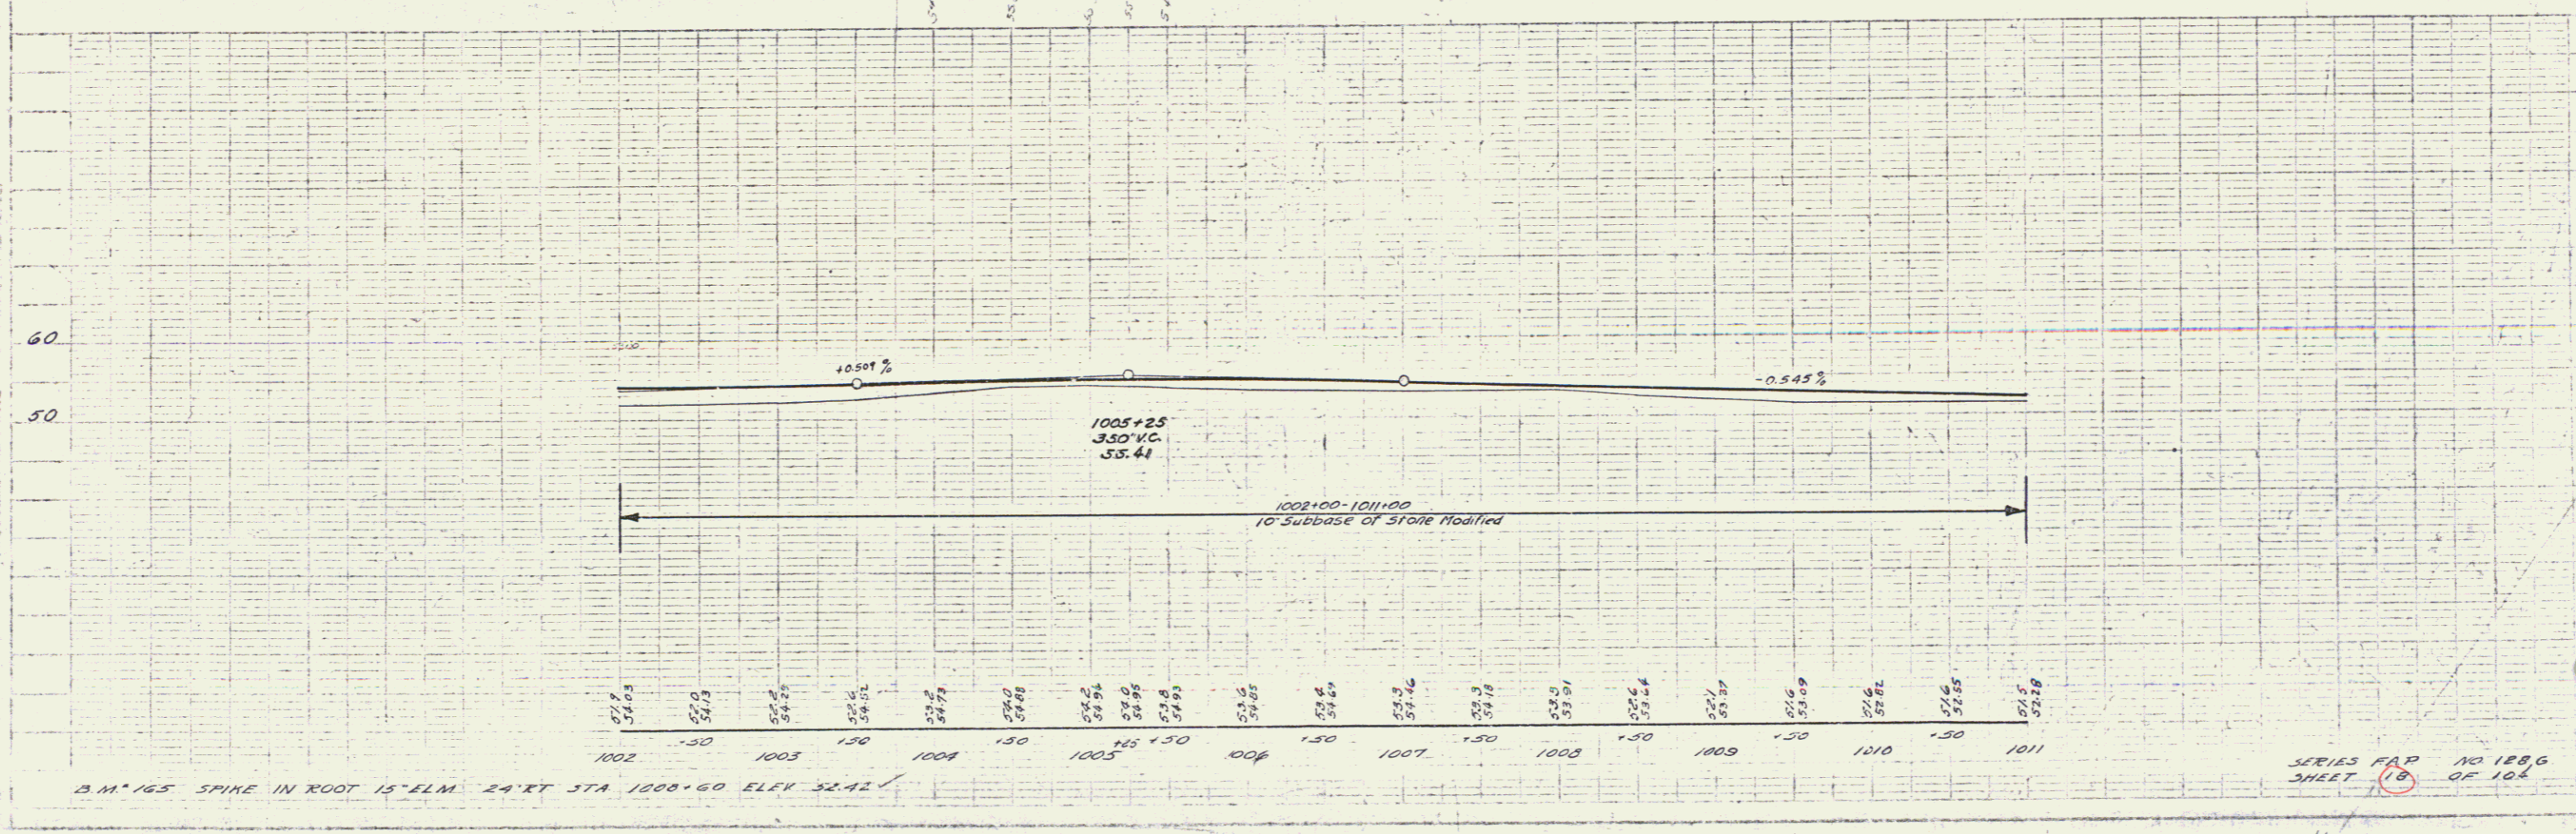

B.M. 165 SPIKE IN ROOT 15' ELM. 24' RT STA 1008.60 ELEV 52.42

SERIES MAP NO 1286  
 SHEET 19 OF 104

N. HERRING