


PARCEL	INSTRUMENT	DATE	GRANTOR	GRANTEE	RECORDED	REMARKS
A&C	M.D.	4-21-30	Oscar Hazen	St. of W.	15 234	5-3-30 Cal. 777150
A'	G.C.D.	4-22-30	Walter E. Hutchins	"	15 230	4-27-30 "
A&C'	G.C.D.	4-22-30	Walter E. Hutchins	"	15 236	5-4-30 " 1076100

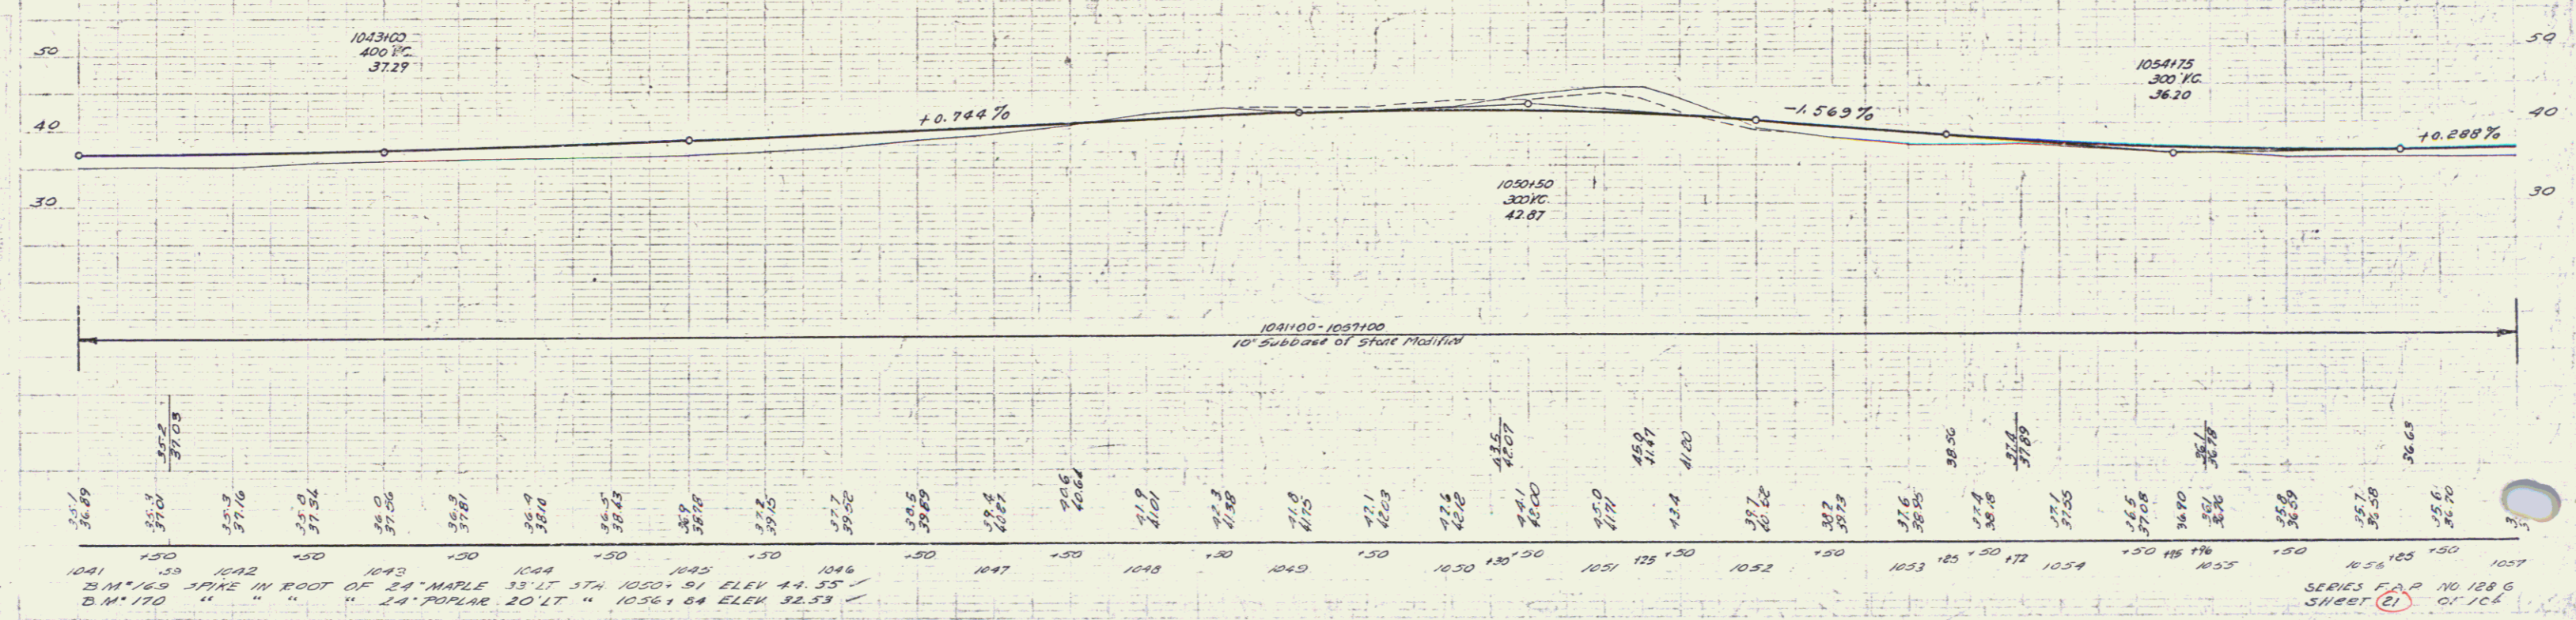

1041 1042 1043 1044 1045 1046 1047 1048 1049 1050 1051 1052 1053 1054 1055 1056 1057

21 M. 169 STAKE IN ROOT OF 24" MAPLE 33' LT STA 1050.91 ELEV 44.35 /
 21 M. 170 " " " " 24" POPLAR 20' LT " 1056.84 ELEV 32.53 /

SERIES F.P. 10 128 G
 SHEET 21 OF 102