


GUARD RAIL REQUIRED
 ON LEFT
 Sta 15+00 to 22+44 Length 744ft.
 " 23+20 - 30+00 " 80 "
 TOTAL THIS SHEET 824ft.

CONCRETE RIP-RAP
 ON RIGHT
 Sta 15+00 to 30+00 Length 1500ft.

JOB NO.	STATE	FILE NO.	DATE	SHEET NO.	TOTAL SHEETS
9	V.T.			4	10

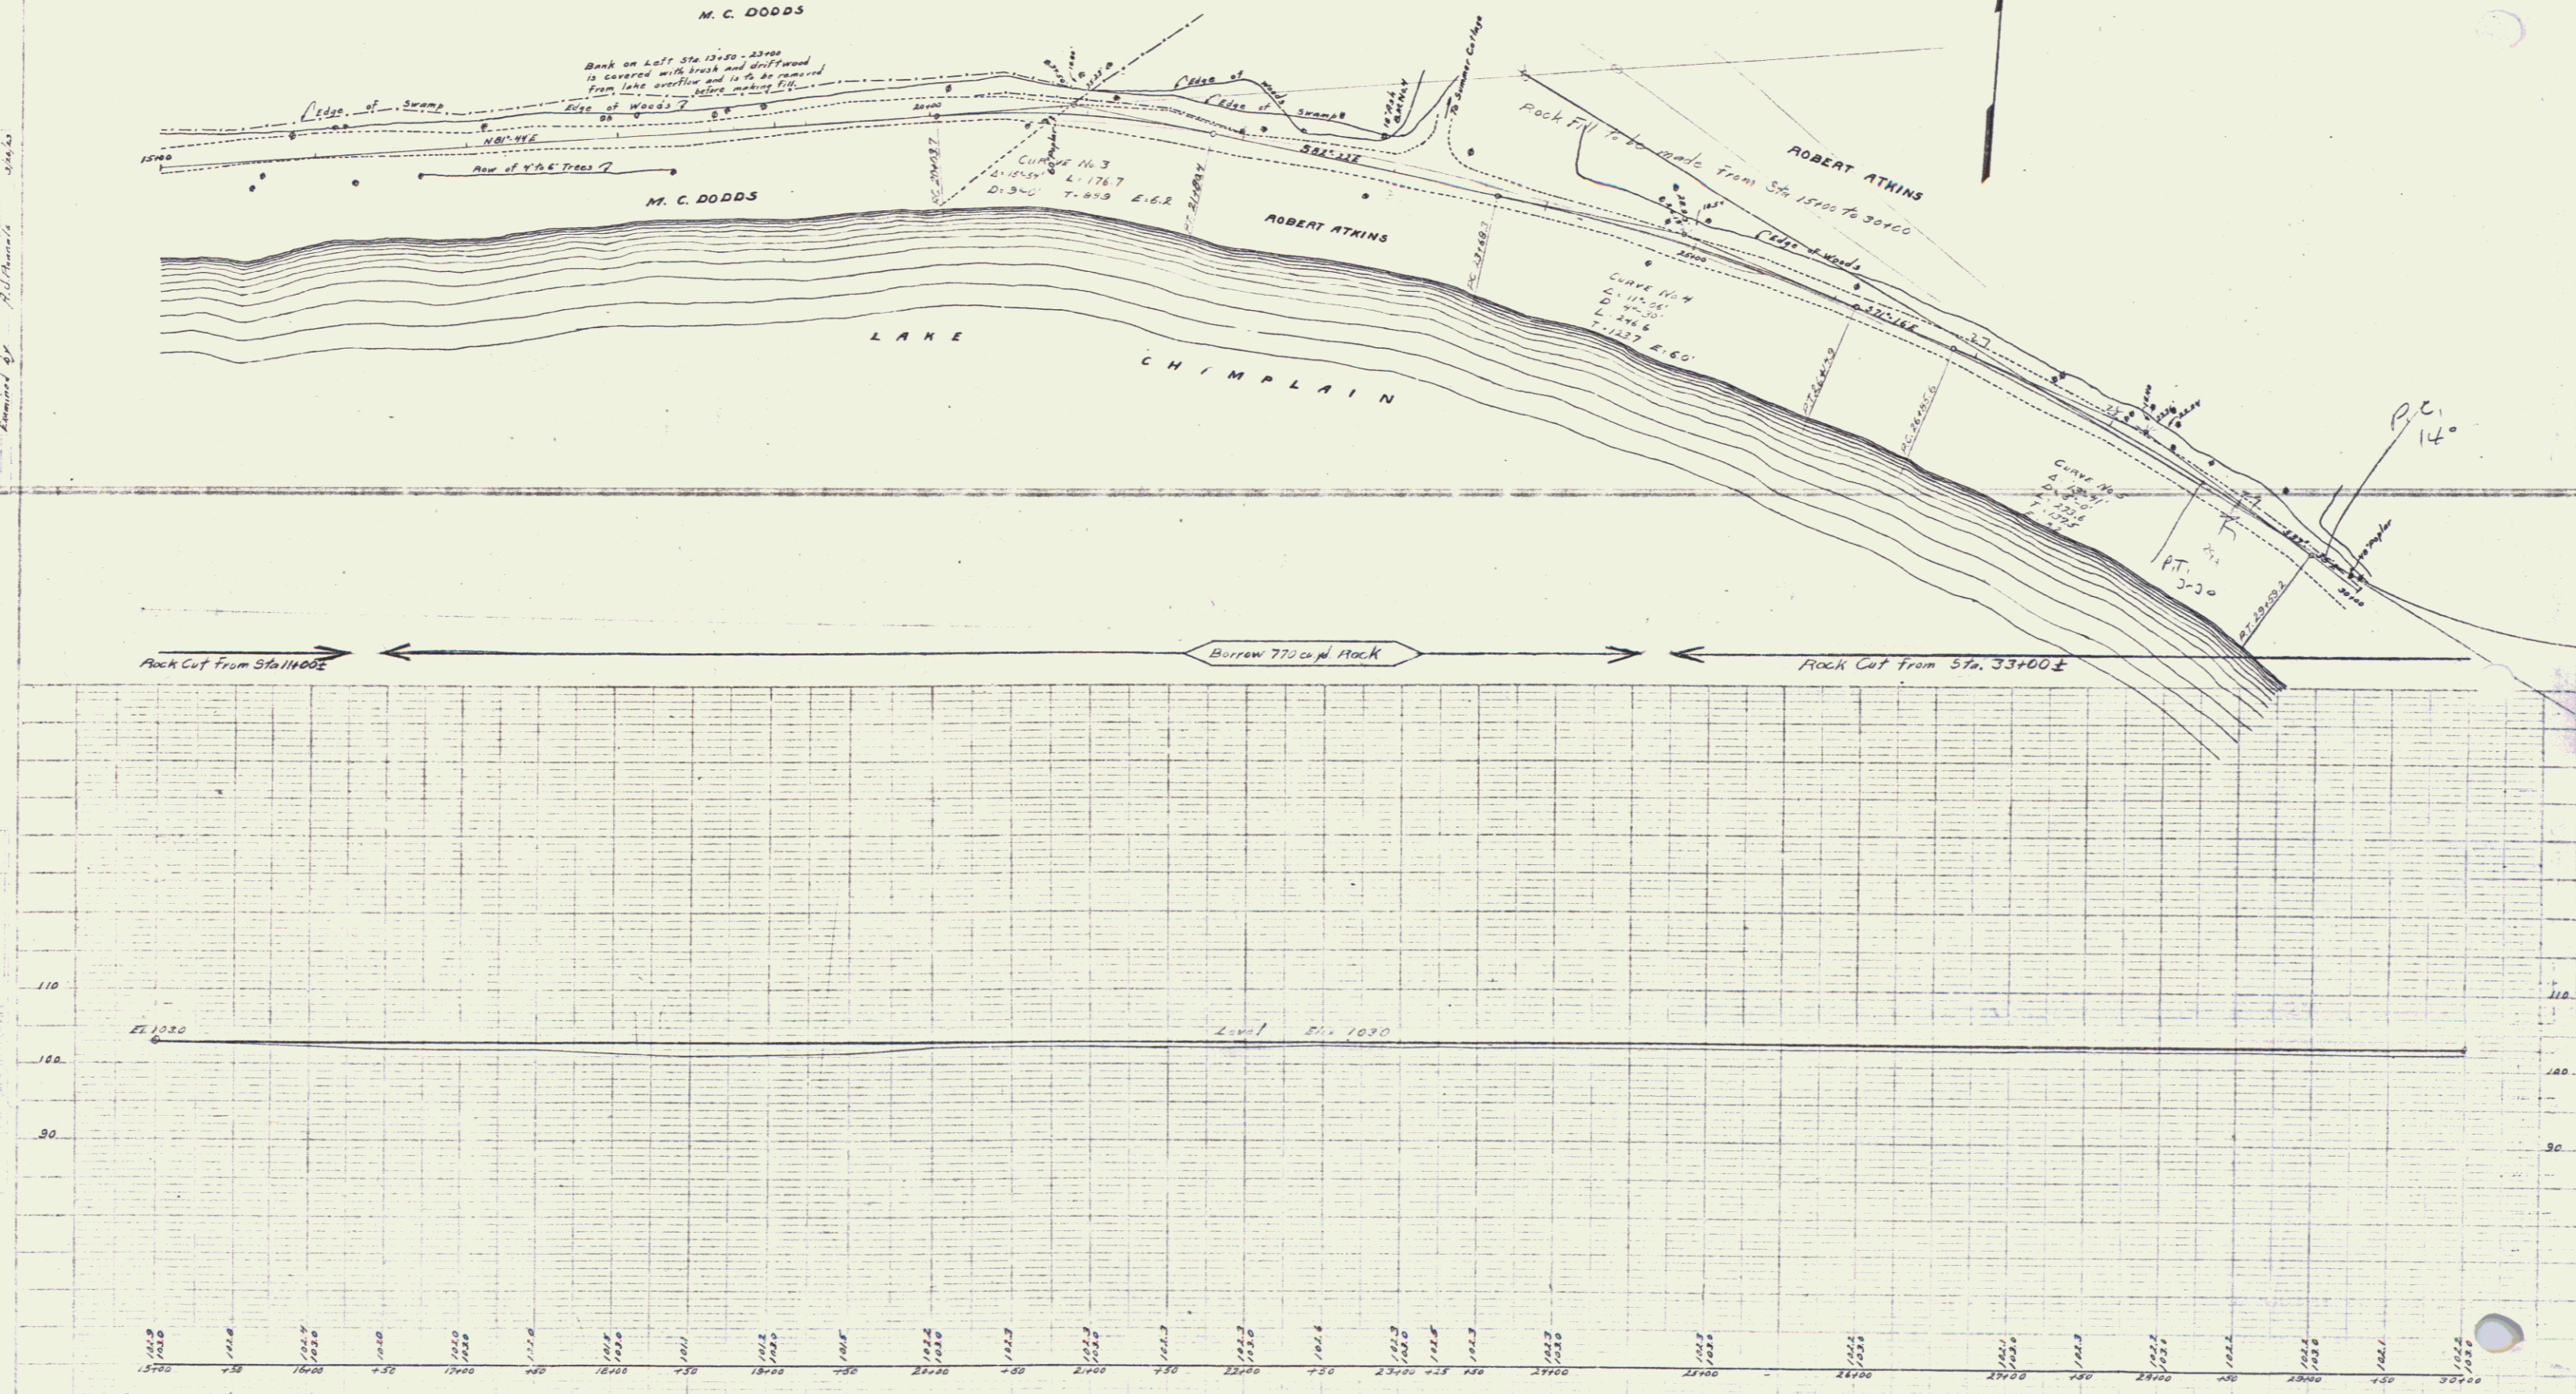

M. C. DODDS
 ROBERT ATKINS
 LAKE CHIMPLAIN

M. C. DODDS
 ROBERT ATKINS
 LAKE CHIMPLAIN

Sheet 4 of 10
 Series No. 1710