
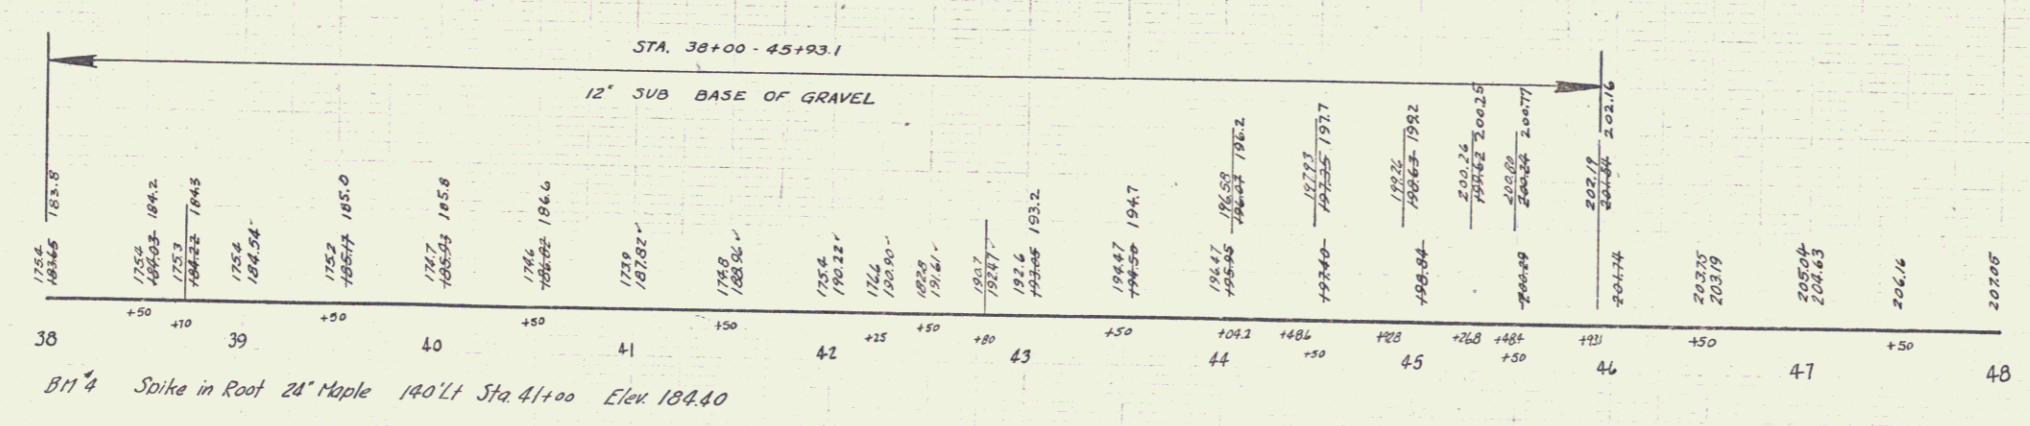


SPECIAL PROVISION
 The contractor will not be permitted to remove the present concrete pavement until after traffic has been diverted to the projects in their new relocation through their entire lengths.

Δ	19' 47" Rt
O	8"
T	1432.7
L	249.8
E	494.6
	21.3

PARCEL	INSTRUMENT	DATE	GRANTOR	GRANTEE	RECORDED	REMARKS
A	Q.C.D.	9-7-37	B.F. GOODRICH	ST. OF VT.	RICHMOND	DITCH LI. 30+50

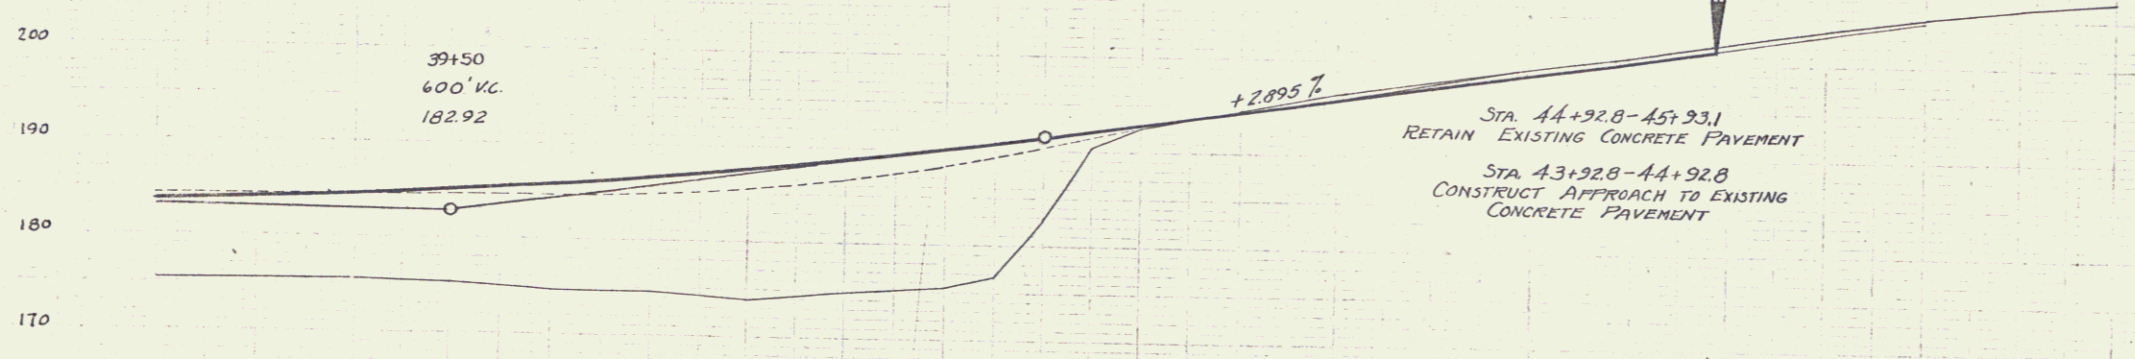

B11 4 Spike in Roof 28' Maple 140' Lt Sta 41+00 Elev 184.80