

**INDEX OF SHEETS**

SHEET NO. 1 TITLE PAGE

- 2 TYPICAL CROSS-SECTION OF IMPROVEMENT

- 3 PLAN AND PROFILE STA. 0+00 TO STA. 8+67

- 4 OF REINFORCED BOX CULVERT STA. 6+88

- 5, 6 CROSS SECTIONS


FED. ROAD DIST. NO.	STATE	FED. AID PROJ. NO.	YEAR	SHEET NO.	TOTAL SHEETS
9	Vt.	43		1	6

STATE OF VERMONT  
STATE HIGHWAY DEPARTMENT


PLAN AND PROFILE OF PROPOSED  
STATE HIGHWAY  
FEDERAL AID PROJECT

**TOWN OF RICHMOND**  
WINOOSKI RIVER ROAD  
FROM 700 FT WESTERLY OF  
S. THOMPSON'S HOUSE TO  
CHECKERED HOUSE OVERPASS

Pin # 99K077  
Project F 43/103A  
F 43 MP 0.756-0.920  
F 103A MP 1.044-5.744

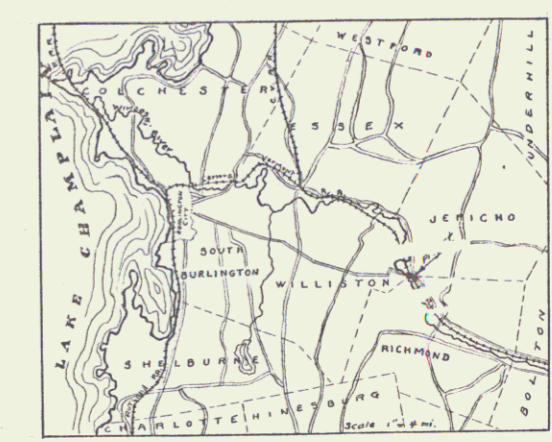

SCALES { PLAN - 1 IN = 50 FT  
PROFILE - 1 IN = 50 FT  
CROSS SECTIONS - 1 IN = 5 FT

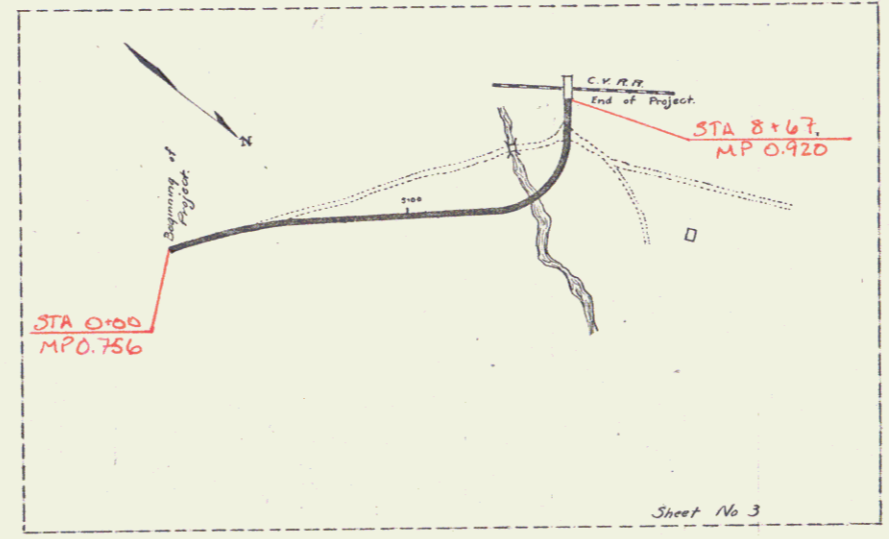

LAYOUT  
SCALE 1 IN = 200 FT

CONVENTIONAL SIGNS

COUNTY LINE	=====	GROUND ELEVATION	DATUM	LINE
TOWN LINE	-----	GRADE ELEVATION	DATUM	LINE
FENCE LINE	-----			
STONE WALL	-----			
UNFENCED PROPERTY	-----			
GUARD RAIL	-----			
TRAVELED WAY	-----			
RAILROAD	-----			
RETAINING WALL	-----			
CENTER LINE	-----			
SURVEY LINE	-----			
CULVERT	-----			
DROP INLET	-----			
TROLLEY POLE	-----			
POWER POLE	-----			
TELEPHONE POLE	-----			
TREES	-----			
HEDGE	-----			

CURVE DATA	
DEFLECTION ANGLE	Δ
DEGREE OF CURVE	D.
RADIUS OF CURVE	R.
TANGENT DISTANCE	T.
LENGTH OF CURVE	L.
EXTERNAL DISTANCE	E.
POINT OF INTERSECTION P.I.	P.I.
POINT OF CURVE	P.C.
POINT OF TANGENT	P.T.

RIGHT-OF-WAY DIVISION  
TOWN FILE  
PERPETUAL

Plc  
Town of US  
(To Be Returned To R.O.W. Division)

SUBMITTED BY ORDER OF THE STATE HIGHWAY BOARD  
[Signature]  
CHIEF ENGINEER  
DEPARTMENT OF HIGHWAYS

RECOMMENDED [Signature]  
DISTRICT ENGINEER  
BUREAU OF PUBLIC ROADS  
RECOMMENDED FOR APPROVAL [Signature]  
CHIEF ENGINEER  
BUREAU OF PUBLIC ROADS  
APPROVED [Signature]  
DIRECTOR - BUREAU OF PUBLIC ROADS

06/01/23

SERIES F No. 43 FILED  
SHEET 1 OF 6

DIST. # 5 PLANS