
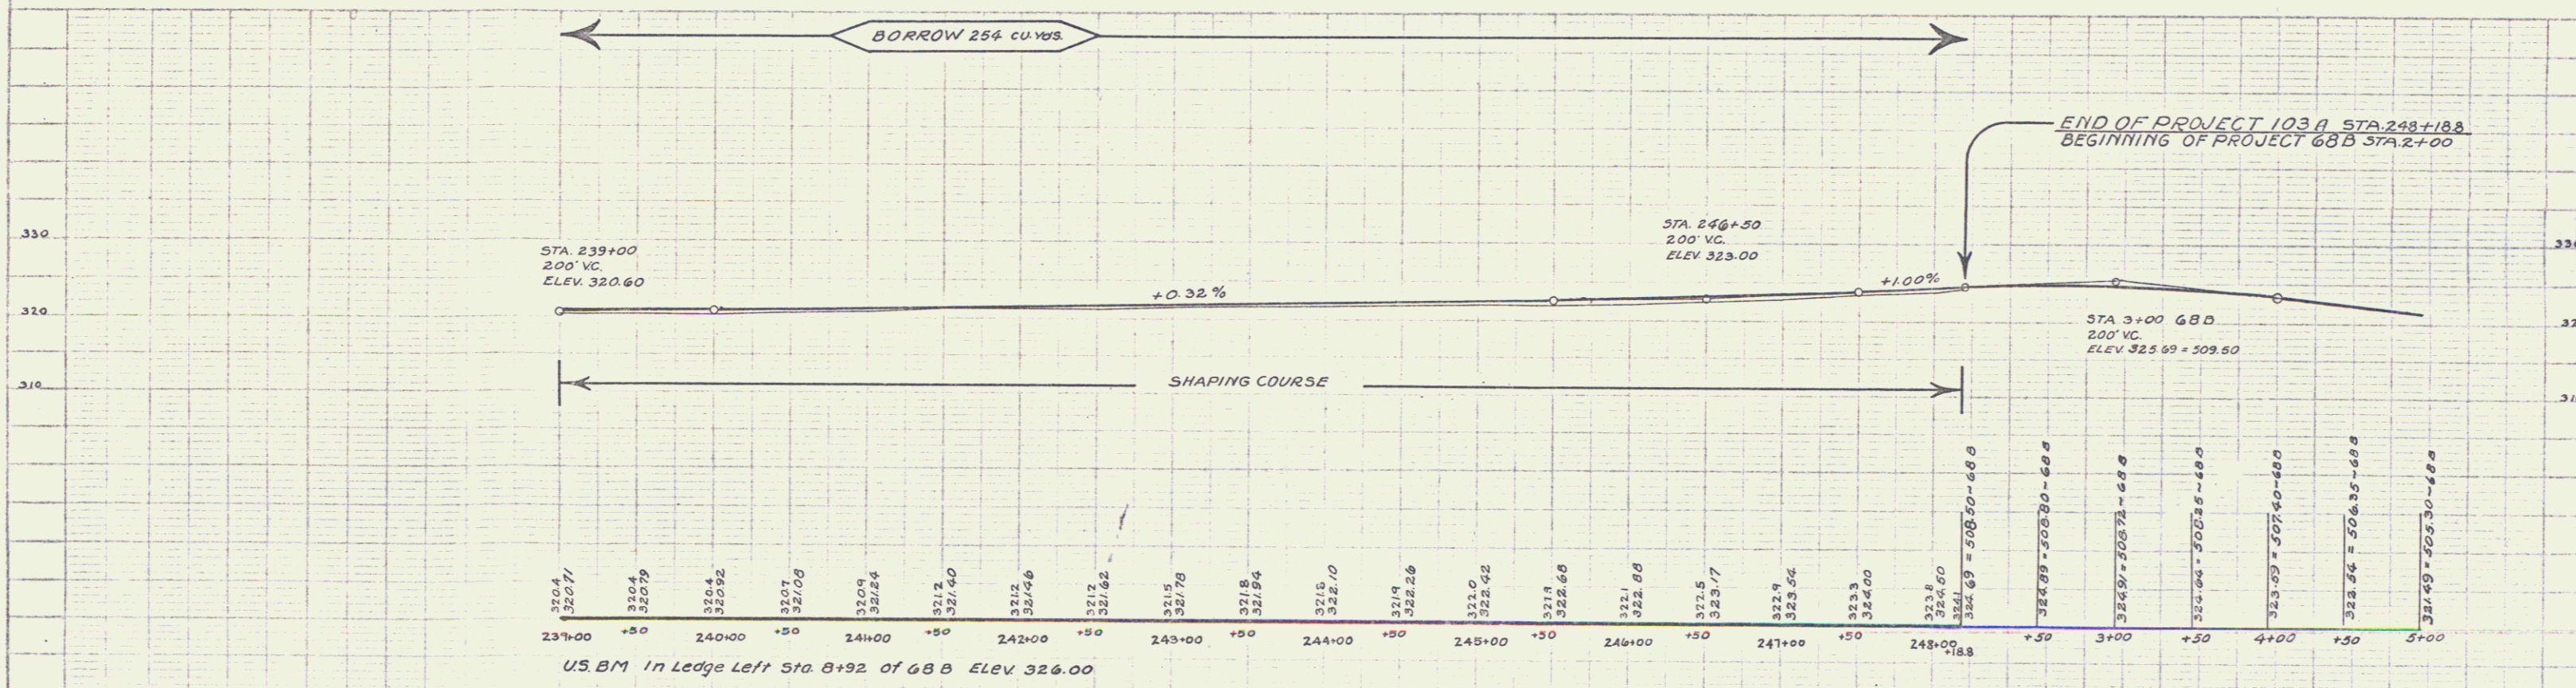


FED. ROAD DIST. NO.	STATE	FED. AID PROJ. NO.	FISCAL YEAR	SHEET NO.	TOTAL SHEETS
7	VA	203-A	1920	19	73

FILED
 DATE
 PROJECT NO.
 SHEET NO.
 DRAWN BY
 CHECKED BY
 APPROVED BY

A.A.D.C.
 J.A. Williams
 3/1/28

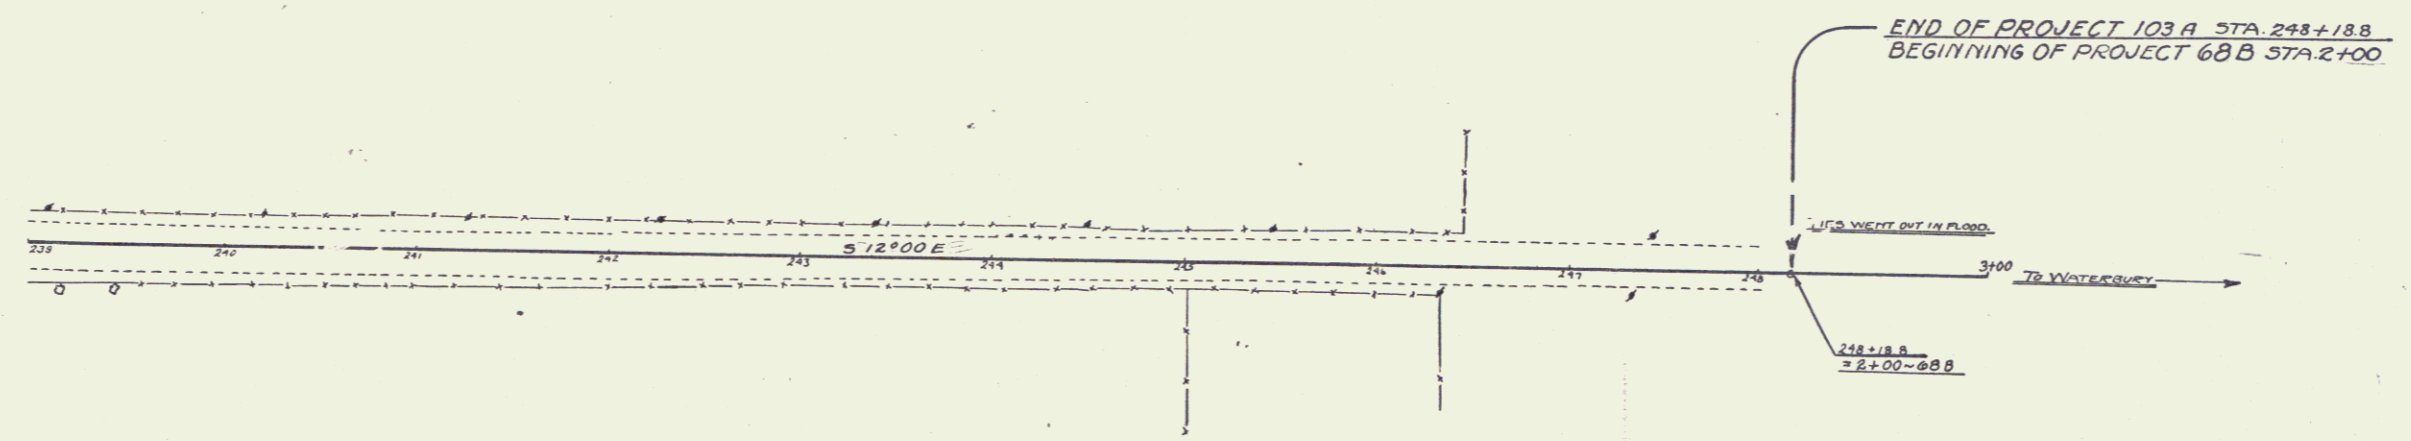

SERIES F No. 103 A
SHEET NO. 19 OF 73