
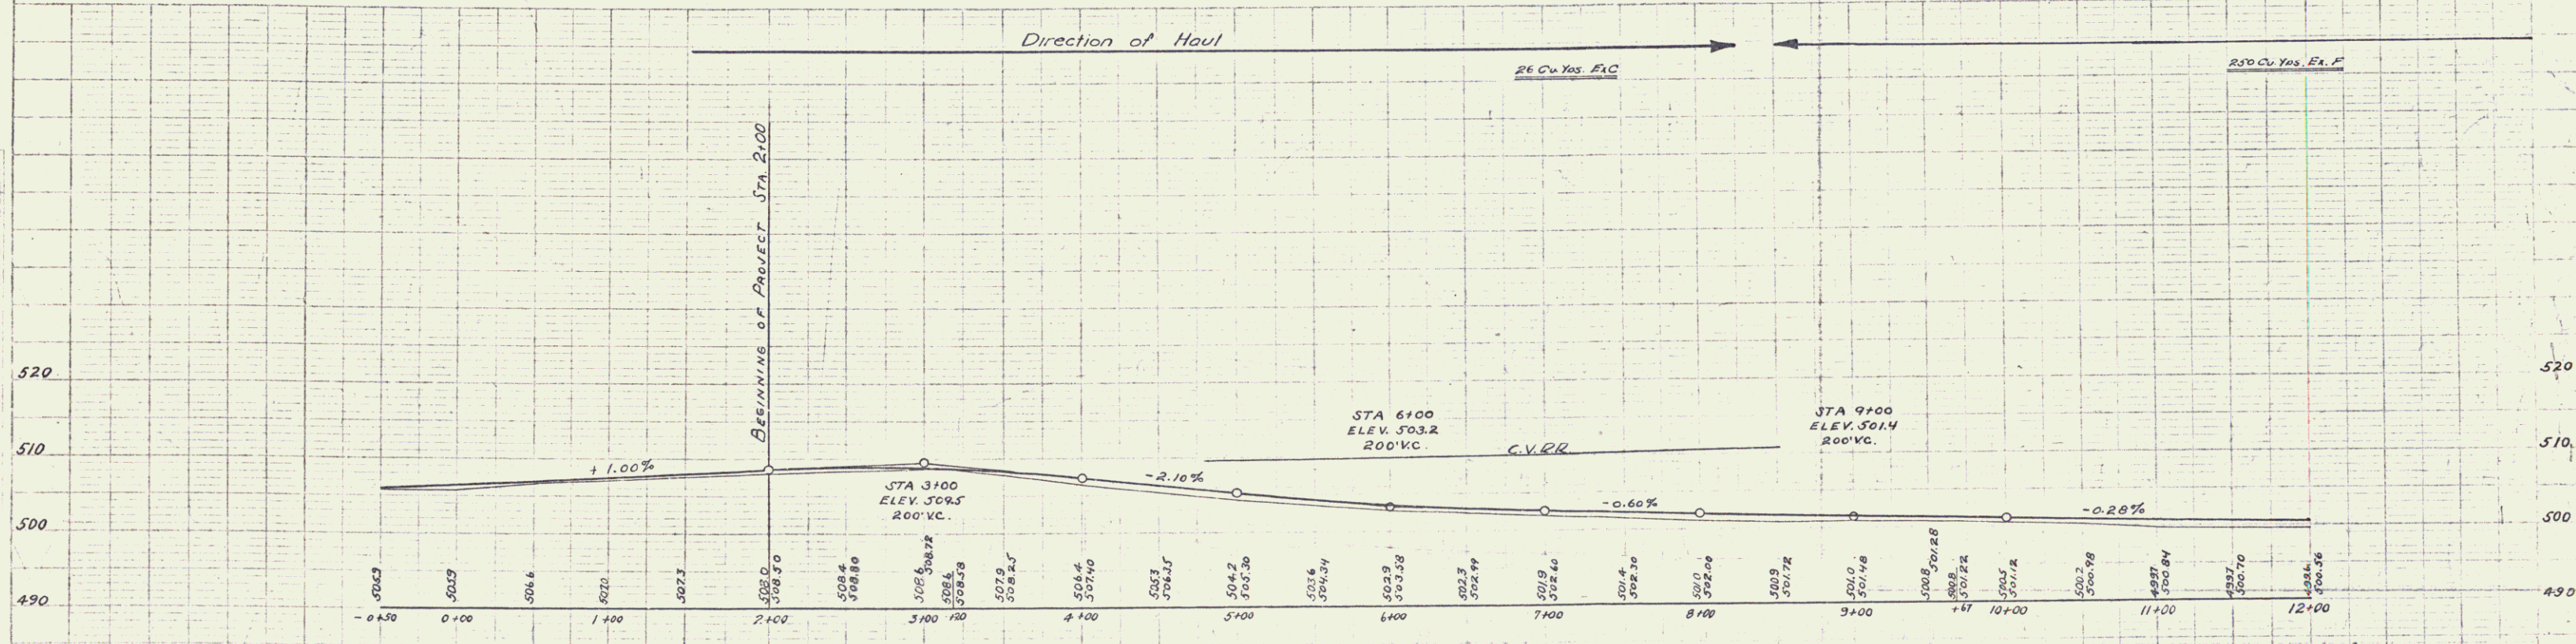


FED. ROAD DIST. NO.	STATE	FED. AID PROJ. NO.	FISCAL YEAR	SHEET NO.	TOTAL SHEETS
9	VT.	683	1947	3	98

PLAN  
 DRAWN BY W.M. GALLAGHER  
 CHECKED BY W.D. McILLIPIPER  
 DATE 1-5-27

PROFILES  
 DRAWN BY W.D. McILLIPIPER  
 CHECKED BY W.M. GALLAGHER  
 DATE 1-5-27

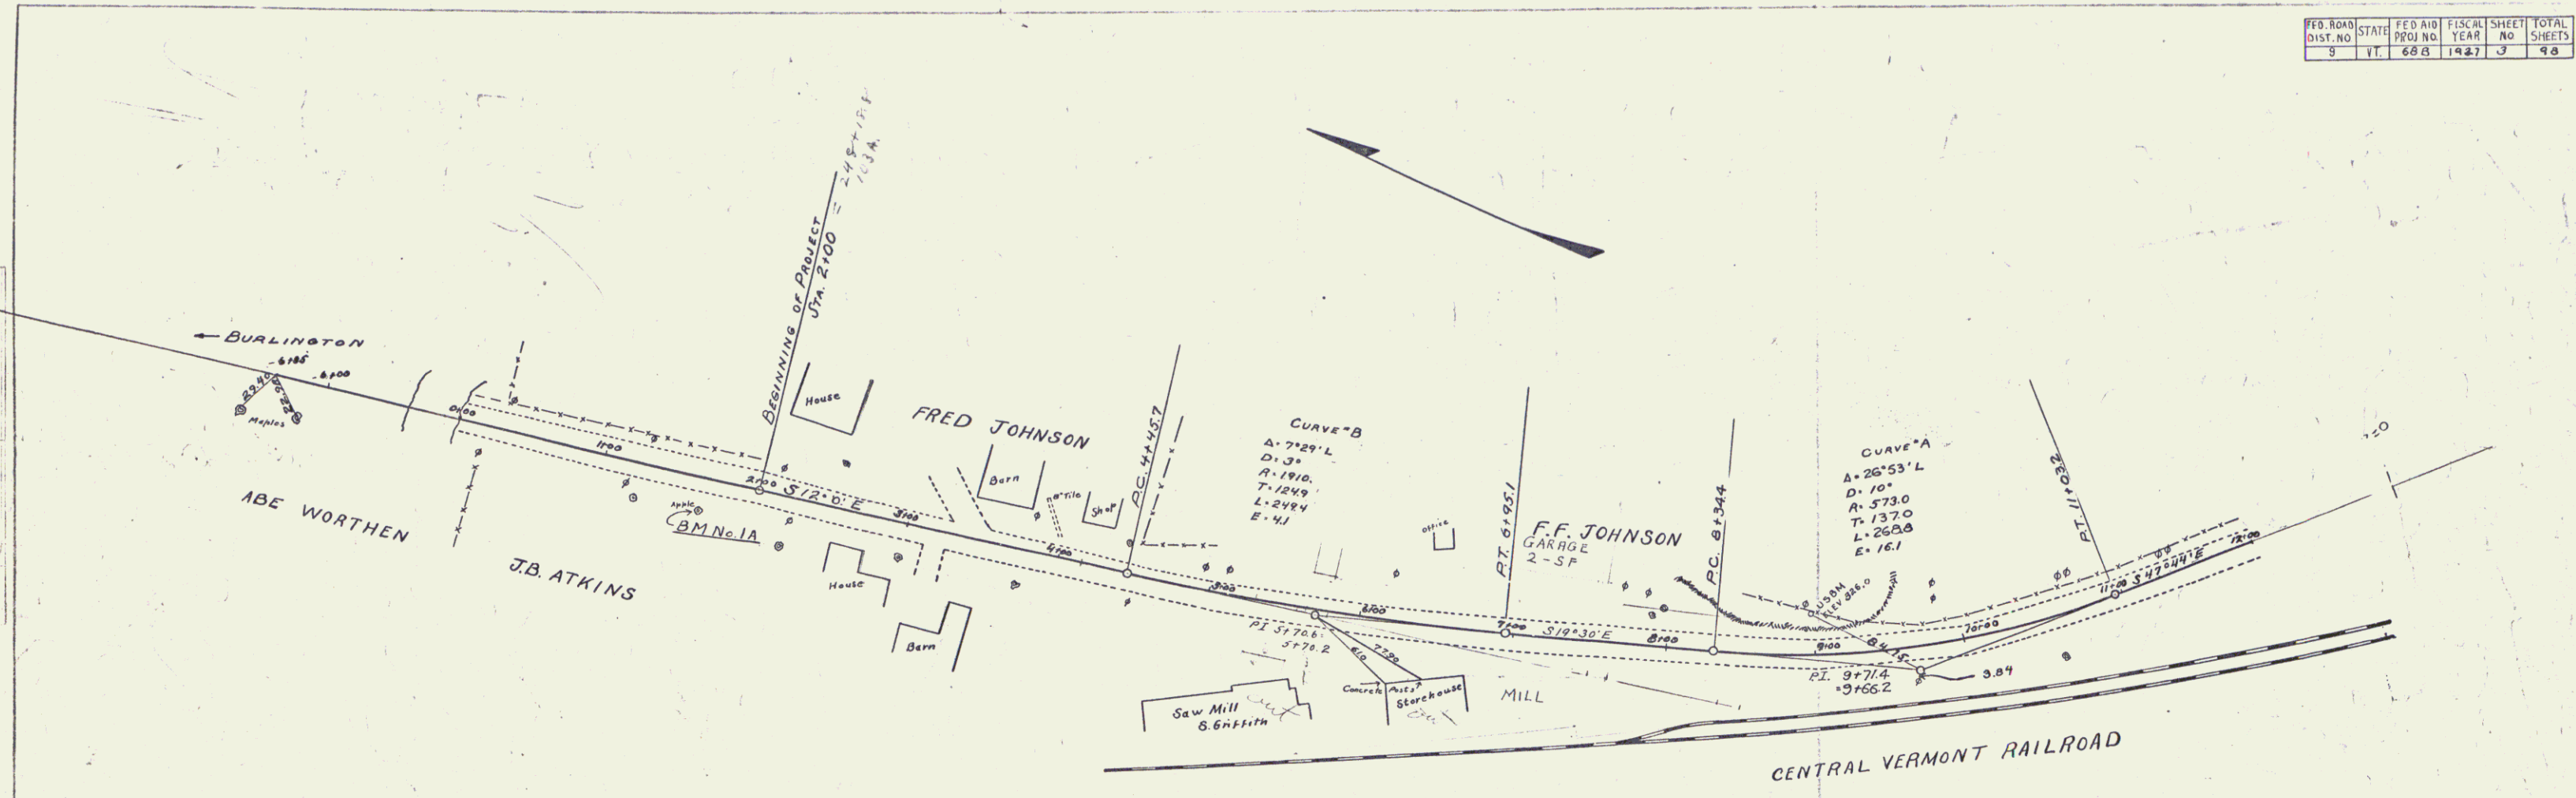

BM "1A" Spike in base of apple tree Right Sta. 1+65 Elev 509.19  
 U.S.B.M. In ledge Left Sta. 8+92 Elev 326 - Elev 509.81 of FAP 95 A

Series F No 683  
 Sheet 3 of 98